IREDELL COUNTY HEALTH DEPARTMENT

Statesville Office ~~(704) 878-5305~~ RA Mooresville Office (704) 660-3625 PERMIT # 21886l

IMPROVEMENT PERMIT / AUTHORIZATION TO CONSTRUCT / OPERATION PERMIT / EXISTING SYSTEM

PIN # 4624236634

APPLICANT: Rollans Soil/Pinnacle Building APPLICANT ADDRESS: 128-B Promenade Dr. Mooresville, NC 28117

SITE ADDRESS: 2585 Brawley School Rd Mooresville, NC PHONE: 704 746-5046 ALT. PHONE: 704 799-8641

SITE DIRECTIONS: Brawley School Rd past traffic circle near end on left

SUBDIVISION: L&J SECTION: 6 LOT # 4616 LOT AREA: .87Ac DESIGN FLOW: 480gpd L.T.A.R.: .3

Existing

Septic Tank	1000 (gal)	STB		Date		☐ New System ☐ Repair ☐ Expansion	System Type: I II III IV V VI	☒ Residence	No. Bedrooms 4
Pump Tank	1000 (gal)	PT		Date		System Description: Exist Pump to 25% Reduction		☐ Business	No. Persons 8
Pump Make		Model		Serial #		Repair System Description: Exempt - Recorded prior to 1983		☒ Other Kitch Outdoor	No. Employees
# Nitrification Fields	1	# Lines	3	Linear Ft:	400'	Maintenance Agreement Required:	☐ YES ☒ NO	☒ Slab Kitchen	☐ Crawl Space
Trench Width	36"	Max. Trench Bottom Depth	36"	Gravel Depth	N/A	☐ GRAVITY	☒ PRESSURE	☒ Basement w/plumbing (House)	☐ Basement w/o plumbing

Water Supply: ☒ Private ☐ Public ☐ Community

Comments / Conditions: The proposed Outdoor Kitchen does not impact existing Septic. Must maintain at least 5ft setback.

INITIAL SITE SKETCH

See attached/approved plan by Rollans Soil & Environmental Services, PA (dated 5/14/16)

AS BUILT SKETCH

Permit can be suspended or revoked if any false information is supplied toward securing the permit / any unauthorized changes are made to the site / any unauthorized changes are made in the installation of the system. **CONTACT A LOCATOR SERVICE PRIOR TO ANY EXCAVATION**

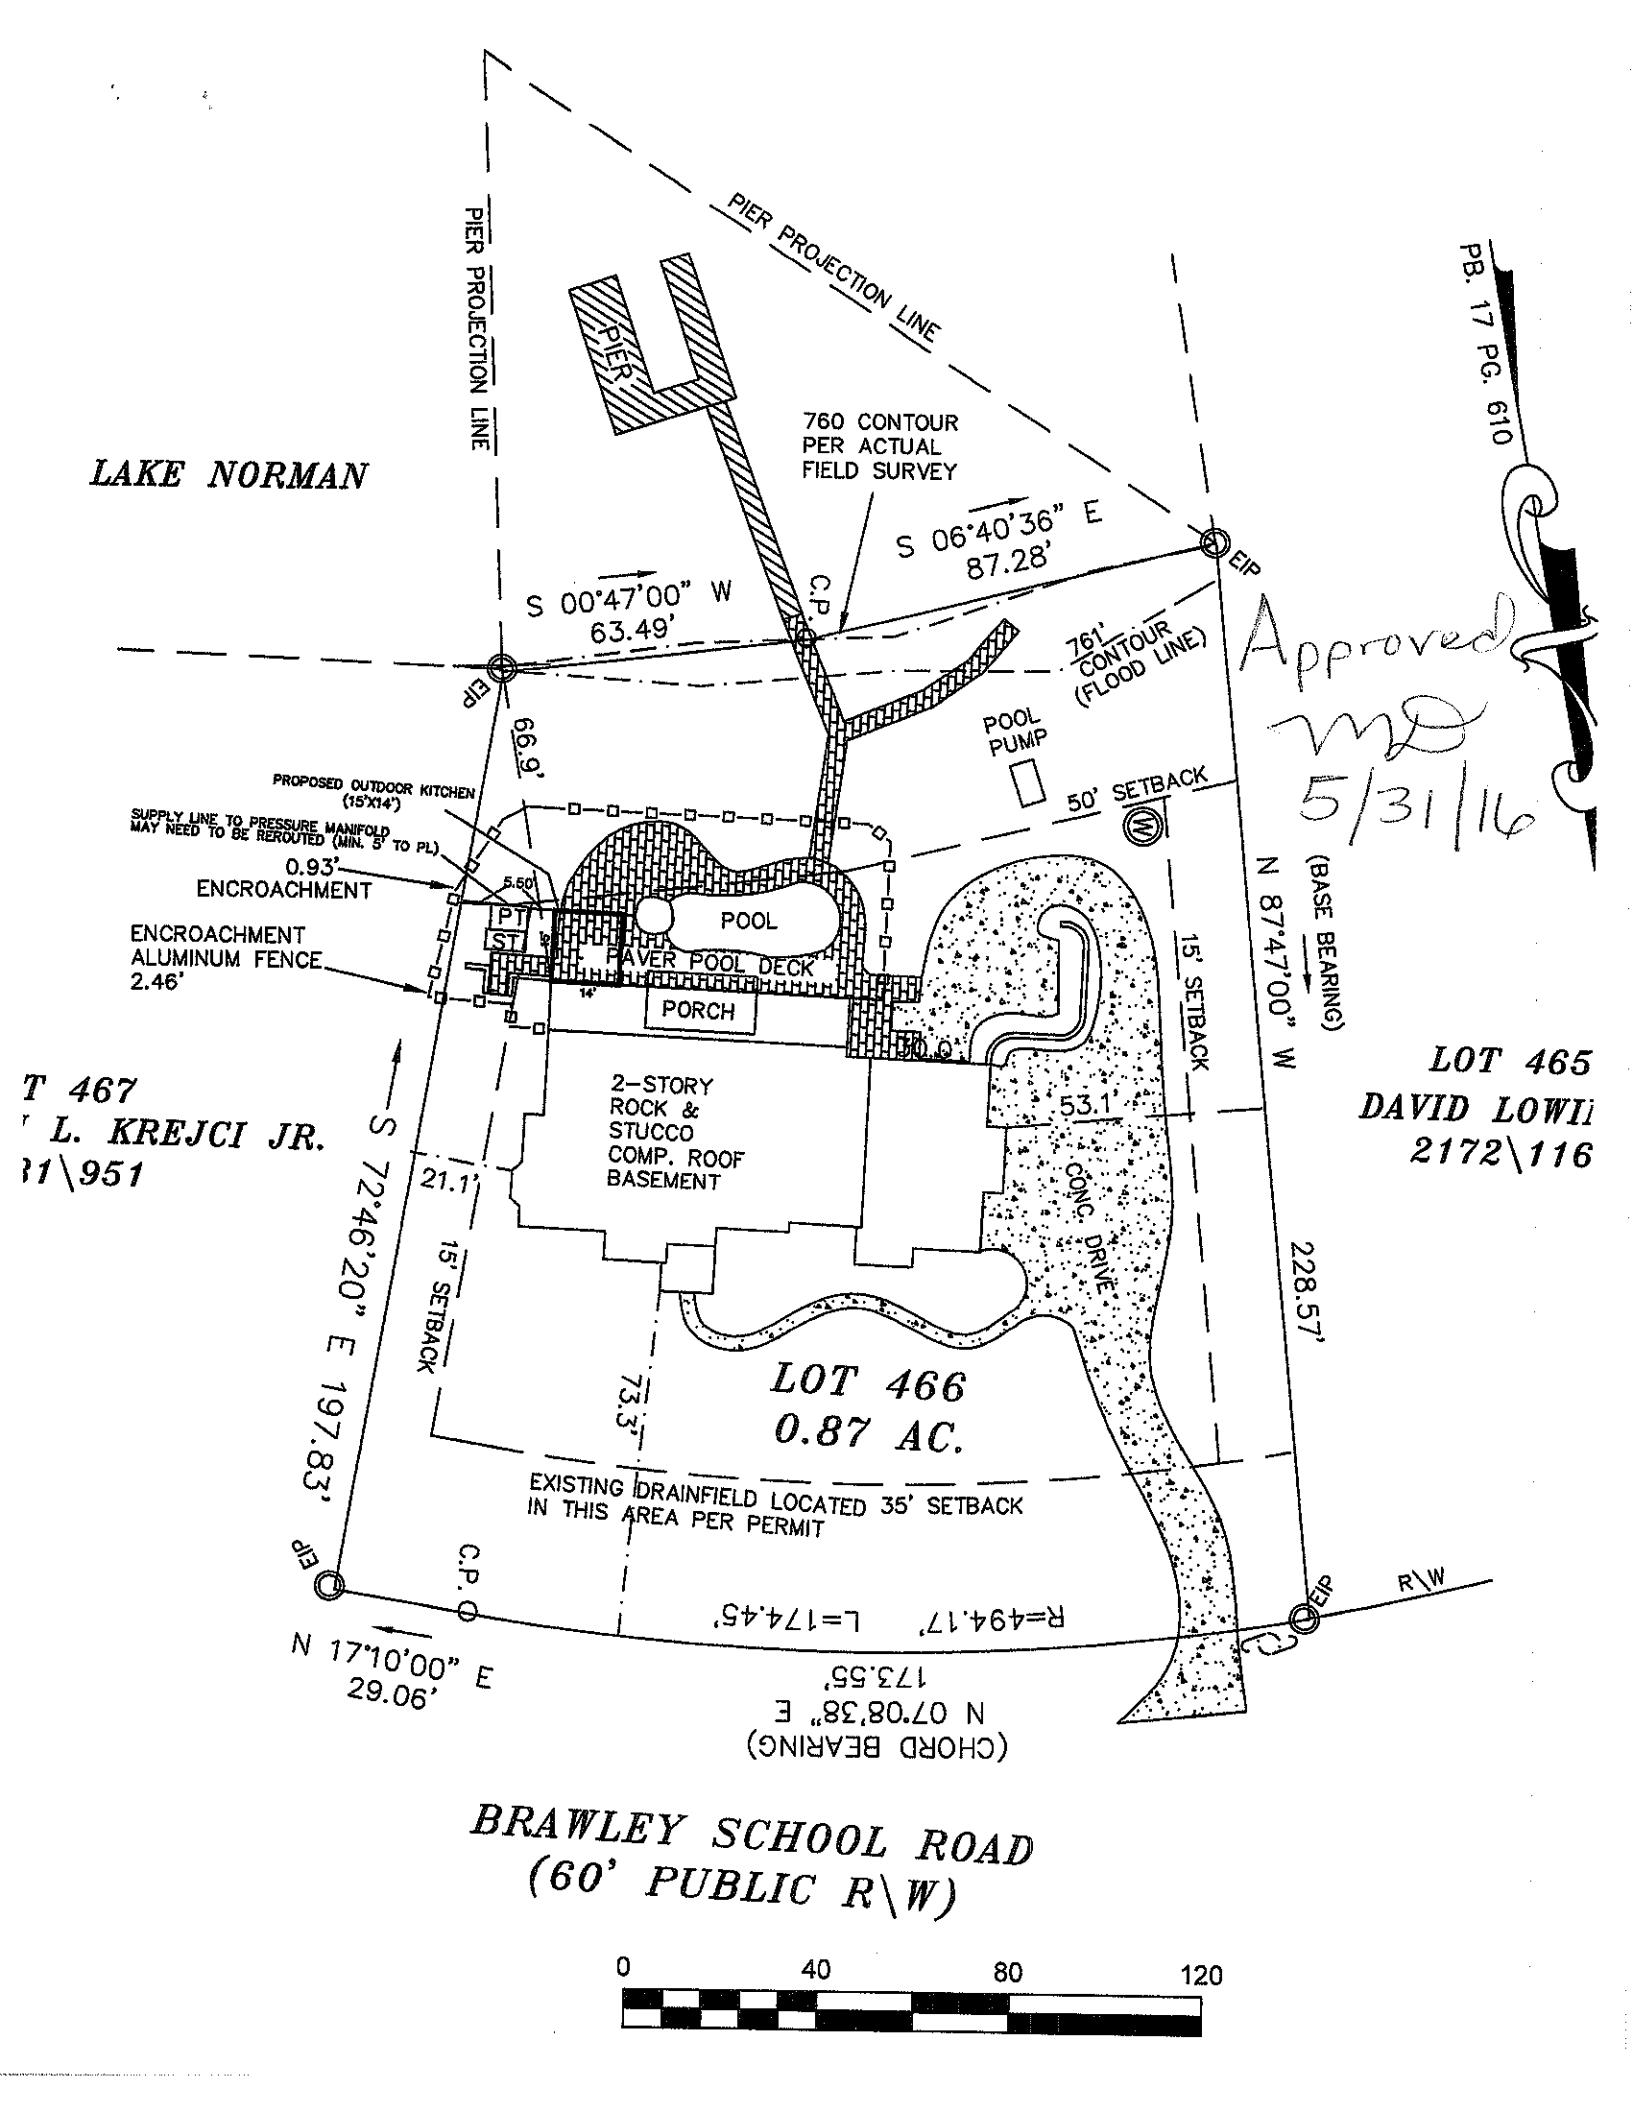
☐ **IMPROVEMENT PERMIT** *with plat valid without expiration.* ☐ **IMPROVEMENT PERMIT** *with site plan valid for 60 mos.* ☐ **AUTHORIZATION TO CONSTRUCT** *valid for period equal to IMPROVEMENT PERMIT--not to exceed 60 mo.*

Owner / Applicant Signature: [signature] Date: 6/2/16 Installed by: _____

IMPROVEMENT PERMIT by: _____ Date: _____ OPERATION PERMIT by: _____ Date: _____

AUTHORIZATION TO CONSTRUCT by: _____ Date: _____ Existing System Inspected by: Maina Dotson RS Date: 5/31/16

Health Dept. Copy - WHITE Applicant (Final Approval) - YELLOW Applicant (Conditional Approval) - PINK


LAKE NORMAN
PIER PROJECTION LINE
PIER
PIER PROJECTION LINE
760 CONTOUR
PER ACTUAL
FIELD SURVEY
S 06°40'36" E
87.28'
EIP
S 00°47'00" W
63.49'
C.P.
EIP
761' CONTOUR (FLOOD LINE)
POOL PUMP
66.9'
PROPOSED OUTDOOR KITCHEN (15'X14')
SUPPLY LINE TO PRESSURE MANIFOLD MAY NEED TO BE REROUTED (MIN. 5' TO PL)
0.93' ENCROACHMENT
ENCROACHMENT ALUMINUM FENCE 2.46'
5.50'
PT
ST
POOL
PAVER POOL DECK
PORCH
50' SETBACK
15' SETBACK
N 87°47'00" W
(BASE BEARING)
50.0'
53.1'
2-STORY ROCK & STUCCO COMP. ROOF BASEMENT
21.1'
15' SETBACK
73.3'
CONC. DRIVE
228.57'
LOT 466
0.87 AC.
EXISTING DRAINFIELD LOCATED 35' SETBACK IN THIS AREA PER PERMIT
S 72°46'20" E 197.83'
EIP
C.P.
R=494.17' L=174.45'
EIP
R\W
N 17°10'00" E
29.06'
173.55'
N 07°08'38" E
(CHORD BEARING)
BRAWLEY SCHOOL ROAD
(60' PUBLIC R\W)
T 467
L. KREJCI JR.
31\951
LOT 465
DAVID LOWI
2172\116
PB. 17 PG. 610
Approved
MD
5/31/16
0
40
80
120