2

IREDELL COUNTY HEALTH DEPARTMENT

Statesville Office (704) 878-5305 Mooresville Office (704) 660-3625 PERMIT # 214488

IMPROVEMENT PERMIT / AUTHORIZATION TO CONSTRUCT / OPERATION PERMIT / EXISTING SYSTEM

PIN # 4624-24-2183.000

APPLICANT: Brooks Henderson (Henderson Building) APPLICANT ADDRESS: PO Box 1409 Cornelius NC 28031

SITE ADDRESS: 118 SouthPoint Dr Mooresville, NC PHONE: 704-201-1429 ALT. PHONE: 704-906-9859

SITE DIRECTIONS: BSR, TR SouthPoint, Site on R

SUBDIVISION: CL;T SECTION: 6 LOT # 420 LOT AREA: .770 Acre DESIGN FLOW: Ex. 360 GPD L.T.A.R.: Existing

Septic Tank Existing (gal) STB Date
Pump Tank (gal) PT Date
Pump Make Model Serial #
Nitrification Fields Ex # Lines Ex Linear Ft: Ex
Trench Width Ex Max. Trench Bottom Depth Ex Gravel Depth Ex


☐ New System ☐ Repair ☐ Expansion System Type: ☐ II ☐ III ☐ IV ☐ V ☐ VI
System Description: Existing Conventional - Gravity
Repair System Description: Existing Conventional - Grav.
Maintenance Agreement Required: ☐ YES ☒ NO
☒ GRAVITY ☐ PRESSURE

☒ Residence No. Bedrooms Ex. 3
☐ Business No. Persons Ex. 6
☐ Other No. Employees
☐ Slab ☐ Crawl Space
☒ Basement w/plumbing ☐ Basement w/o plumbing


Water Supply: ☒ Private ☐ Public ☐ Community

Comments / Conditions: System Appeared to Be Functioning @ Time of Inspection.

INITIAL SITE SKETCH

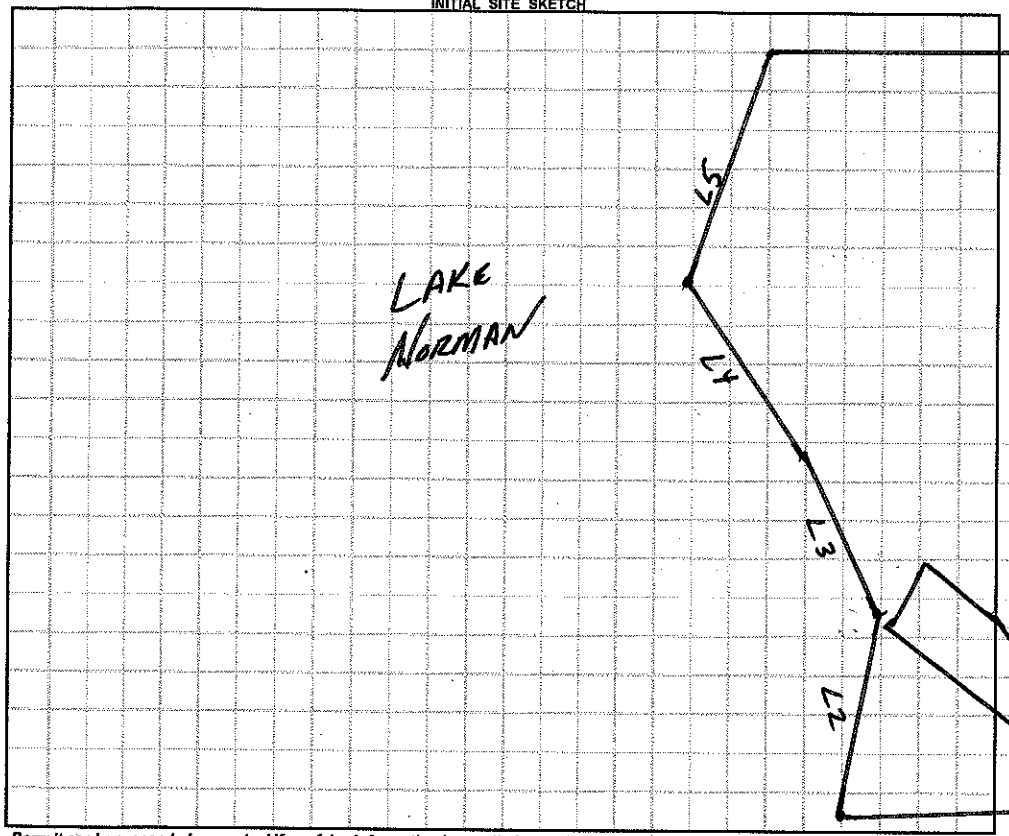

AS BUILT SKETCH

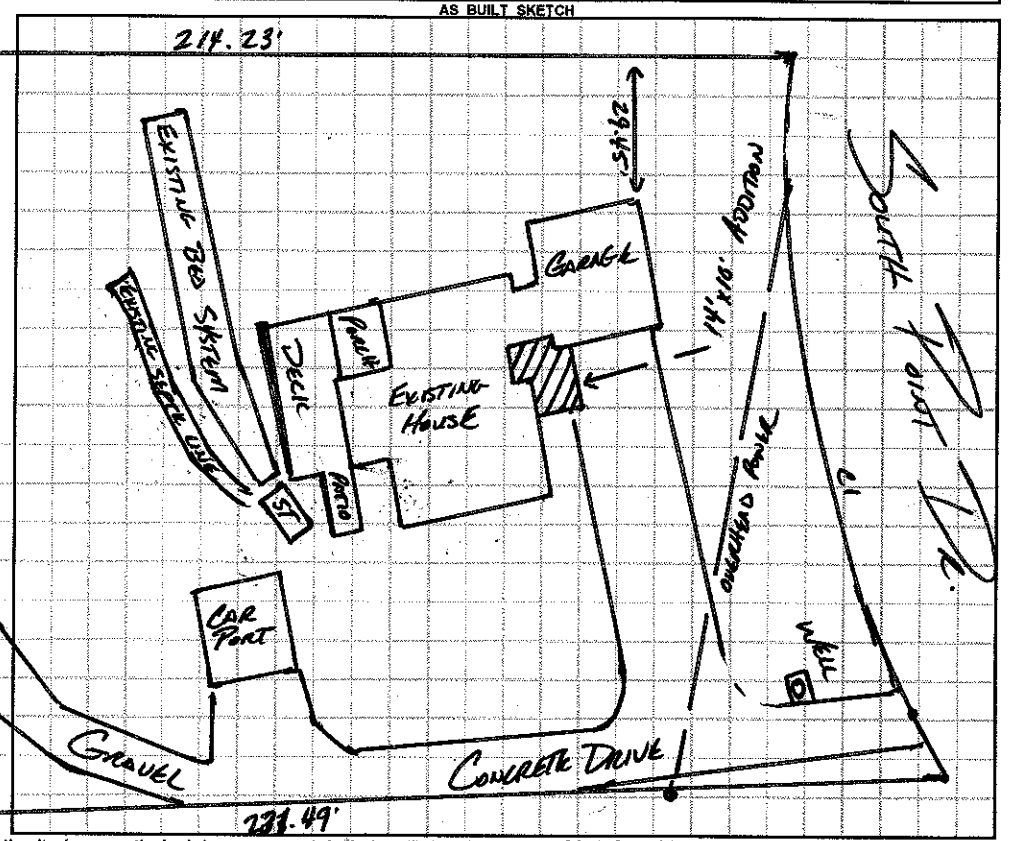

Permit can be suspended or revoked if any false information is supplied toward securing the permit / any unauthorized changes are made to the site / any unauthorized changes are made in the installation of the system. **CONTACT A LOCATOR SERVICE PRIOR TO ANY EXCAVATION**

☐ **IMPROVEMENT PERMIT** *with plot valid without expiration.* ☐ **IMPROVEMENT PERMIT** *with site plan valid for 60 mos.* ☐ **AUTHORIZATION TO CONSTRUCT** *valid for period equal to IMPROVEMENT PERMIT--not to exceed 60 mo.*

Owner / Applicant Signature: Date: 11/30/15 Installed by:

IMPROVEMENT PERMIT by: Date: OPERATION PERMIT by: Date:

AUTHORIZATION TO CONSTRUCT by: Date: Existing System Inspected by: APPROVED NOV 16 2015

Health Dept. Copy - WHITE Applicant (Final Approval) - YELLOW Applicant (Conditional Approval) - PINK