IREDELL COUNTY HEALTH DEPARTMENT

STATESVILLE 878-5305 ∅ MOORESVILLE 704-664-5281

IMPROVEMENT PERMIT / AUTHORIZATION TO CONSTRUCT / OPERATION PERMIT / EXISTING SYSTEM INSPECTION

PERMIT# 110632 PIN# ~~4624-25-6176.6~~ 4624-24-4922 DATE 2/7/03

OWNER OR CONTRACTOR Kenneth Bealer Homes PHONE: Business 704-662-6400 Home

ADDRESS PO Box 3398 Mooresville NC 28117

LOCATION Brawley Sch, TR Yellow Jacket Cir on Lt

SUBDIVISION Craftsman Pt BLOCK / SECTION LOT 6 LOT AREA 30,100 ft² SITE CLASS. PS DESIGN FLOW 480 L.T.A.R. 0.3

Septic Tank: 1000 Gallons; STB 1012 Date 2/21/03
Pump Tank: Gallons; PT Date
Pump Make: Model Serial No.
Nitrification Field: No Fields 1 Square Feet 1600 Linear Feet 535
No Lines 5 Trench Width 36" Max Trench Bottom Depth 36" Gravel Depth 12"

☒ New System ☐ Repair System Type: I (II) III. IV, V, VI
System Description: Gravity Conventional
Repair System Description: 25% Reduction
Maintenance Agreement Required: ☐ Yes ☒ No

☒ House/Mod. Home No. Bedrooms 4
☐ Mobile Home No. Bathrooms 3
☐ Business No. Employees
☐ Other


☐ Slab ☒ Crawl Space ☐ Basement w/plumbing ☐ Basement wo/plumbing

Water Supply: ☒ Individual ☐ Public ☐ Community

Comments:/Conditions:

Comments:/Conditions: Shs tabled as drawn

INITIAL SITE SKETCH 1"=60'

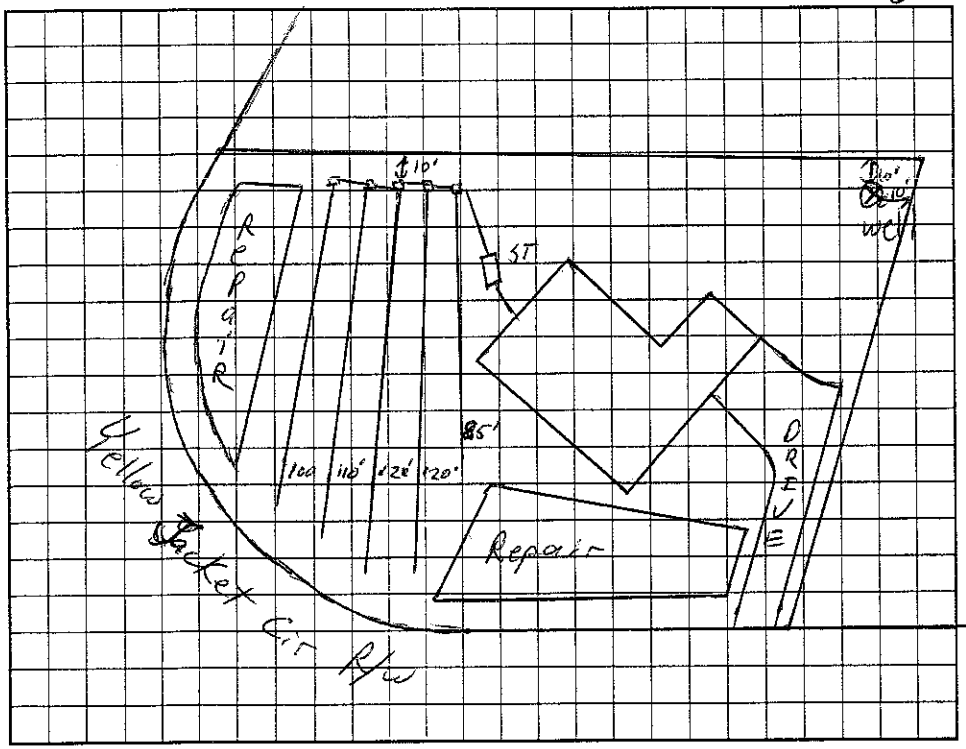

AS BUILT SKETCH

Permit can be suspended or revoked if any false information is supplied toward securing the permit/any unauthorized changes are made to the site/any unauthorized changes are made in the installation of the system. Improvement Permit with plat valid without expiration. Improvement Permit with site plan valid for sixty months. Authorization to Construct is valid for a period equal to that of Improvement Permit – not to exceed sixty months.

Signed: date 2/11/3

Improvement Permit by: RS date 2/7/03

Authorization to Construct by: RS date 2/11/03

Installed by: date

Operation Permit by: RS date 12/30/03

Existing System Inspection by: date

HEALTH DEPT. COPY: WHITE OWNER COPY (FINAL): YELLOW OWNER COPY (INITIAL): PINK