IREDELL COUNTY HEALTH DEPARTMENT STATESVILLE ~~704-878~~-5305 MOORESVILLE 704-664-5281

IMPROVEMENT PERMIT / AUTHORIZATION TO CONSTRUCT / OPERATION PERMIT / EXISTING SYSTEM INSPECTION

PERMIT# ~~44955~~ 7396 PIN# 4624-24-7199 DATE 9/6/03

OWNER OR CONTRACTOR Crescent Resources PHONE: Business 704-665-6905 Home

ADDRESS PO Box 396 Terrell NC 28682

LOCATION BSR, on Lt on corner of 2nd Washam Rd. 2553 Brawley School Rd

SUBDIVISION C L + T BLOCK / SECTION 6 LOT 1236 LOT AREA 0.70 Ac SITE CLASS. P5 DESIGN FLOW 480 L.T.A.R. 0.3

Septic Tank: 1600 Gallons: STB Date

Pump Tank: Gallons: PT Date

Pump Make: Model Serial No. 400

Nitrification Field: No Fields 1 Square Feet 1600 Linear Feet 533

No Lines ~~4~~ 3 Trench Width 36" Max Trench Bottom Depth 36" Gravel Depth 12"

☒ New System ☐ Repair System Type: I (II) III. IV. V. VI

System Description: Gravity Conventional

Repair System Description: 25% Reduction

Maintenance Agreement Required: ☐ Yes ☒ No

☒ House/Mod. Home No. Bedrooms 4

☐ Mobile Home No. Bathrooms 4

☐ Business No. Employees


☐ Other

☐ Slab ☒ Crawl Space ☐ Basement w/plumbing ☐ Basement wo/plumbing

Water Supply: ☒ Individual ☐ Public ☐ Community

Comments/Conditions: 3 lines "Accepted"

INITIAL SITE SKETCH

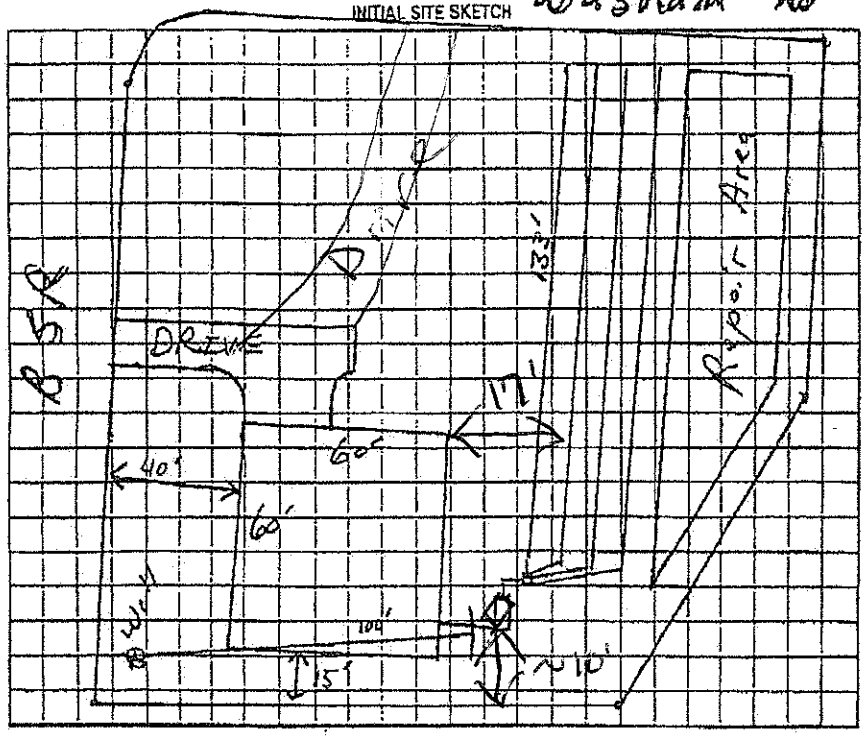

Comments/Conditions: Original IP not found
Installed Quick 4 for Drainfield
3 lines 124, 136 & 140 ft
Filter installed

AS BUILT SKETCH

Permit can be suspended or revoked if any false information is supplied toward securing the permit/any unauthorized changes are made to the site/any unauthorized changes are made in the installation of the system. Improvement Permit with plat valid without expiration. Improvement Permit with site plan valid for sixty months. Authorization to Construct is valid for a period equal to that of Improvement Permit – not to exceed sixty months.

Signed: [signature] date 9/9/03 Installed by: Piedmont Septic (Randy Melton)

Improvement Permit by: [signature] RS date 9/6/03 Operation Permit by: [signature] date 8/29/12

Authorization, ~~struct~~ by: [signature] date 7-18-12 Existing System Inspection by: date

HEALTH DEPT. COPY: WHITE OWNER COPY (FINAL): YELLOW OWNER COPY (INITIAL): PINK

p.1

Oct 31 11 10:35a Dee Plumley 704-478-4149