IREDELL COUNTY HEALTH DEPARTMENT

STATESVILLE 704-878-5305 375.00 Paid MOORESVILLE 704-664-5281

IMPROVEMENT PERMIT / AUTHORIZATION TO CONSTRUCT / OPERATION PERMIT / EXISTING SYSTEM INSPECTION

PERMIT# 110634 PIN# 4624 25 6176.8 / 4624 24 7993 DATE 1/14/04

OWNER OR CONTRACTOR Kenneth Beaton Homes PHONE: Business 704-662-6400 Home

ADDRESS PO Box 3398 Mooresville NC 28117 1734 Yellow Jacket Cir.

LOCATION 1100 TR 2ND Yellow Jacket Cir. corner lot on (R)

SUBDIVISION Craftsman Point BLOCK / SECTION LOT 8 LOT AREA 30303 FT² SITE CLASS. PS DESIGN FLOW 480 L.T.A.R. .3

Septic Tank: 1000 Gallons; STB 1012 Date 2/19/04

Pump Tank: 1000 Gallons; PT 17 Date 3/29/04

Pump Make: Model Serial No.

Nitrification Field: No Fields 1 Square Feet 534/801 Linear Feet 267

No Lines 4@67' Trench Width 2-3' Max Trench Bottom Depth 3' Gravel Depth No

[X] New System [ ] Repair System Type: I, II, III, [IV], V, VI

System Description: Pres Dose 1.16" PPBPS

Repair System Description: Some in front of house

Maintenance Agreement Required: [X] Yes [ ] No

[X] House/Mod. Home No. Bedrooms 4

[ ] Mobile Home No. Bathrooms 3

[ ] Business No. Employees

[ ] Other

[ ] Slab [X] Crawl Space [ ] Basement w/plumbing [ ] Basement wo/plumbing


Water Supply: [X] Individual [ ] Public [ ] Community

Comments:/Conditions: 2' on 8' Centers, 3' on 9' Centers. Well located Maximum Feasible Distance from Repair Area - Only change possible to drop bedroom!!

Comments:/Conditions:

(1" = 50')

INITIAL SITE SKETCH

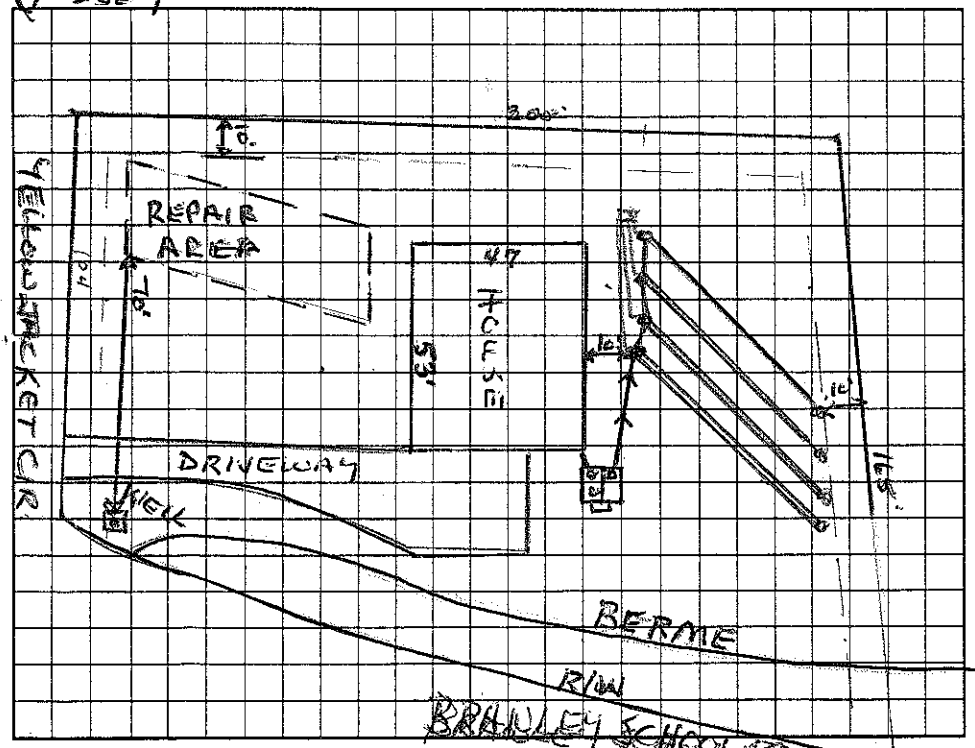

AS BUILT SKETCH

Permit can be suspended or revoked if any false information is supplied toward securing the permit/any unauthorized changes are made to the site/any unauthorized changes are made in the installation of the system. Improvement Permit with plat valid without expiration. Improvement Permit with site plan valid for sixty months. Authorization to Construct is valid for a period equal to that of Improvement Permit – not to exceed sixty months.

Signed: [signature] date 1/21/04

Improvement Permit by: Wesley Sparks RS. date 1/14/04

Authorization to Construct by: Wesley Sparks RS date 1/14/04

Installed by: Steve Jordan

Operation Permit by: [signature] RS date 10/22/04

Existing System Inspection by: date

HEALTH DEPT. COPY: WHITE OWNER COPY (FINAL): YELLOW OWNER COPY (INITIAL): PINK