IREDELL COUNTY HEALTH DEPARTMENT

Statesville Office (704) 878-5305 Mooresville Office (704) 660-3625

IMPROVEMENT PERMIT / AUTHORIZATION TO CONSTRUCT / OPERATION PERMIT / EXISTING SYSTEM

PERMIT # 146163

PIN # 4624-24-8584

APPLICANT: CENTRAL PIEDMONT BUILDERS APPLICANT ADDRESS: PO Box 4041 SALISBURY NC 28145

SITE ADDRESS: 248 WASHAM RD. MOORESVILLE, NC 28117 PHONE: 704-202-6541 ALT. PHONE:

SITE DIRECTIONS: BSR, TL WASHAM, CORNER OF BSR & WASHAM

SUBDIVISION: WASHAM POINT SECTION: LOT # 16 LOT AREA: 1.23 AC DESIGN FLOW: 480 L.T.A.R.: .25

Septic Tank 1000 (gal) STB 760 Date 5-7

Pump Tank (gal) PT Date

Pump Make Model Serial #

Nitrification Fields 1 # Lines 4 @ 120' Linear Ft: 480'

Trench Width 36" Max. Trench Bottom Depth * 22" Gravel Depth

☒ New System ☐ Repair ☐ Expansion System Type: I II (III) IV V VI

System Description: 25% REDUCTION

Repair System Description: SAME

Maintenance Agreement Required: ☐ YES ☒ NO

☒ GRAVITY ☐ PRESSURE

☒ Residence ☐ Business ☐ Other ☐ Slab ☐ Basement w/plumbing


No. Bedrooms 4 No. Persons No. Employees

☒ Crawl Space ☐ Basement w/o plumbing


Water Supply: ☒ Private ☐ Public ☐ Community

Comments / Conditions:

INITIAL SITE SKETCH

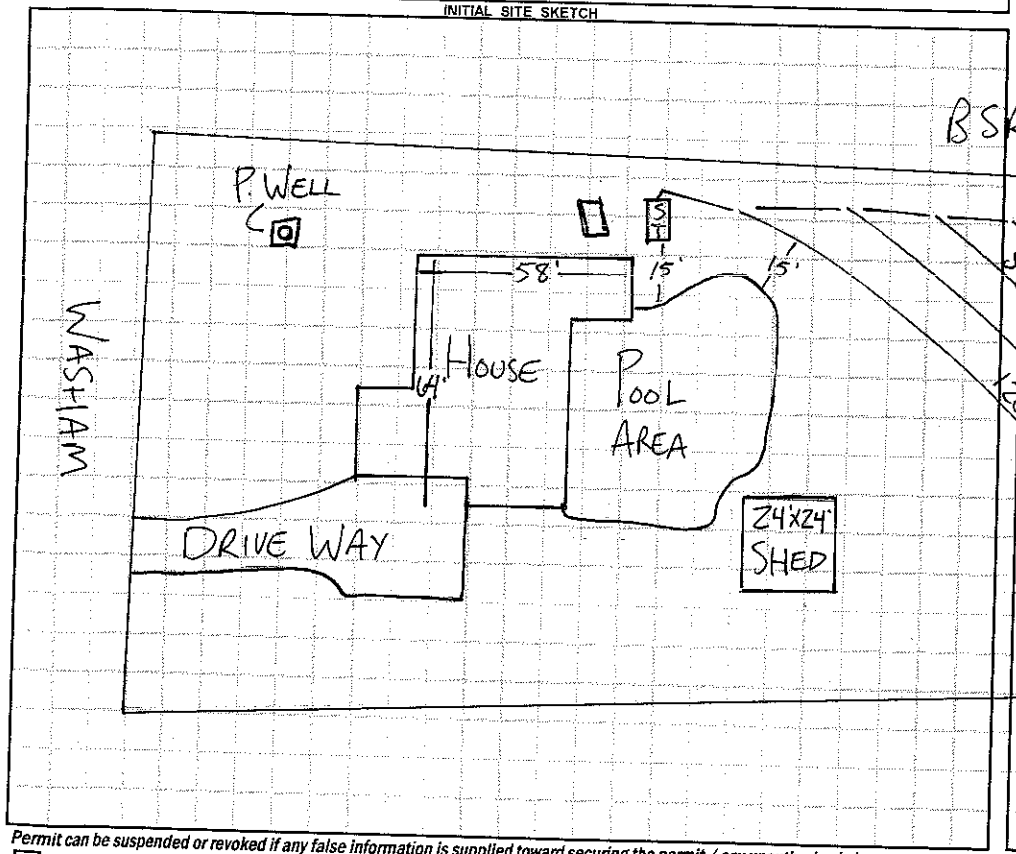

AS BUILT SKETCH

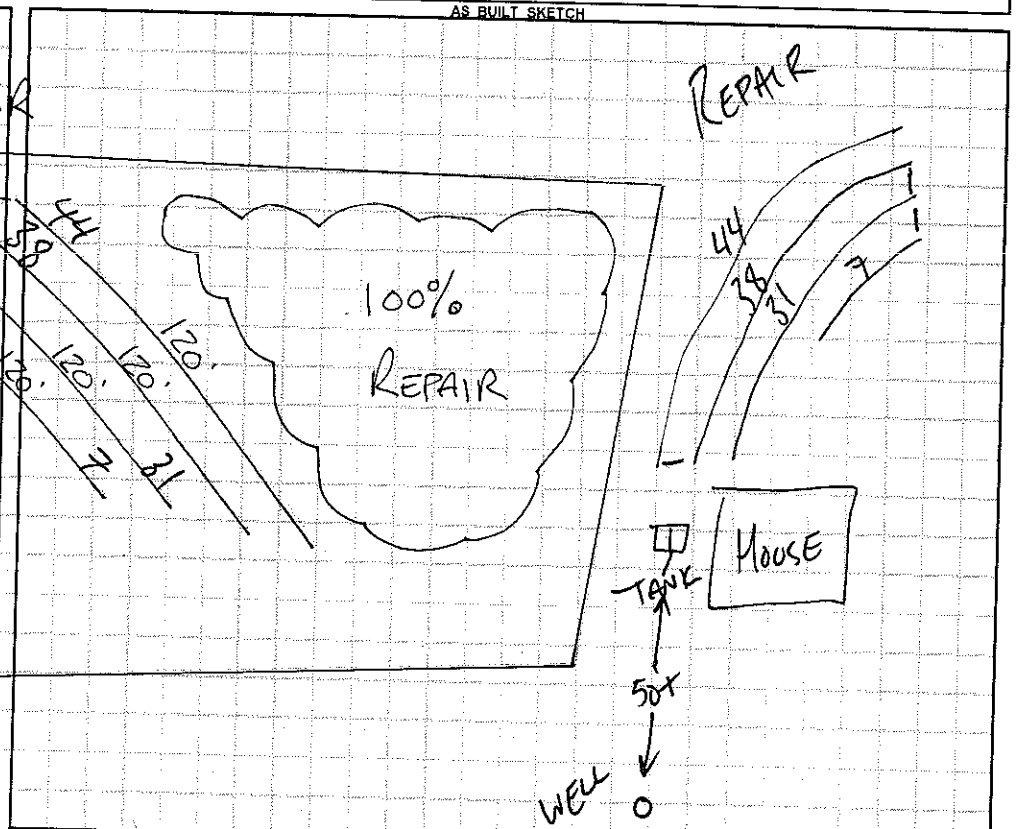

Permit can be suspended or revoked if any false information is supplied toward securing the permit / any unauthorized changes are made to the site / any unauthorized changes are made in the installation of the system. **CONTACT A LOCATOR SERVICE PRIOR TO ANY EXCAVATION**

☐ **IMPROVEMENT PERMIT** *with plat valid without expiration.* ☒ **IMPROVEMENT PERMIT** *with site plan valid for 60 mos.* ☒ **AUTHORIZATION TO CONSTRUCT** *valid for period equal to IMPROVEMENT PERMIT--not to exceed 60 mo.*

Owner / Applicant Signature: Date: 6-17-13 Installed by: MILLER

IMPROVEMENT PERMIT by: Date: 6-10-13 OPERATION PERMIT by: Date: 12-19-13

AUTHORIZATION TO CONSTRUCT by: Date: 6-10-13 Existing System Inspected by: Date:

Health Dept. Copy - WHITE Applicant (Final Approval) - YELLOW Applicant (Conditional Approval) - PINK