Redraw
Ave $0 balance Paid

IREDELL COUNTY HEALTH DEPARTMENT

STATESVILLE 704-878-5305 MOORESVILLE 704-664-5281

IMPROVEMENT PERMIT / AUTHORIZATION TO CONSTRUCT / OPERATION PERMIT / EXISTING SYSTEM INSPECTION

PERMIT# 139010 PIN# 4624252122.000 DATE 7/10/08

OWNER OR APPLICANT Gary Kilgore PHONE: Business Home

ADDRESS 142 Yellow Jacket Cir

LOCATION Brawley School Rd. TR Yellow Jacket Cir on Right

SUBDIVISION CLT BLOCK / SECTION 6 LOT 409 LOT AREA .633 SITE CLASS. PS DESIGN FLOW 360 L.T.A.R. .3 gpd/ft2

Septic Tank: 1000 Gallons; STB 794 Date 9/19/07
Pump Tank: 1000 Gallons; PT 27 Date 3/22/08
Pump Make: Goulds Model WE0 - 3 1/2 HH Serial No.
Nitrification Field: No Fields 1 Square Feet 1200 Linear Feet 200'
No Lines 2@100' Trench Width 24" min Max Trench Bottom Depth 36"

☑ New System ☐ Repair ☐ Expansion System Type: I II III (IV) V VI
System Description: LPPPBPS
Repair System Description: LPPPBPS
Maintenance Agreement Required: ☑ Yes ☐ No

☑ House/Mod. Home ☐ Mobile Home ☐ Business ☐ Other
No. Bedrooms 3 No. Persons 6 No. Employees


Water Supply: ☑ Individual ☐ Public ☐ Community

Gravel Depth N/A ☐ Gravity ☑ Pressure ☐ Slab ☑ Crawl Space ☐ Basement w/plumbing ☐ Basement wo/plumbing


Comments:/Conditions: Redrawn to add retaining wall 200' Repair area available
1"=40'

Comments:/Conditions: Drainlines & Tanks decked 5/23/08 by Wesley Sparks.

INITIAL SITE SKETCH

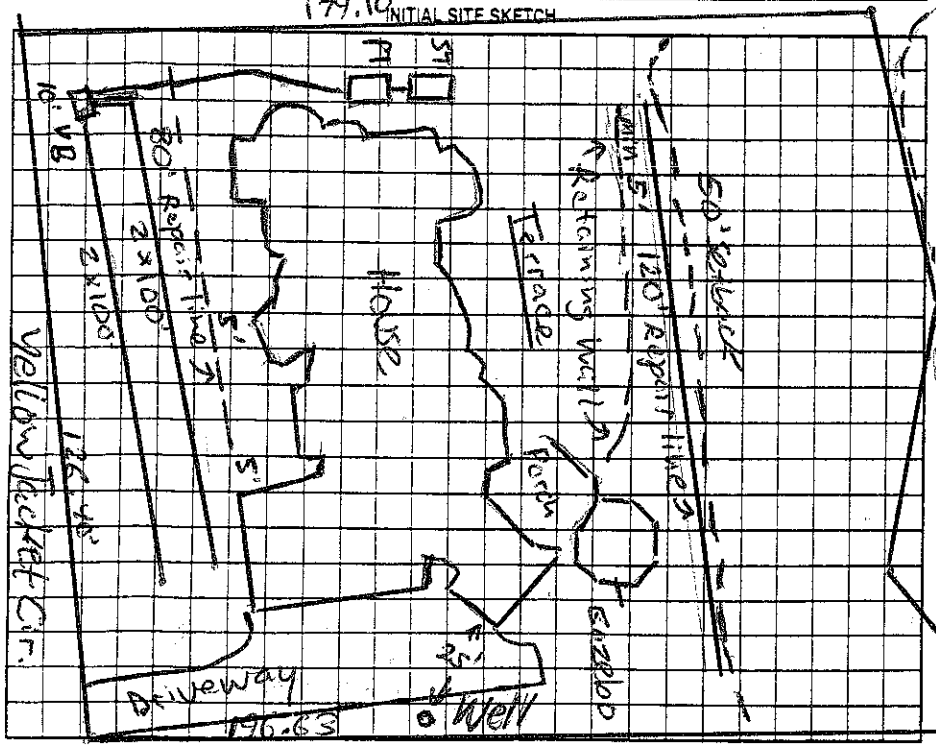

AS BUILT SKETCH

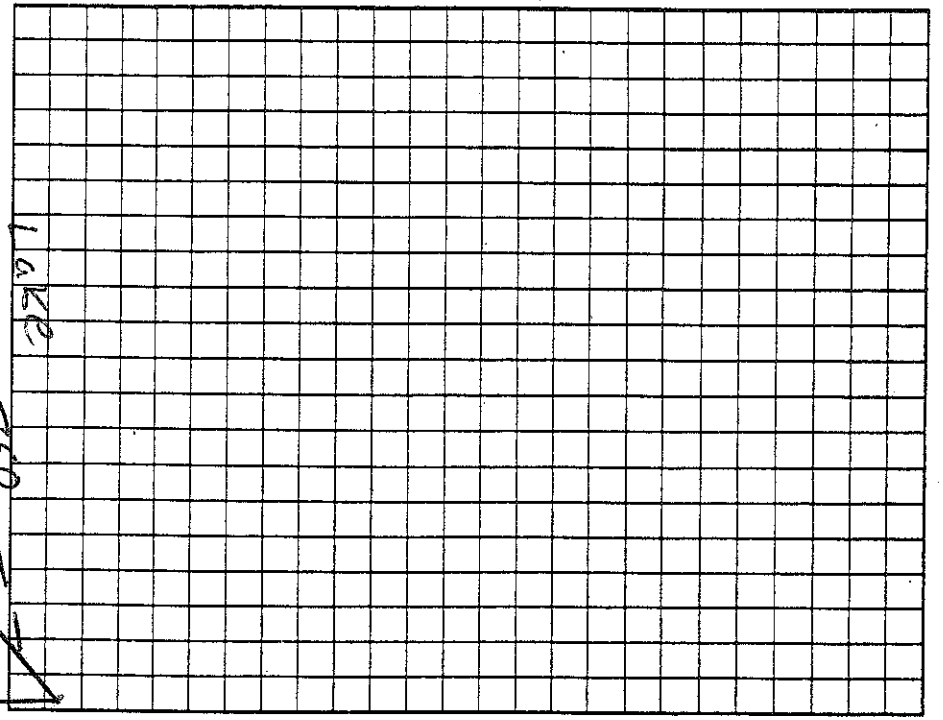

Permit can be suspended or revoked if any false information is supplied toward securing the permit/any unauthorized changes are made to the site/any unauthorized changes are made in the installation of the system. Improvement Permit with plat valid without expiration ☐ Improvement Permit with site plan valid for sixty months ☑ Authorization to Construct is valid for a period equal to that of Improvement Permit – not to exceed sixty months.

Signed: date

Improvement Permit by: Anthony Coker Jr. date 7/10/08

Authorization to Construct by: Anthony Coker Jr. date 7/10/08

Installed by: Curt Dunning

Operation Permit by: Wesley Sparkes date 7/29/08

Existing System Inspection by: date

HEALTH DEPT. COPY: WHITE OWNER COPY (FINAL): YELLOW OWNER COPY (INITIAL): PINK