Entered as approved under 164558 9-22-11 $130 10:15

IREDELL COUNTY HEALTH DEPARTMENT

STATESVILLE 704-878-5305 MOORESVILLE 704-664-5281

IMPROVEMENT PERMIT / AUTHORIZATION TO CONSTRUCT / OPERATION PERMIT / EXISTING SYSTEM INSPECTIO

PERMIT# ~~120865~~ 164558 PIN# 4624-25-4069 DATE 7/16/04

OWNER OR CONTRACTOR ~~Kenneth Beaver Homes~~ Lloyd Hartsell PHONE: Business 704-662-6400 Home

ADDRESS PO Box 3398 Mooresville NC 28117

LOCATION BSR, TR 1st Yellow Jacket Cir, on Lt

SUBDIVISION Crafkum Pt BLOCK / SECTION LOT 5 LOT AREA 0.691 Ac SITE CLASS. PS DESIGN FLOW 480 L.T.A.R. 0.3

Septic Tank: 1000 Gallons; STB 794 Date 10-6-11

Pump Tank: Gallons; PT Date

Pump Make: Model Serial No.

Nitrification Field: No Fields 1 Square Feet 1200 Linear Feet 400

No Lines 4 Trench Width 36" Max Trench Bottom Depth 36" Gravel Depth —

☒ New System ☐ Repair System Type: I, II, III, IV, V, VI

System Description: Gravity 25% Reduction

Repair System Description: Same

Maintenance Agreement Required: ☐ Yes ☒ No

☒ House/Mod. Home No. Bedrooms 4

☐ Mobile Home No. Bathrooms 4½

☐ Business No. Employees

☐ Other

☐ Slab ☒ Crawl Space ☐ Basement w/plumbing ☐ Basement wo/plumbing


Water Supply: ☒ Individual ☐ Public ☐ Community


Comments:/Conditions: ~~X~~ Keep Septic 100Ft from any well.

1" = 50'

Comments:/Conditions: Installed ADS 36 Plastic Chambers, essentially as Drawn. Filter installed.

INITIAL SITE SKETCH

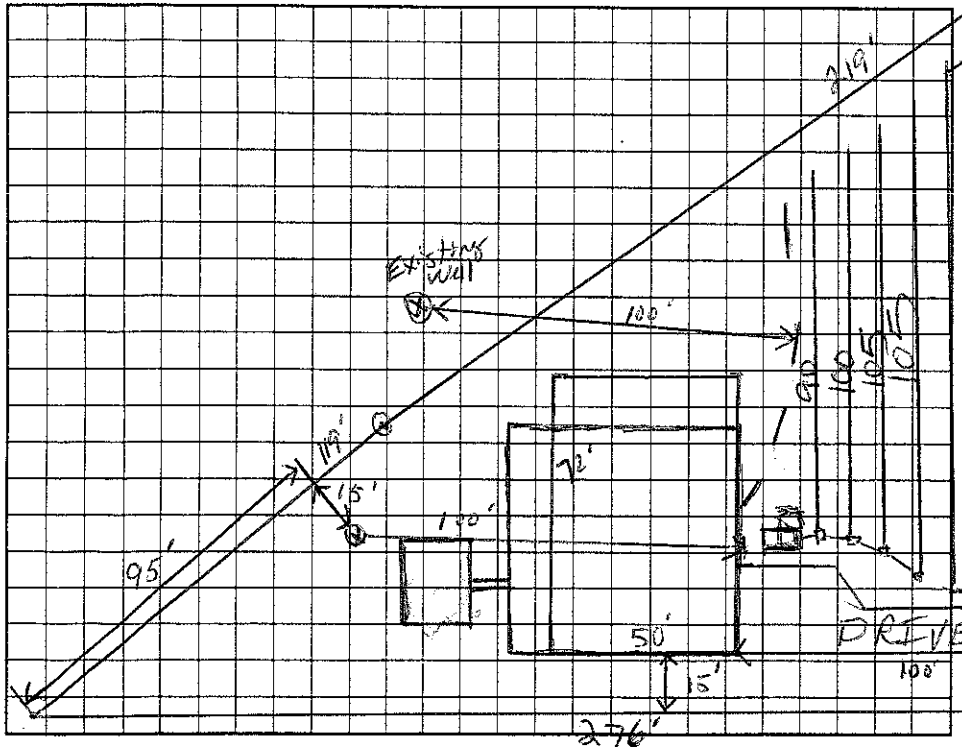

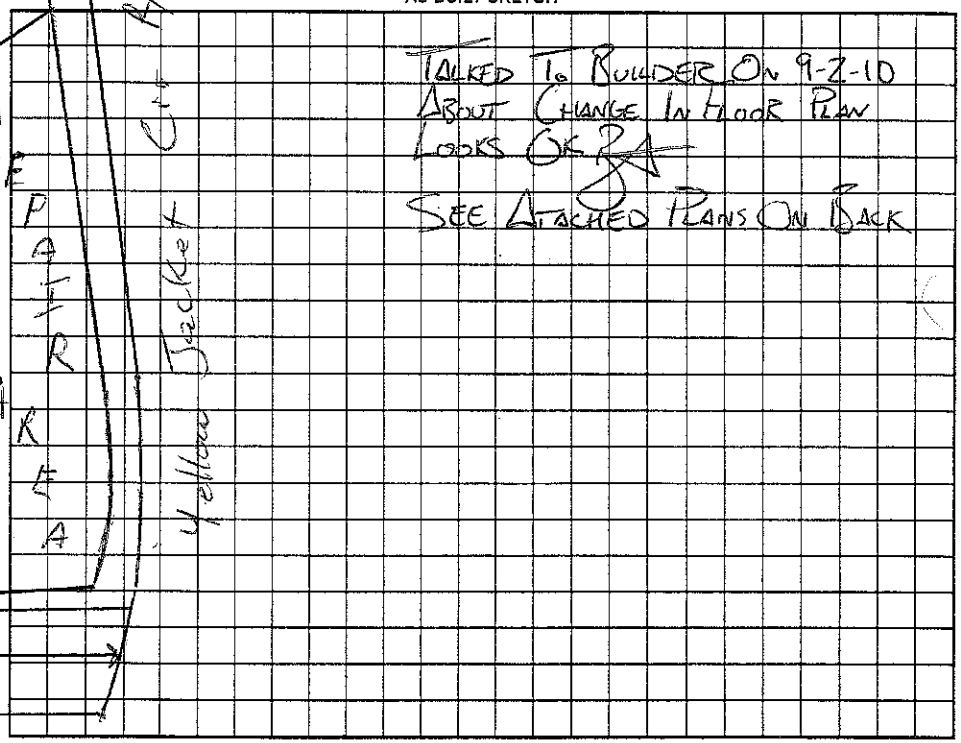

AS BUILT SKETCH

Talked To Builder On 9-2-10 About Change In Floor Plan Looks OK

See Attached Plans On Back

Permit can be suspended or revoked if any false information is supplied toward securing the permit/any unauthorized changes are made to the site/any unauthorized changes are made in the installation of the system. Improvement Permit with plat valid without expiration. Improvement Permit with site plan valid for sixty months. Authorization to Construct is valid for a period equal to that of Improvement Permit – not to exceed sixty months.

Signed: date

Improvement Permit by: RS date 7/16/04

Authorization to Construct by: RS date 7/16/04

Installed by: Curt Dunning

Operation Permit by: date 8/11/2011

Existing System Inspection by: date

HEALTH DEPT. COPY: WHITE OWNER COPY (FINAL): YELLOW OWNER COPY (INITIAL): PINK

164558/9-22-11 Entered as approved 8-12-11 Entered as approved under 120865