IREDELL COUNTY HEALTH DEPARTMENT

$130 Pd Tim - 309 5750

STATESVILLE 704-878-[illegible] MOORESVILLE 704-664-5281

IMPROVEMENT PERMIT / AUTHORIZATION TO CONSTRUCT / OPERATION PERMIT / EXISTING SYSTEM INSPECTION

PERMIT# 110630 PIN# 4624-25-~~6665~~ 5180 DATE 2/7/03

OWNER OR CONTRACTOR Kenneth Bealer Homes PHONE: Business 704-662-6400 Home

ADDRESS PO Box 3398 Mooresville NC 28117

LOCATION Brawley Sch, TR Yellow Jacket, on Lt

SUBDIVISION Craftsmen Pt BLOCK / SECTION LOT 4 LOT AREA 30,068 Ft² SITE CLASS. Ps DESIGN FLOW 480 L.T.A.R. 0.3

Septic Tank: 1000 Gallons; STB 312 Date 12-31-01

Pump Tank: Gallons; PT Date

Pump Make: Model Serial No.

Nitrification Field: No Fields 1 Square Feet 1200 Linear Feet 400

No Lines 4 Trench Width 36" Max Trench Bottom Depth 36" Gravel Depth —

☒ New System ☐ Repair System Type: I, II, (III), IV, V, VI

System Description: Gravity 25% Reduction

Repair System Description: ~~Same~~ Panel Blk

Maintenance Agreement Required: ☐ Yes ☒ No

☒ House/Mod. Home No. Bedrooms 4

☐ Mobile Home No. Bathrooms 2.5

☐ Business No. Employees

☐ Other

☐ Slab ☒ Crawl Space ☐ Basement w/plumbing ☐ Basement wo/plumbing


Water Supply: ☒ Individual ☐ Public ☐ Community

Comments:/Conditions:

A/H OK change 2-10-05

Comments:/Conditions: Installed EZ Flow in 4-100' lines

INITIAL SITE SKETCH 1"=60'

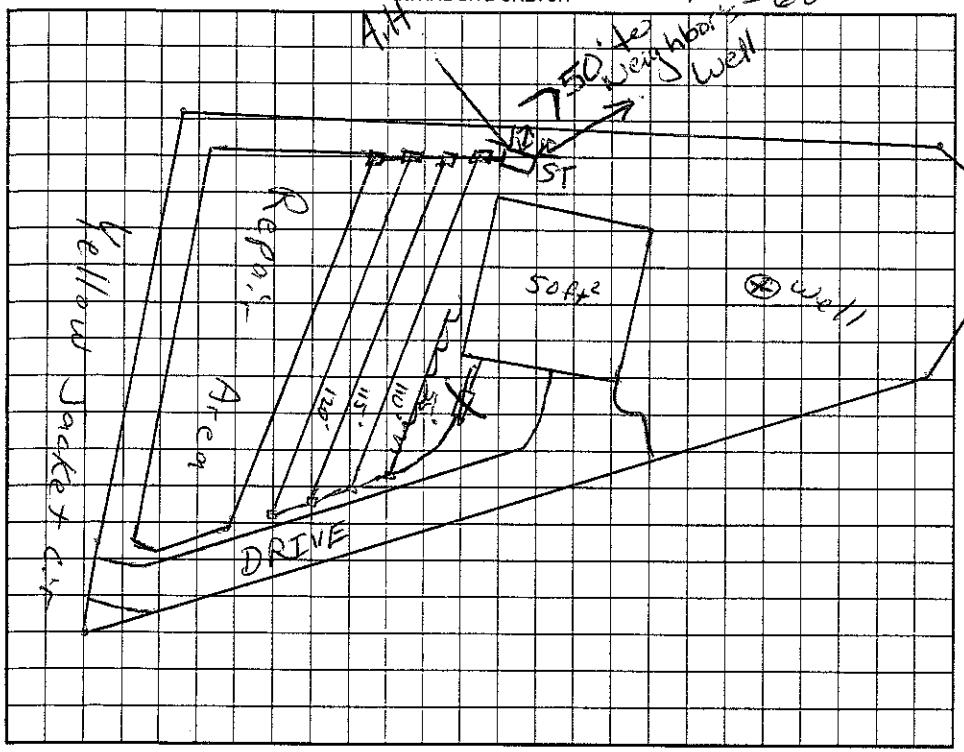

AS BUILT SKETCH

Permit can be suspended or revoked if any false information is supplied toward securing the permit/any unauthorized changes are made to the site/any unauthorized changes are made in the installation of the system. Improvement Permit with plat valid without expiration. Improvement Permit with site plan valid for sixty months. Authorization to Construct is valid for a period equal to that of Improvement Permit – not to exceed sixty months.

Signed: [signature] date 2/11/3

Improvement Permit by: [signature] RS date 2/7/03

Authorization to Construct by: [signature] RS date 2/11/03

Installed by: R & H

Operation Permit by: [signature] RS date 2/10/05

Existing System Inspection by: date

HEALTH DEPT. COPY: WHITE OWNER COPY (FINAL): YELLOW OWNER COPY (INITIAL): PINK