IREDELL COUNTY HEALTH DEPARTMENT

STATESVILLE 704-878-5305 1300 Paid MOORESVILLE 704-664-5281

IMPROVEMENT PERMIT / AUTHORIZATION TO CONSTRUCT / OPERATION PERMIT / EXISTING SYSTEM INSPECTION

PERMIT# 110464 PIN# ~~4624-25-6176-3~~ 4624-25-7114 DATE 7/14/03

OWNER OR CONTRACTOR Kenneth Beaver Homes PHONE: Business 704-662-6400 Home

ADDRESS PO Box 3398 Mooresville NC. 28117

LOCATION Yellow Jacket Circle, BSR TR Yellow Jacket to 3rd lot on L

SUBDIVISION Craftsmen Point BLOCK / SECTION LOT 3 LOT AREA .76 SITE CLASS PS DESIGN FLOW 360 L.T.A.R. .3

Septic Tank: 1000 Gallons; STB 1012 Date 9/7/03
Pump Tank: Gallons; PT Date
Pump Make: Model Serial No.
Nitrification Field: No Fields 1 Square Feet 900 ✓ Linear Feet 300 ✓
No Lines 4@75' Trench Width 3' Max Trench Bottom Depth 3' Gravel Depth No

☒ New System ☐ Repair System Type: I, II, (III) IV, V, VI
System Description: GRAVITY - 17A 3
Repair System Description: SAME
Maintenance Agreement Required: ☐ Yes ☐ No

☒ House/Mod. Home No. Bedrooms 3
☐ Mobile Home No. Bathrooms 4
☐ Business No. Employees
☐ Other

Water Supply: ☒ Individual ☐ Public ☐ Community


☐ Slab ☒ Crawl Space ☐ Basement w/plumbing ☐ Basement wo/plumbing

Comments:/Conditions:


Comments:/Conditions:

1" = 60'

INITIAL SITE SKETCH

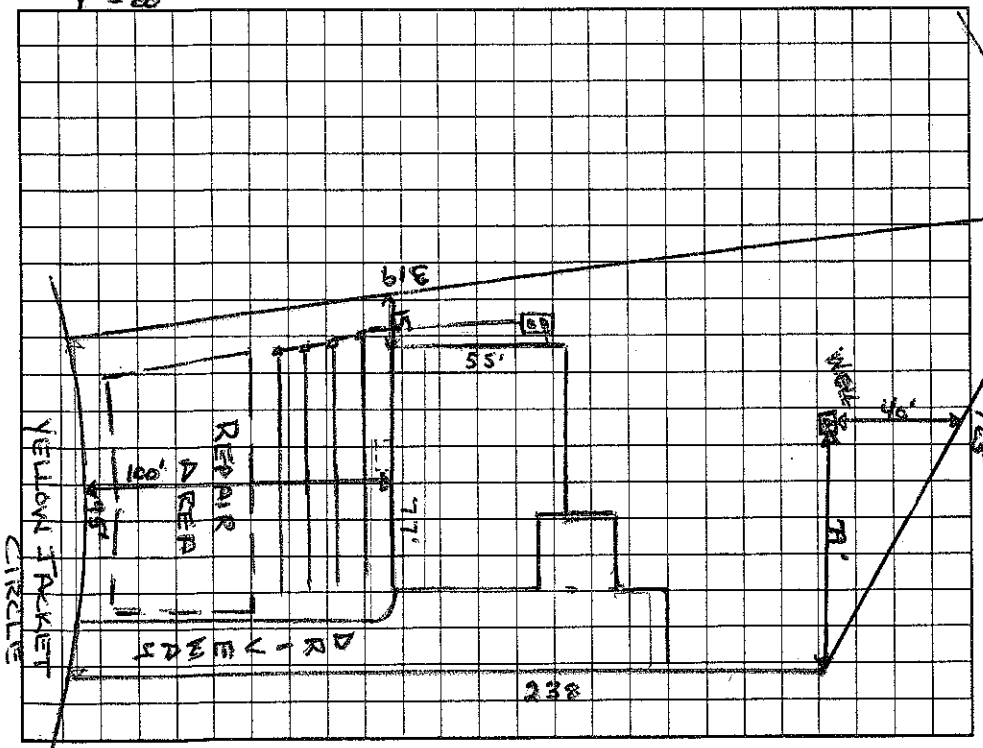

AS BUILT SKETCH

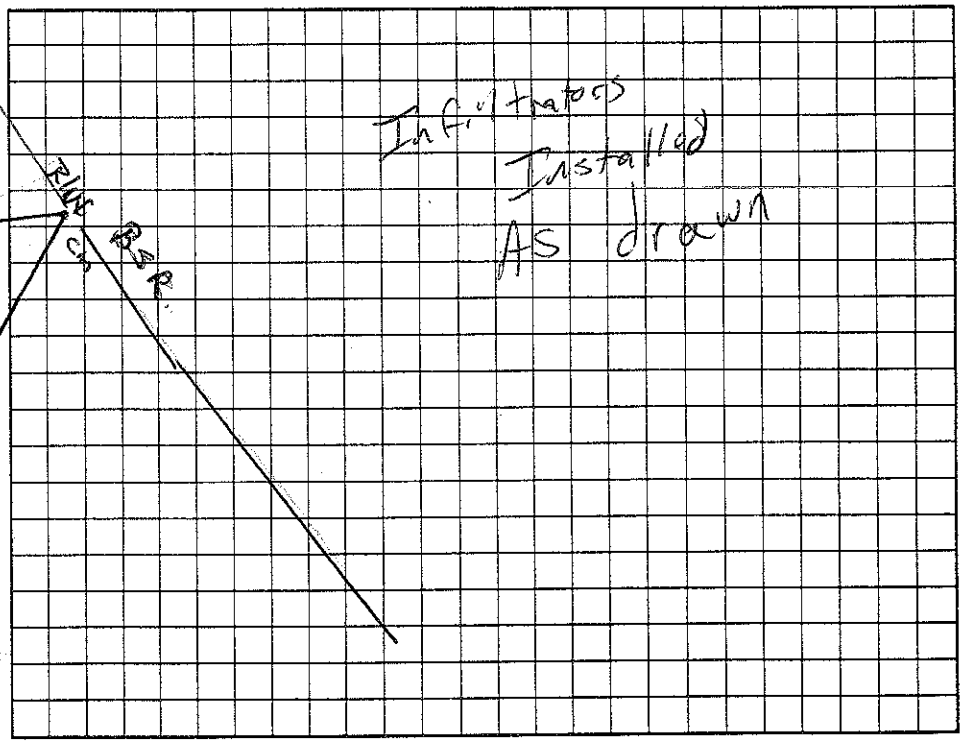

Permit can be suspended or revoked if any false information is supplied toward securing the permit/any unauthorized changes are made to the site/any unauthorized changes are made in the installation of the system. Improvement Permit with plat valid without expiration. Improvement Permit with site plan valid for sixty months. Authorization to Construct is valid for a period equal to that of Improvement Permit – not to exceed sixty months.

Signed: ✱ Julia S. date 7/22/3 Installed by: Steve Jordan

Improvement Permit by: Wesley Sparks RS. date 7/15/03 Operation Permit by: RS date 3/11/04

Authorization to Construct by: Wesley Sparks RS. date 7/15/03 Existing System Inspection by: date

HEALTH DEPT. COPY: WHITE OWNER COPY (FINAL): YELLOW OWNER COPY (INITIAL): PINK