IREDELL COUNTY HEALTH DEPARTMENT

STATESVILLE 704-878-5305 $130 MOORESVILLE 704-664-5281

IMPROVEMENT PERMIT / AUTHORIZATION TO CONSTRUCT / OPERATION PERMIT / EXISTING SYSTEM INSPECTION

PERMIT# 120864 / 17121 PIN# 4624-25-8201 DATE 7/16/04

OWNER OR CONTRACTOR Kenneth Beaver Homes PHONE: Business 704-662-6400 Home

ADDRESS PO Box 3398 Mooresville NC 28117

LOCATION BSR TR Yellow Jacket Cir, on Lt

SUBDIVISION Crafts Mem Pt BLOCK / SECTION ____ LOT 2 LOT AREA 0.704AC SITE CLASS. PS DESIGN FLOW 450 L.T.A.R. 0.5

ENTERED

Septic Tank: 1000 Gallons; STB 794 Date 7-28-12

Pump Tank: ____ Gallons; PT ____ Date ____

Pump Make: ____ Model ____ Serial No. ____

Nitrification Field: No Fields 1 Square Feet 610 Linear Feet 270

No Lines 6@45' Trench Width 24" or 36" Max Trench Bottom Depth 36" Gravel Depth —

☒ New System ☐ Repair System Type: I, II, III, IV, V, VI

System Description: Gravity Panel Block

Repair System Description: Pump Innovative

Maintenance Agreement Required: ☐ Yes ☒ No

☒ House/Mod. Home ☐ Mobile Home ☐ Business ☐ Other

No. Bedrooms 4 No. Bathrooms 4 No. Employees ____

☐ Slab ☒ Crawl Space ☐ Basement w/plumbing ☐ Basement wo/plumbing

Water Supply: ☒ Individual ☐ Public ☐ Community


Comments:/Conditions: 8FOC or 9FOE

1"=50'

Comments:/Conditions: REVIEWED SITE PLAN & HOUSE PLANS 4-25-12 RA

INITIAL SITE SKETCH

AS BUILT SKETCH

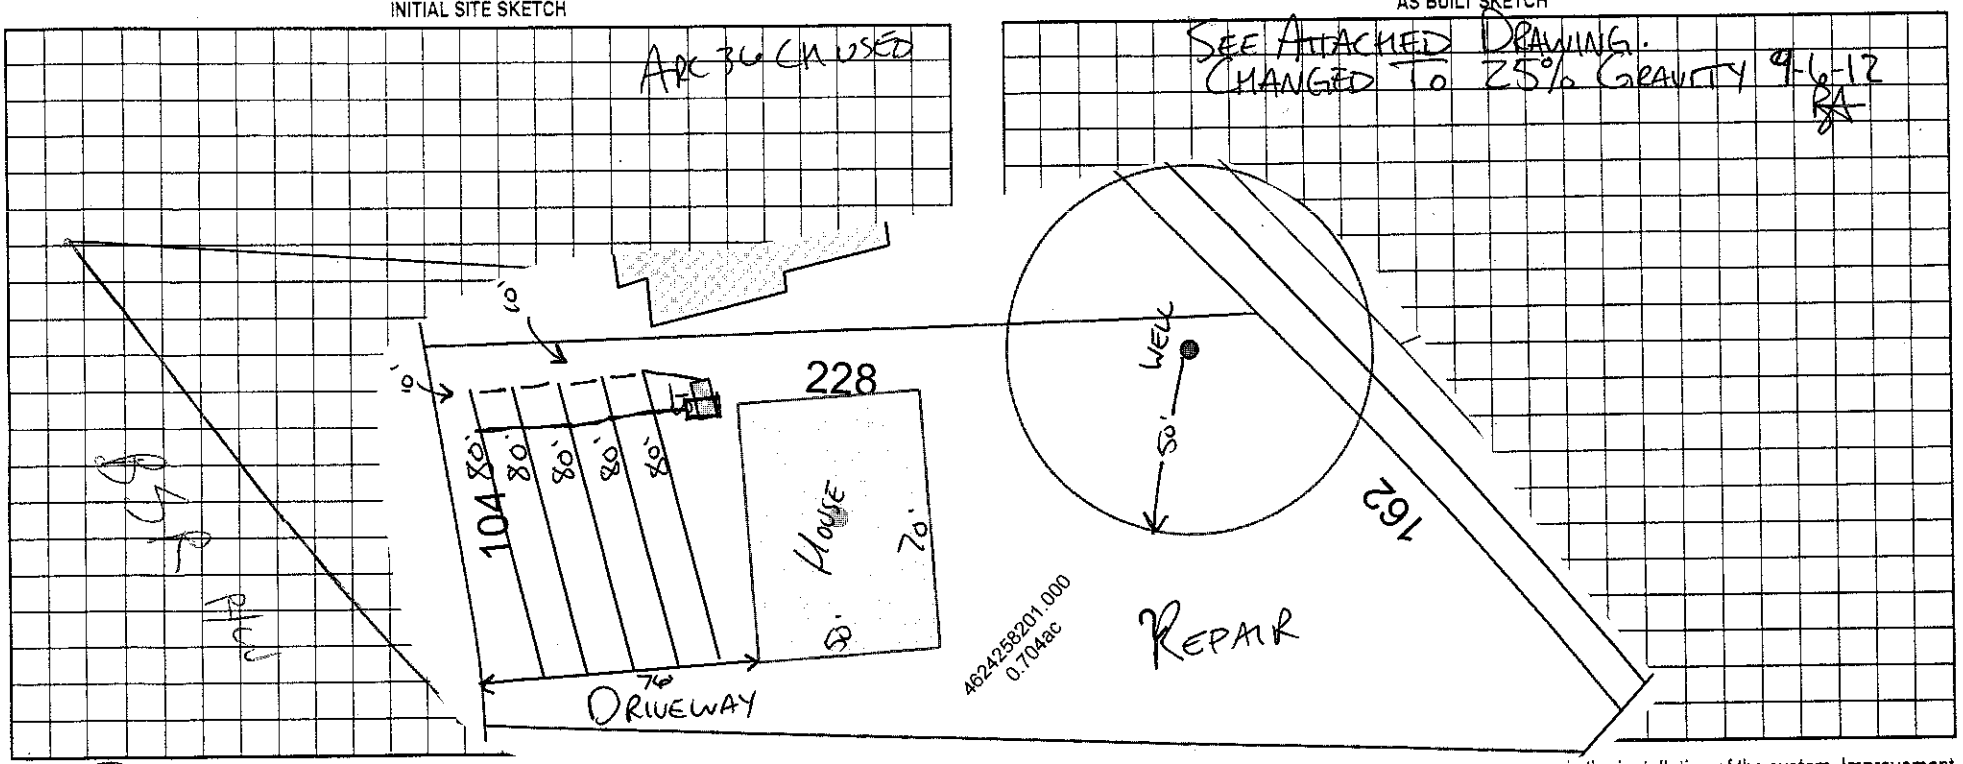

Permit can be suspended or revoked if any false information is supplied toward securing the p... made in the installation of the system. Improvement Permit with plat valid without expiration. Improvement Permit with site plan valid for sixty months. Authorization to ... period equal to that of Improvement Permit – not to exceed sixty months.

319

Signed: Aaron Rey date ____

Improvement Permit by: RS date 7/16/04

Authorization to Construct by: REHS date 4-25-12

Installed by: ABERNATHY

Operation Permit by: RA REHS date 9-6-12

Existing System Inspection by: ____ date ____

HEALTH DEPT. COPY: WHITE OWNER COPY (FINAL): YELLOW OWNER COPY (INITIAL): PINK