IREDELL COUNTY HEALTH DEPARTMENT

STATESVILLE 704-878-5305 MOORESVILLE 704-664-5281

IMPROVEMENT PERMIT / AUTHORIZATION TO CONSTRUCT / OPERATION PERMIT / EXISTING SYSTEM INSPECTION

PERMIT# 125051 PIN# 4624 36 2585.005 4624266625 DATE 4/5/05

OWNER OR CONTRACTOR POINT ON NORMAN/SIMONINI PHONE: Business 663-6905 Home Rick 201-8976

ADDRESS 2214 BRAWLEY SCHOOL RD - MOORESVILLE NC 28117

LOCATION BRAWLEY SCHOOL - TR BUNKER WAY - 4TH ON RT

SUBDIVISION POINT BLOCK / SECTION 10 LOT 1005 LOT AREA 38,891 ft² SITE CLASS. PS DESIGN FLOW 480 GPD L.T.A.R. .36 PD/FT²

Septic Tank: ~~1000~~ 1500 Gallons; STB 444 Date 11-11-07

Pump Tank: 1000 Gallons; PT 27 Date 9-29-07

Pump Make: Goulds Model WE0312M(U) Serial No.

Nitrification Field: No Fields 1 Square Feet 560 Linear Feet 280

No Lines 4 Trench Width 24" Max Trench Bottom Depth 36" Gravel Depth N/A

☑ New System ☐ Repair System Type: I, II, III, (IV) V, VI

System Description: LPPANEL

Repair System Description: SAME

Maintenance Agreement Required: ☑ Yes ☐ No

☑ House/Mod. Home No. Bedrooms 4

☐ Mobile Home No. Bathrooms 4

☐ Business No. Employees

☐ Other

☐ Slab ☑ Crawl Space ☐ Basement w/plumbing ☐ Basement wo/plumbing


Water Supply: ☐ Individual ☐ Public ☑ Community

Comments:/Conditions: DO NOT CUT HOUSE PAD

Comments:/Conditions: 8/21/07 Okay to set House 60ft from front PL (should still have enough Repair) 1/8/08 Checked ~~tanks~~ lines 1/9/08 Checked tanks

1" = 50'

INITIAL SITE SKETCH

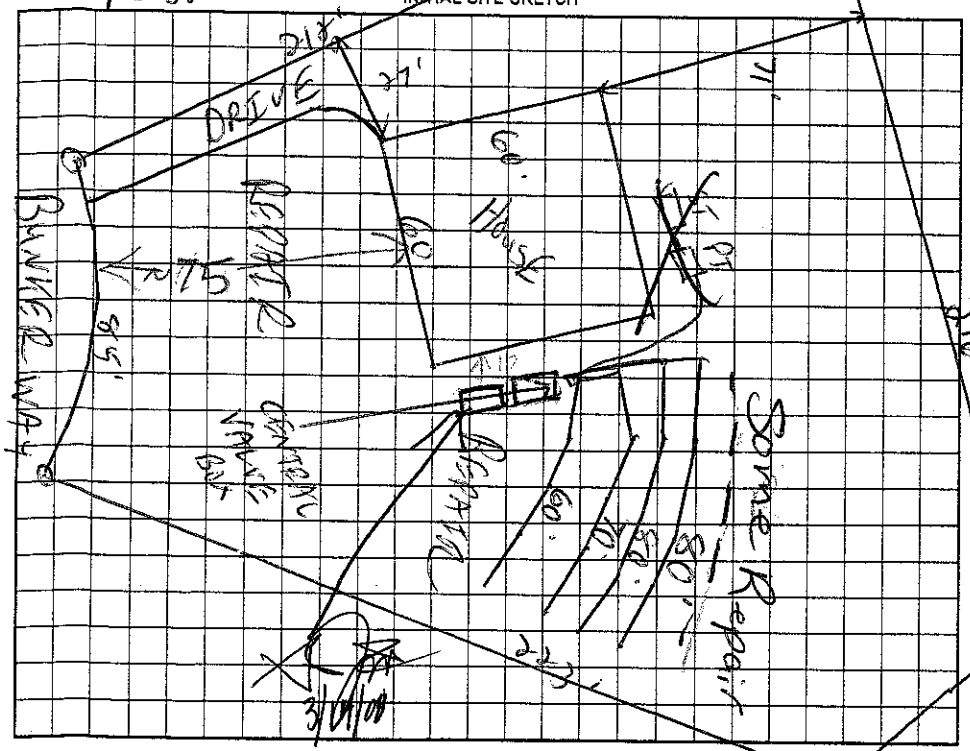

AS BUILT SKETCH

Permit can be suspended or revoked if any false information is supplied toward securing the permit/any unauthorized changes are made to the site/any unauthorized changes are made in the installation of the system. Improvement Permit with plat valid without expiration. Improvement Permit with site plan valid for sixty months. Authorization to Construct is valid for a period equal to that of Improvement Permit – not to exceed sixty months.

Signed: Kathleen Raver date 4/15/05

Improvement Permit by: [signature] date 4/5/05

Authorization to Construct by: Wesley Sparks RS. date 6/12/07

Installed by: R&R RS

Operation Permit by: [signature] date 3/14/08

Existing System Inspection by: date

HEALTH DEPT. COPY: WHITE OWNER COPY (FINAL): YELLOW OWNER COPY (INITIAL): PINK