IREDELL COUNTY HEALTH DEPARTMENT

STATESVILLE 704-878-5305 MOORESVILLE 704-664-5281

IMPROVEMENT PERMIT / AUTHORIZATION TO CONSTRUCT / OPERATION PERMIT / EXISTING SYSTEM INSPECTION

3:06

PERMIT# 125050 PIN# 4624-36-2584.004 4624-26-6871

OWNER OR CONTRACTOR The Point on Norman, LLC/ SIMONINI PHONE: Business 660-1185 Home DATE 4-1-05

ADDRESS 2214 Brawley School Rd., Mooresville, NC 28117

LOCATION BRAWLEY SCHOOL - IR BUNKER WAY - AT END OF RT

SUBDIVISION POINT BLOCK / SECTION 16 LOT 1004 LOT AREA 33729 ft² SITE CLASS. 05 DESIGN FLOW 480GPD L.T.A.R. 1365 ft²

Septic Tank: 1000 Gallons: STB 338 Date 11-3-01

Pump Tank: Gallons: PT Date

Pump Make: Model Serial No.

Nitrification Field: No Fields 1 Square Feet 1200 Linear Feet 400

No Lines ~~30~~ 33 Trench Width 36" Max Trench Bottom Depth 36" Gravel Depth N/A

☒ New System ☐ Repair System Type: I, II, III, IV, V, VI

System Description: GRAVITY 338 GAL CONCRETE

Repair System Description: LP PANG L

Maintenance Agreement Required: ☐ Yes ☐ No

☐ Slab ☑ Crawl Space ☐ Basement w/plumbing ☐ Basement wo/plumbing

☑ House/Mod. Home No. Bedrooms 4

☐ Mobile Home No. Bathrooms 4

☐ Business No. Employees

☐ Other


Water Supply: ☐ Individual ☐ Public ☐ ~~Community~~

Comments/Conditions: GAS 10'

Comments:/Conditions: Okay to Center Feed 12/20/07 Checked ST & 2 of 6 lines

2 Drop Boxes

1" = 50' INITIAL SITE SKETCH

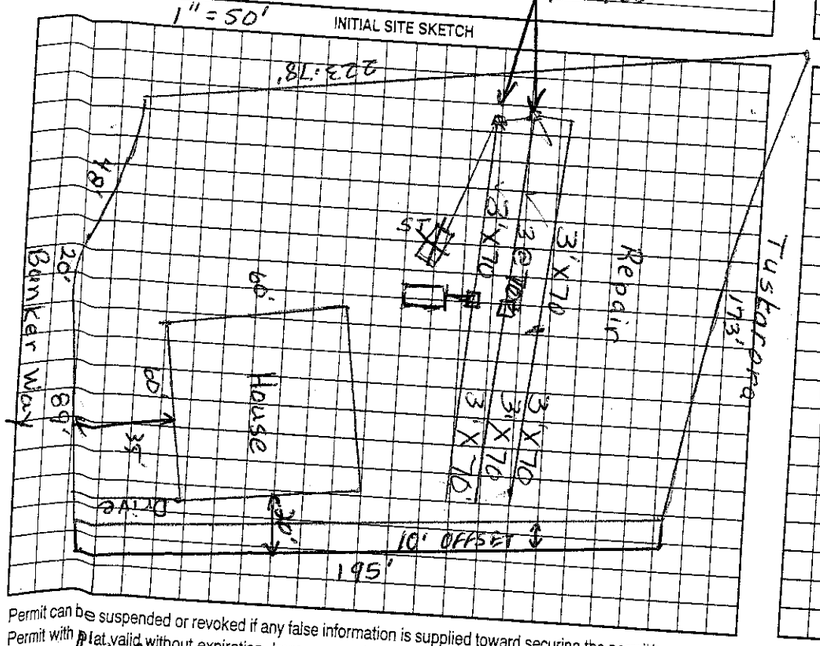

AS BUILT SKETCH

Installed Quick 4

Permit can be suspended or revoked if any false information is supplied toward securing the permit/any unauthorized changes are made to the site/any unauthorized changes are made in the installation of the system. Improvement Permit with plat valid without expiration. Improvement Permit with site plan valid for sixty months. Authorization to Construct is valid for a period equal to that of Improvement Permit – not to exceed sixty months.

Signed: Kathleen Naver

Improvement Permit by: date 4/15/05

Authorization to Construct by: Wesley Sparks R.S. date 4/1/05

Installed by: date 6/19/07

Operation Permit by: date 1/3/08

Existing System Inspection by: date

HEALTH DEPT. COPY: WHITE OWNER COPY (FINAL): YELLOW OWNER COPY (INITIAL): PINK