3.30

IREDELL COUNTY HEALTH DEPARTMENT

ESVILLE 704-878-5305 MOORESVILLE 704-664-5281

IMPROVEMENT PERMIT / AUTHORIZATION TO CONSTRUCT / OPERATION PERMIT / EXISTING SYSTEM INSPECTION

PERMIT# 105470 PIN# ~~4624 27 5905.473~~ 4624-27-0863 DATE 5/14/02

OWNER OR CONTRACTOR POINT ON NORMAN / Simonini PHONE: Business 660-1185 Home

ADDRESS 2214 BRAWLEY SCHOOL RD. MOORESVILLE NC 28115

LOCATION BRAWLEY SCHOOL RD - TR 2nd MANSFIELD - TL BRACKTON - TR 2nd DEOHAM LP - 3RD ON LT

SUBDIVISION POINT BLOCK / SECTION 9 LOT 973 LOT AREA 1.16AC SITE CLASS PS DESIGN FLOW 480GPD L.T.A.R. .36PD/FT²

Septic Tank: 1000+ Gallons; STB 338 Date 2-28-05
Pump Tank: 1000+ Gallons; PT 27 Date 2-30-05
Pump Make: Goulds Model WE0312HC Serial No.
Nitrification Field: No Fields 1 Square Feet 540 Linear Feet 270
No Lines 4@70' Trench Width 24-36" Max Trench Bottom Depth 36" Gravel Depth N/A

☑ New System ☐ Repair System Type: I, II, III, ⓘ, V, VI
System Description: LP PANEL
Repair System Description: SAME
Maintenance Agreement Required: ☑ Yes ☐ No


☑ House/Mod. Home No. Bedrooms 4
☐ Mobile Home No. Bathrooms 4
☐ Business No. Employees
☐ Other
☐ Slab ☑ Crawl Space ☐ Basement w/plumbing ☐ Basement wo/plumbing

Water Supply: ☐ Individual ☐ Public ☑ Community


Comments/Conditions: 1) INLINE PUMP FILTER TO BE INSTALLED

Comments/Conditions: Checked tanks & lines 4/6/05
Installed essentially as Drawn

INITIAL SITE SKETCH 1"=50'

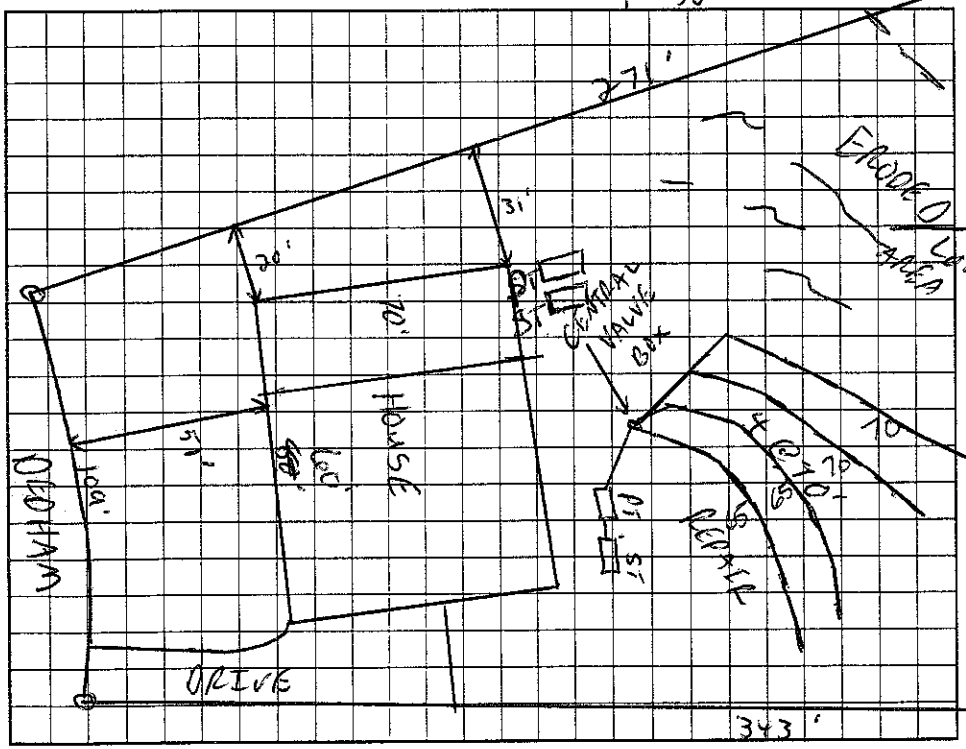

AS BUILT SKETCH

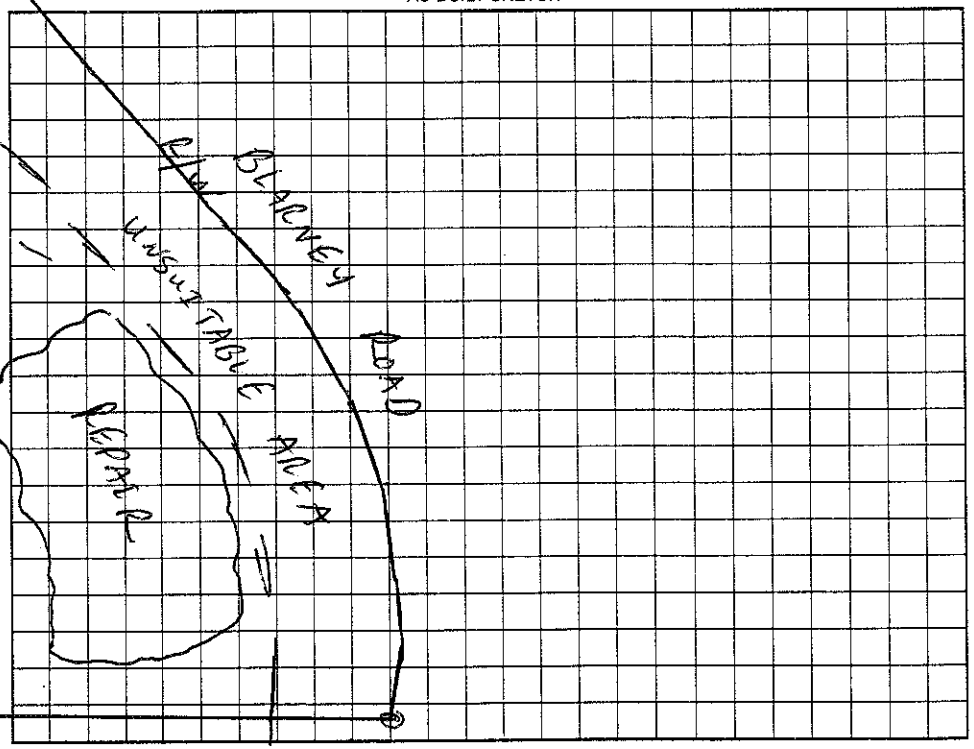

Permit can be suspended or revoked if any false information is supplied toward securing the permit/any unauthorized changes are made to the site/any unauthorized changes are made in the installation of the system. Improvement Permit with plat valid without expiration. Improvement Permit with site plan valid for sixty months. Authorization to Construct is valid for a period equal to that of Improvement Permit – not to exceed sixty months.

Signed: date 5-23-05 Installed by: R.S.

Improvement Permit by: C. L. Jones LS date 5/14/02 Operation Permit by: Marvin Nolan date 6/23/05

Authorization to Construct by: LS date 9/9/04 Existing System Inspection by: date

HEALTH DEPT. COPY: WHITE OWNER COPY (FINAL): YELLOW OWNER COPY (INITIAL): PINK