IREDELL COUNTY HEALTH DEPARTMENT

STATESVILLE 704-878-5305 MOORESVILLE 704-664-5281

IMPROVEMENT PERMIT / AUTHORIZATION TO CONSTRUCT / OPERATION PERMIT / EXISTING SYSTEM INSPECTION

PERMIT# 105480 PIN# 4624 27 5905. 976 4624-27-4287 DATE 5/20/02

OWNER OR CONTRACTOR POINT ON NORMAN / John R. Poore PHONE: Business 660-1185 Home

ADDRESS 2214 BRAWLEY SCHOOL - MOORESVILLE 28117

LOCATION BRAWLEY SCHOOL - TR 2nd MANSFIELD - TL BROCKTON - AT END

SUBDIVISION POINT BLOCK / SECTION 9 LOT 976 LOT AREA — SITE CLASS. PS DESIGN FLOW. 480GPD L.T.A.R. 0.20 GPD/FT²

Septic Tank: ~~1000~~ 1500 Gallons; STB 338 Date 10-2-05
Pump Tank: 1000+ Gallons; PT 283 Date 9-27-05
Pump Make: Goulds Model 3/4HP Serial No.
Nitrification Field: No Fields 1 Square Feet 1800 Linear Feet 600
No Lines 5@120 Trench Width 36" Max Trench Bottom Depth 36" Gravel Depth N/A

☑ New System ☐ Repair System Type: I, II, III, IV, V, VI
System Description: PUMP 25% REDUCTION
Repair System Description: UP PANEL
Maintenance Agreement Required: ☐ Yes ☑ No


☑ House/Mod. Home No. Bedrooms 4
☐ Mobile Home No. Bathrooms 4
☐ Business No. Employees
☐ Other
☐ Slab ☑ Crawl Space ☑ Basement w/plumbing ☐ Basement wo/plumbing

Water Supply: ☐ Individual ☐ Public ☑ Community


Comments/Conditions: Reviewed Building plans & site plan essentially in Compliance with Improvement Permit.

Comments/Conditions: Checked tanks & upper 3 lines 11/4/05
Checked lower 2 lines 11/7/05.
EZ Flow installed

INITIAL SITE SKETCH 1" = 100'

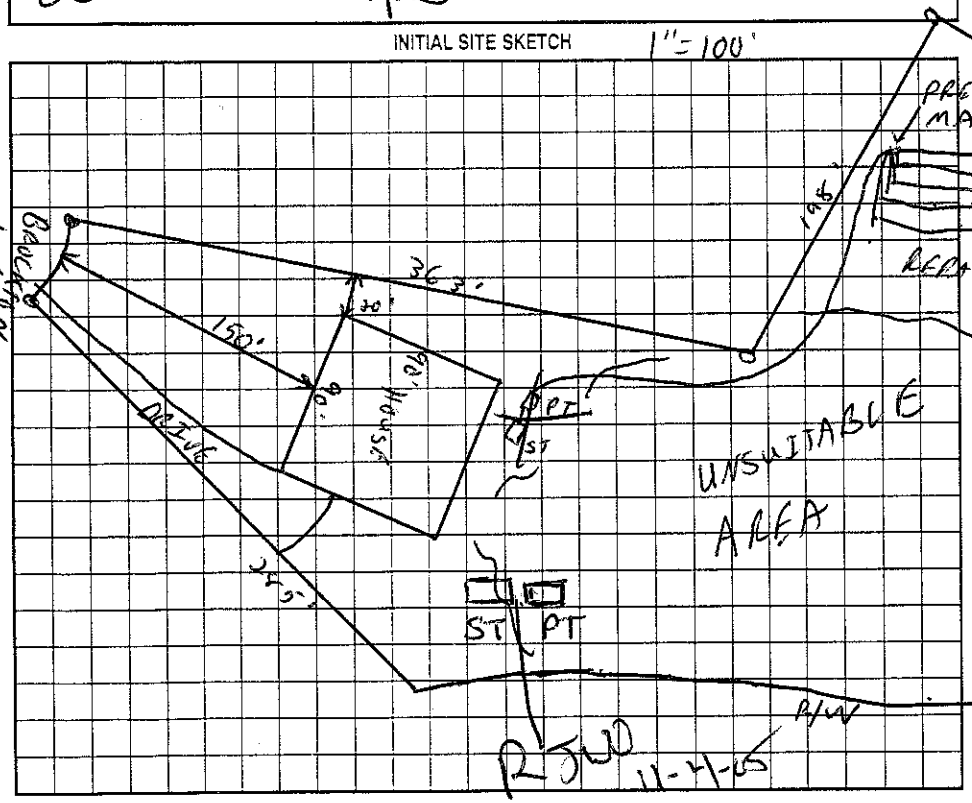

AS BUILT SKETCH

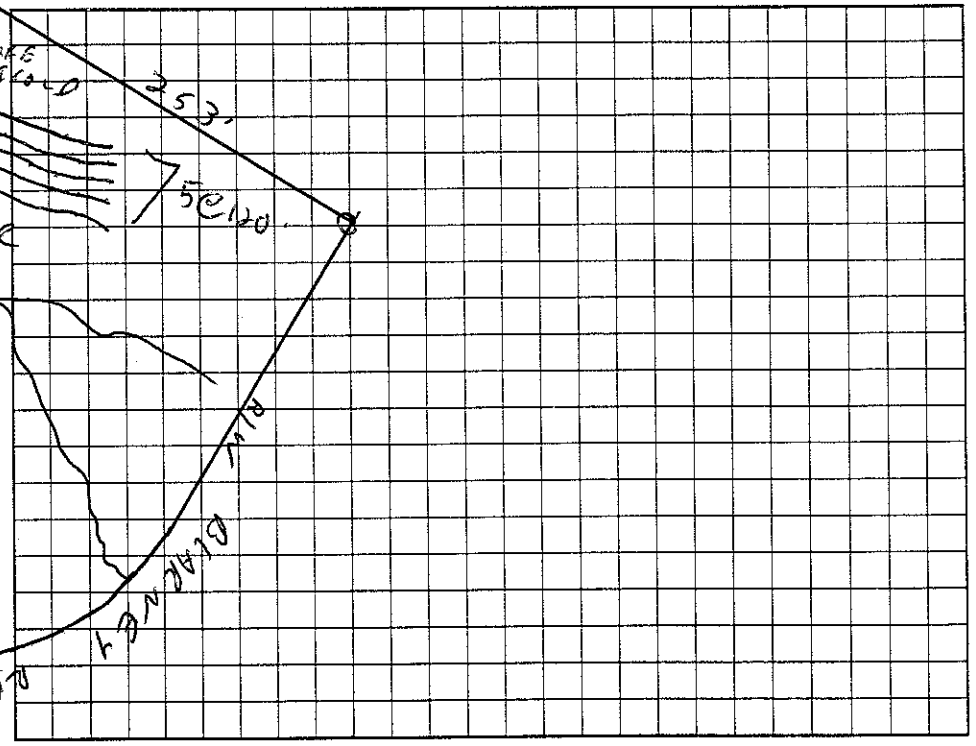

Permit can be suspended or revoked if any false information is supplied toward securing the permit/any unauthorized changes are made to the site/any unauthorized changes are made in the installation of the system. Improvement Permit with plat valid without expiration. Improvement Permit with site plan valid for sixty months. Authorization to Construct is valid for a period equal to that of Improvement Permit – not to exceed sixty months.

Signed: date 5-23-02 Installed by: R & H

Improvement Permit by: date 5/20/02 Operation Permit by: date 11/7/06

Authorization to Construct by: date 2/18/05 Existing System Inspection by: date

HEALTH DEPT. COPY: WHITE OWNER COPY (FINAL): YELLOW OWNER COPY (INITIAL): PINK