2:30

IREDELL COUNTY HEALTH DEPARTMENT

STATESVILLE 704-878-5305 MOORESVILLE 704-664-5281

IMPROVEMENT PERMIT / AUTHORIZATION TO CONSTRUCT / OPERATION PERMIT / EXISTING SYSTEM INSPECTION

PERMIT# 105477 PIN# 4624275905.975 4624274618 DATE 5/14/02

OWNER OR CONTRACTOR POINT ON NORMAN / Tom Stevenson PHONE: Business 660-1185 Home

ADDRESS 2214 BRAWLEY SCHOOL - MOORESVILLE NC 28117

LOCATION BRAWLEY SCHOOL - TR 2nd MANSFIELD - TL BROCKTON - AT END - RT CORNER OF DEDHAM.

SUBDIVISION POINT BLOCK / SECTION 9 LOT 975 LOT AREA 1.43AC SITE CLASS. RS DESIGN FLOW 480GPD L.T.A.R. .36PD/FT²

Septic Tank: 1000 + Gallons; STB 338 Date 5-15-05

Pump Tank: 1000 Gallons; PT 27 Date 12-11-04

Pump Make Goulds Model WE0312 Serial No.

Nitrification Field: No Fields 1 Square Feet 1200 Linear Feet 400

No Lines 4@100' Trench Width 36" Max Trench Bottom Depth 36" Gravel Depth N/A

☑ New System ☐ Repair System Type: I. II. (III) IV. V. VI

System Description: PUMP 25% REDUCTION

Repair System Description: SAME

Maintenance Agreement Required: ☐ Yes ☑ No

☑ House/Mod. Home No. Bedrooms 4

☐ Mobile Home No. Bathrooms 4

☐ Business No. Employees

☐ Other


☐ Slab ☑ Crawl Space ☐ Basement w/plumbing ☐ Basement wo/plumbing

Water Supply: ☐ Individual ☐ Public ☑ Community


Comments:/Conditions:

Comments:/Conditions: Reviewed Building plans & Site plan; in compliance with original permit. MW

INITIAL SITE SKETCH

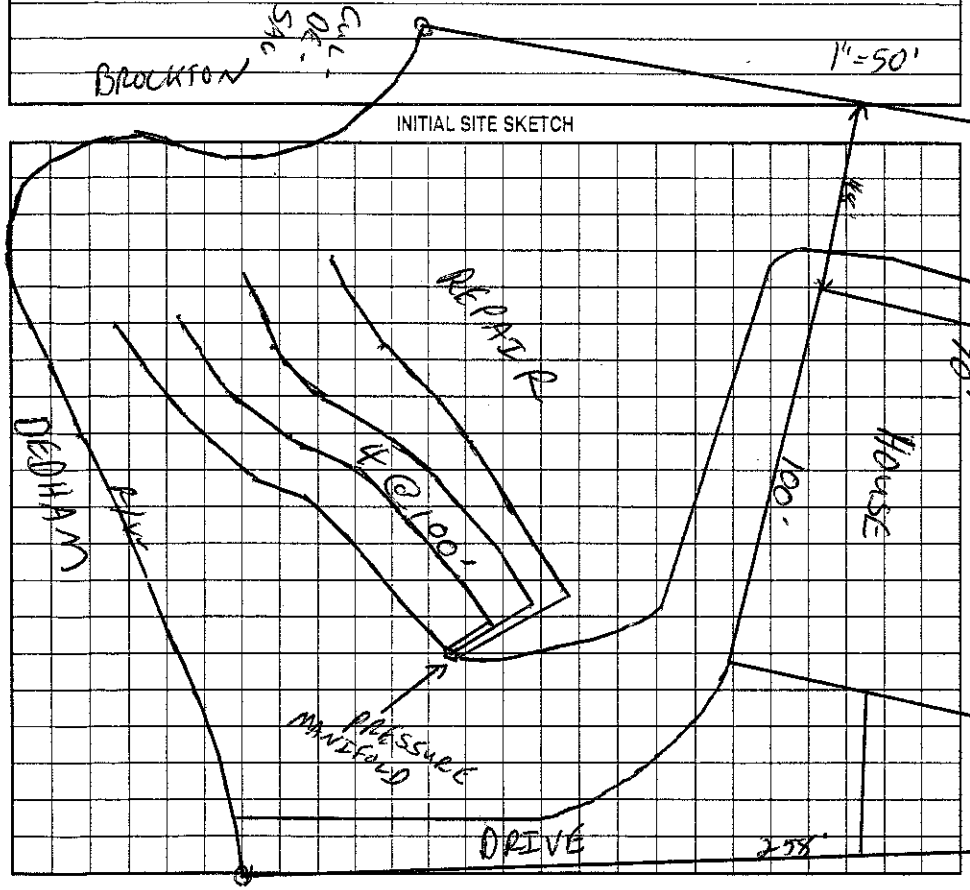

AS BUILT SKETCH

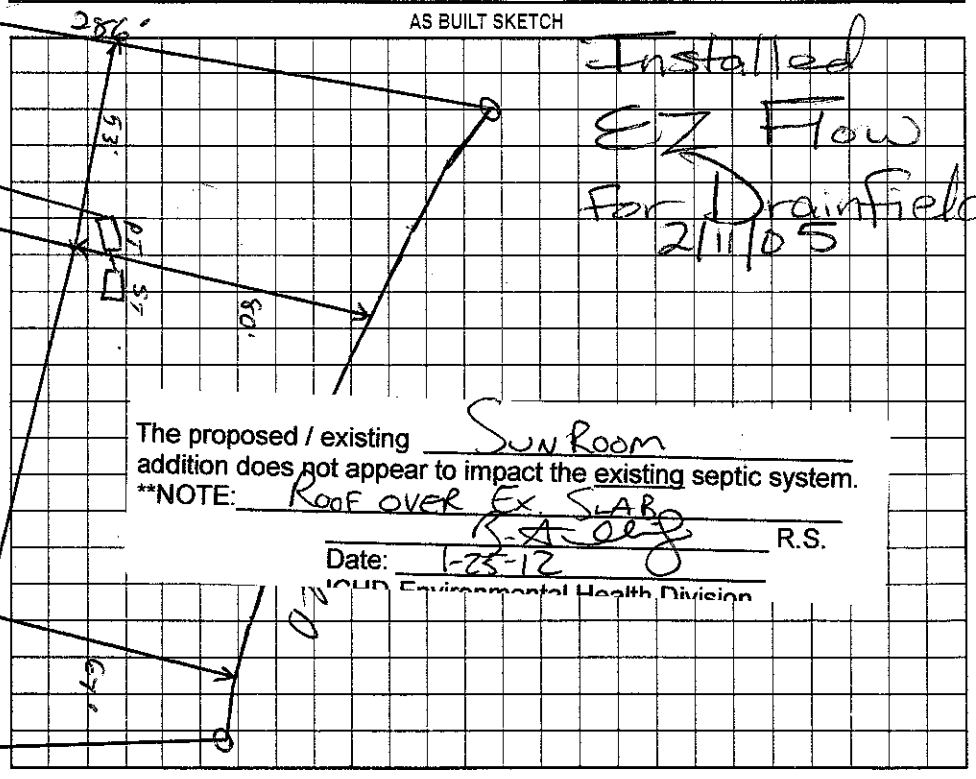

Installed EZ Flow For Drainfield 2/11/05

The proposed / existing Sun Room addition does not appear to impact the existing septic system.

**NOTE: Roof over Ex. Slab

R.S.

Date: 1-25-12

Iredell Environmental Health Division

Permit can be suspended or revoked if any false information is supplied toward securing the permit/any unauthorized changes are made to the site/any unauthorized changes are made in the installation of the system. Improvement Permit with plan valid without expiration. Improvement Permit with site plan valid for sixty months. Authorization to Construct is valid for a period equal to that of Improvement Permit – not to exceed sixty months.

Signed: [signature] date 5-23-02 Installed by: R&H RS

Improvement Permit by: [signature] RS date 5/14/02 Operation Permit by: [signature] RS date 9/22/05

Authorization to Construct by: [signature] RS date 10/20/04 Existing System Inspection by: date

HEALTH DEPT. COPY: WHITE OWNER COPY (FINAL): YELLOW OWNER COPY (INITIAL): PINK