IREDELL COUNTY HEALTH DEPARTMENT

STATESVILLE 704-878-5305 MOORESVILLE 704-664-5281

IMPROVEMENT PERMIT / AUTHORIZATION TO CONSTRUCT / OPERATION PERMIT / EXISTING SYSTEM INSPE...

PERMIT# 105489 PIN# 4624275905.981 Brent DATE 12/9/03

OWNER OR CONTRACTOR Hughes, Homelink & Zande PHONE: Business 363-6390 Home

ADDRESS 909 E Blvd Charlotte NC 28203

LOCATION Brawley School Rd TR 2nd Mansfield Tr Brockton TR Deelham 1st on Right-Corner lot

SUBDIVISION The Point BLOCK / SECTION 9 LOT 981 LOT AREA 1.16acre SITE CLASS. PS DESIGN FLOW 500gpd L.T.A.R. .3

Septic Tank: 1500 Gallons; STB 421 Date 10-28-03 ☒ New System ☐ Repair System Type: I, II, III, IV, V, VI

Pump Tank: 1500 Gallons; PT 421 Date 11-15-03 System Description: Pump-PM-25% Reduction

Pump Make: Goulds Model WE0712HH Serial No. B-11-03 Repair System Description: Same

Nitrification Field: No Fields 1 Square Feet 1500 Linear Feet 500 Maintenance Agreement Required: ☐ Yes ☒ No

No Lines 10 @ 25' Trench Width 36" Max Trench Bottom Depth 36" Gravel Depth N/A

☒ House/Mod. Home ☐ Mobile Home ☐ Business ☐ Other

No. Bedrooms 5 No. Bathrooms 5 No. Employees


☐ Slab ☐ Crawl Space ☒ Basement w/plumbing ☐ Basement wo/plumbing

Water Supply: ☐ Individual ☒ Public ☒ Community


Comments:/Conditions: Scale 1:40' PL 287'

~~Comments:/Conditions:~~ Keep Septic System 10' from PL & 15' from Proposed Pool Note: Pump set pressure 3 ft. ~~8 ft.~~ to 4 ft.

INITIAL SITE SKETCH

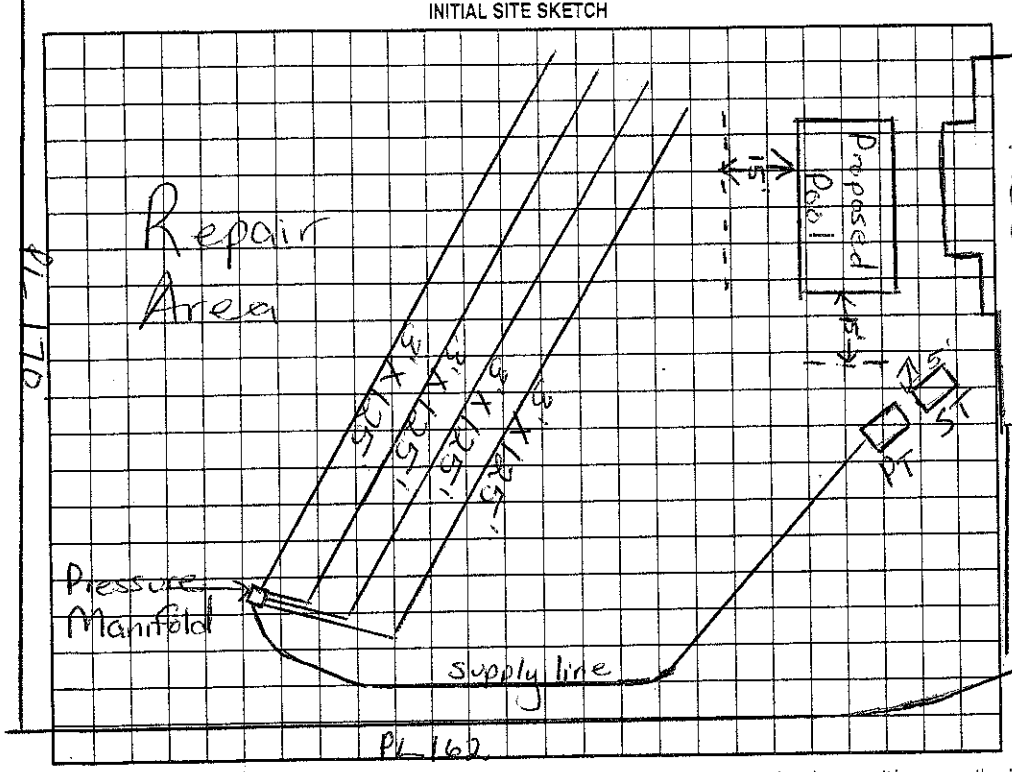

AS BUILT SKETCH

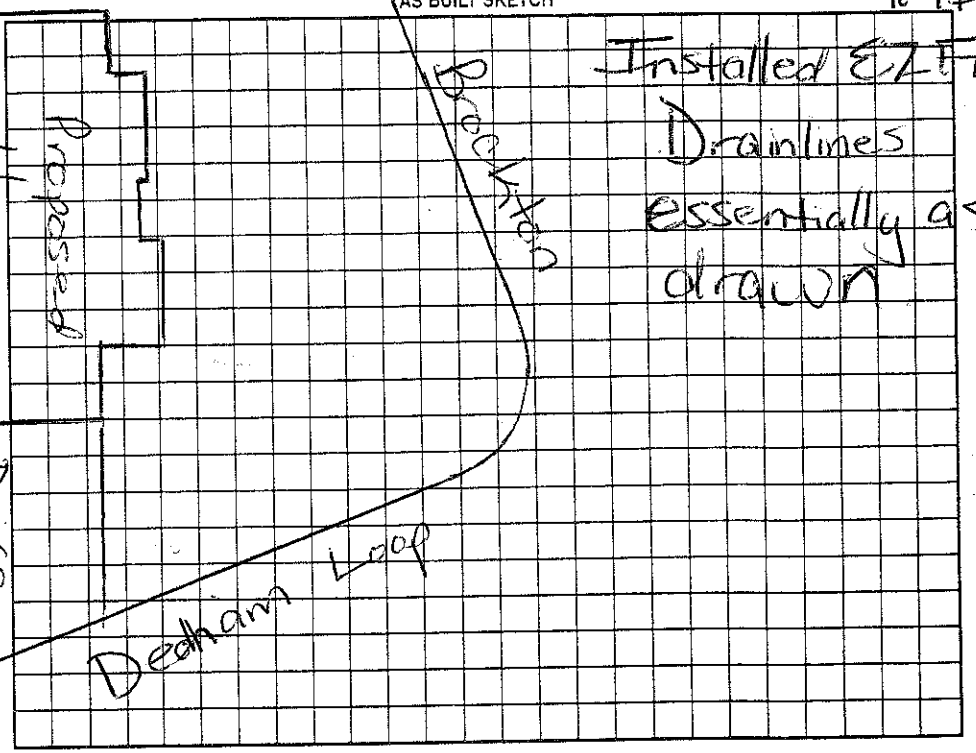

Permit can be suspended or revoked if any false information is supplied toward securing the permit/any unauthorized changes are made to the site/any unauthorized changes are made in the installation of the system. Improvement Permit with plat valid without expiration. Improvement Permit with site plan valid for sixty months. Authorization to Construct is valid for a period equal to that of Improvement Permit – not to exceed sixty months.

Signed: Tony Egan date 12-10-03 Installed by: Bobby Mayhew RS

Improvement Permit by: Maria H. Dalton RS date 12/9/03 Operation Permit by: Maria H. Dalton RS date 1/23/04

Authorization to Construct by: Maria H. Dalton RS date 12/9/03 Existing System Inspection by: date

HEALTH DEPT. COPY: WHITE OWNER COPY (FINAL): YELLOW OWNER COPY (INITIAL): PINK