IREDELL COUNTY HEALTH DEPARTMENT

STATESVILLE 704-878-5305 MOORESVILLE 704-664-5281

IMPROVEMENT PERMIT / AUTHORIZATION TO CONSTRUCT / OPERATION PERMIT / EXISTING SYSTEM INSPECTION

PERMIT# 105481 PIN# 4624 275905.977 4624276461 DATE 5/20/05

OWNER OR CONTRACTOR POINT ON NORMAN / HH2 PHONE: Business 660-1185 Home

ADDRESS 2214 BRANLEY SCHOOL RD MOORESVILLE 28117

LOCATION BRANLEY SCHOOL - TR 2nd MANSFIELD - TL BROCKTON - AT END

SUBDIVISION POINT BLOCK / SECTION 9 LOT 977 LOT AREA - SITE CLASS. PS DESIGN FLOW 480GPD L.T.A.R. N/A

Septic Tank: 1000 gal Gallons; STB 338 Date 8-9-05

Pump Tank: 1000 Gallons; PT 27 Date 8-9-05

Pump Make: Goulds Model WE0312 Serial No.

Nitrification Field: No Fields 1 Square Feet 1500 Linear Feet 500

No Lines 5@100' Trench Width 36" Max Trench Bottom Depth 36" Gravel Depth N/A

☑ New System ☐ Repair System Type: I, II, III, IV, V, VI

System Description: ~~GRAVITY~~ 25% REDUCTION

Repair System Description: PUMP LP PANEL

Maintenance Agreement Required: ☐ Yes ☑ No

☑ House/Mod. Home No. Bedrooms 3

☐ Mobile Home No. Bathrooms 4

☐ Business No. Employees

☐ Other


☐ Slab ☑ Crawl Space ☐ Basement w/plumbing ☐ Basement wo/plumbing

Water Supply: ☐ Individual ☐ Public ☑ Community

Comments:/Conditions: Reviewed Site plan & Building plans; in compliance with Improvement Permit.

Comments:/Conditions: Note: Must keep house as Shown in Improvement Permit do not move house any further back. Checked lines (EZ Flow) 9/15/05

INITIAL SITE SKETCH 1" = 100'

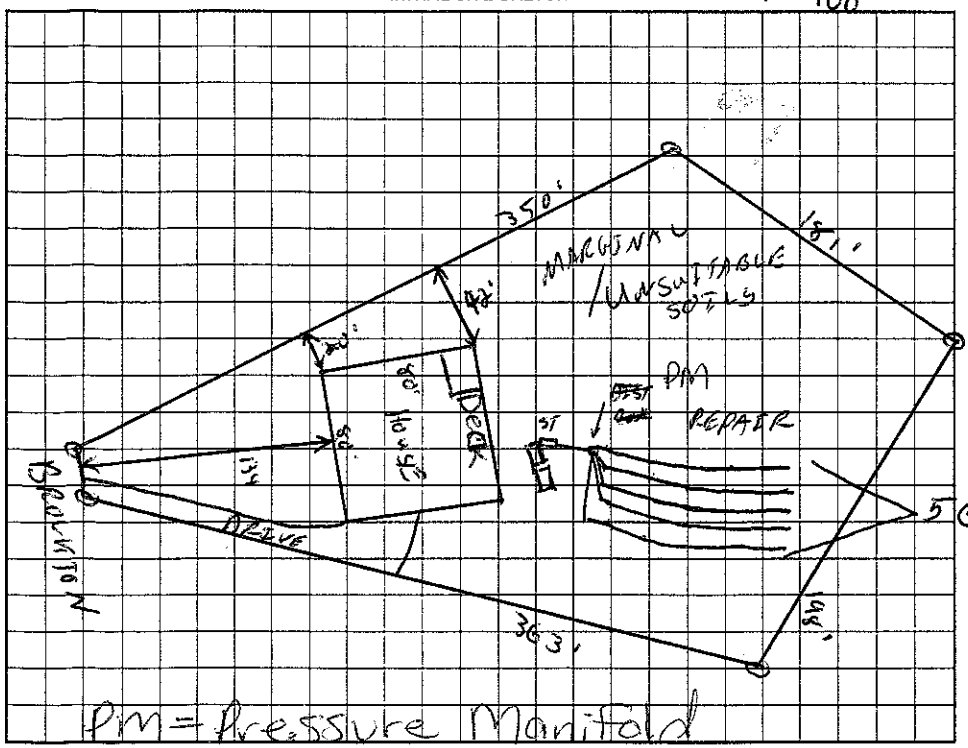

AS BUILT SKETCH

Pressure, float & alarm 12/12/05

Permit can be suspended or revoked if any false information is supplied toward securing the permit/any unauthorized changes are made to the site/any unauthorized changes are made in the installation of the system. Improvement Permit with plat valid without expiration. Improvement Permit with site plan valid for sixty months. Authorization to Construct is valid for a period equal to that of Improvement Permit – not to exceed sixty months.

Signed: [signature] date 5-23-05 Installed by: Bobby Mayberry

Improvement Permit by: [signature] KS date 5/20/05 Operation Permit by: [signature] date 12/12/05

Authorization to Construct by: [signature] date 4/27/05 Existing System Inspection by: date

HEALTH DEPT. COPY: WHITE OWNER COPY (FINAL): YELLOW OWNER COPY (INITIAL): PINK