IREDELL COUNTY HEALTH DEPARTMENT

STATESVILLE 704-878-5305 MOORESVILLE 704-664-5281

IMPROVEMENT PERMIT / AUTHORIZATION TO CONSTRUCT / OPERATION PERMIT / EXISTING SYSTEM INSPECTION

PERMIT# 105484 PIN# 4624275905.979 4624-27-7879 DATE 5/20/02

OWNER OR CONTRACTOR POINT ON NORMAN/Lake Norman Sign. PHONE: Business 660-1185 Home

ADDRESS 2214 BRAWLEY SCHOOL RD - MOORESVILLE NC 28117

LOCATION BRAWLEY SCHOOL - TR 2nd MANSFIELD - TL BROOKTON - 2nd ON LEFT

SUBDIVISION POINT BLOCK / SECTION 9 LOT 979 LOT AREA 1.41AC SITE CLASS. PS DESIGN FLOW 480GPD L.T.A.R. ~.25GPD/FT²

Septic Tank: ~~1000~~ 1500 Gallons; STB 444 Date 5/20/06

Pump Tank: 1000 Gallons; PT 27 Date 7/22/06

Pump Make: Gould's Model WE03512MU Serial No. E0666622

Nitrification Field: No Fields 1 Square Feet 1500 Linear Feet 500

No Lines 5@100' Trench Width 36" Max Trench Bottom Depth 36" Gravel Depth N/A

☑ New System ☐ Repair System Type: I, II, III, IV, V, VI

System Description: PUMP 25% REDUCTION

Repair System Description: LP PANEL

Maintenance Agreement Required: ☐ Yes ☑ No

☑ ~~House~~/Mod. Home ☐ Mobile Home ☐ Business ☐ Other

No. Bedrooms 4 No. Bathrooms 4 No. Employees


Water Supply: ☐ Individual ☐ Public ☑ ~~Community~~

☐ Slab ☑ Crawl Space ☐ Basement w/plumbing ☐ Basement wo/plumbing


Comments/Conditions: UNUSABLE AREA

Comments/Conditions: EZ FLOW INSTALLED

INITIAL SITE SKETCH

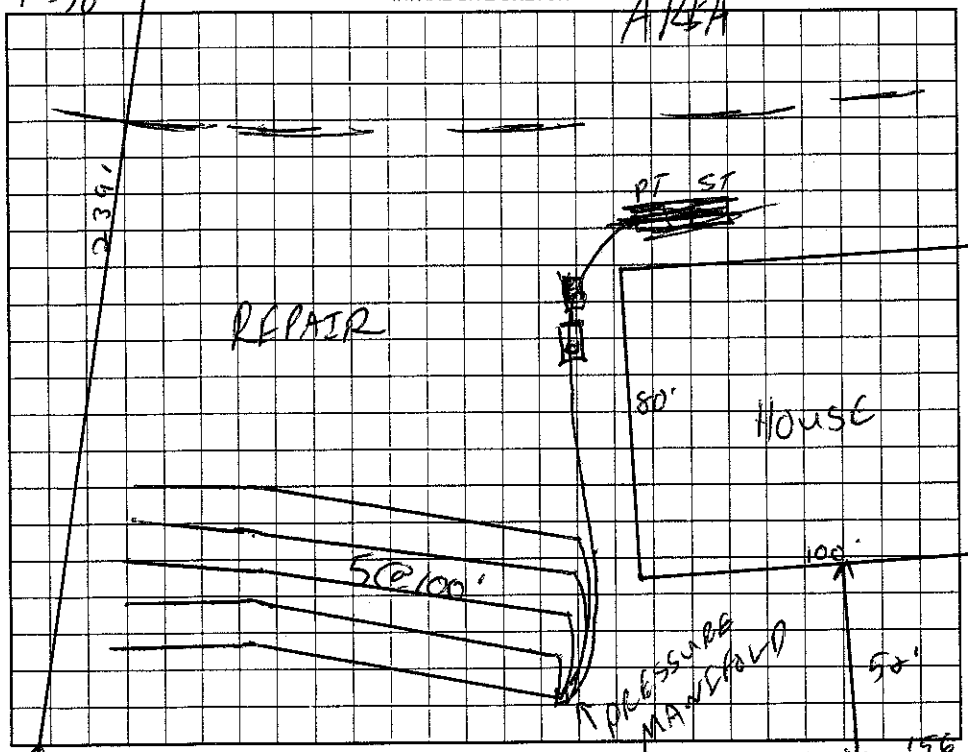

AS BUILT SKETCH

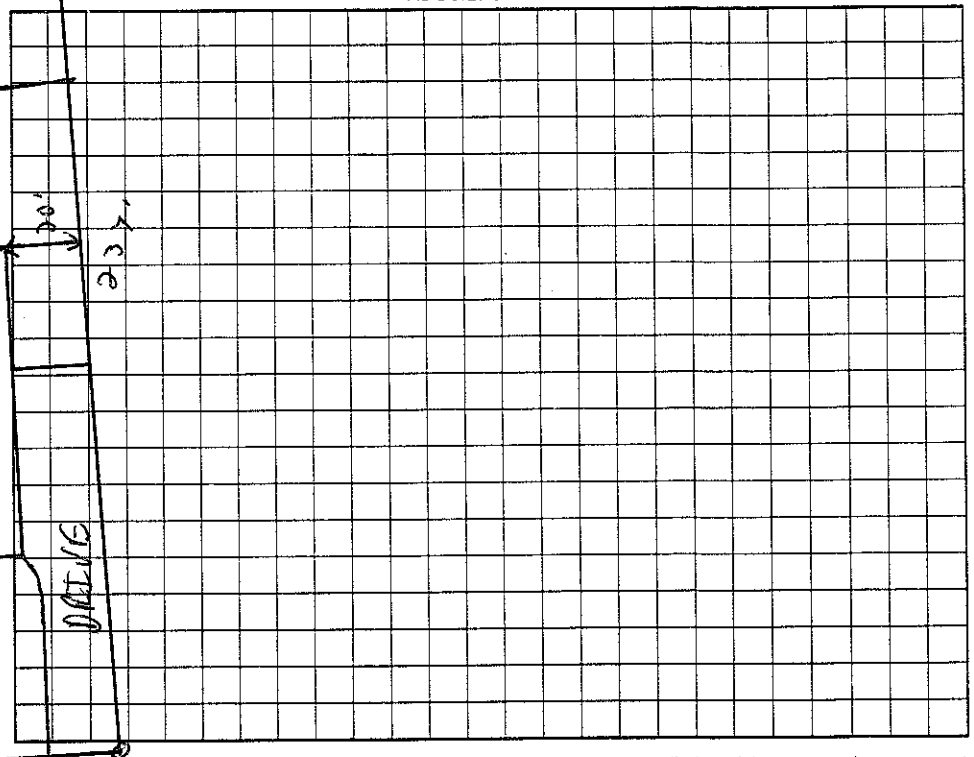

Permit can be suspended or revoked if any false information is supplied toward securing the permit, any unauthorized changes are made to the site/any unauthorized changes are made in the installation of the system. Improvement Permit with plat valid without expiration. Improvement Permit with site plan valid for sixty months. Authorization to Construct is valid for a period equal to that of Improvement Permit – not to exceed sixty months.

Signed: [signature] date 5-23-02 Installed by: Hallman

Improvement Permit by: C. [signature] RS date 5/20/02 Operation Permit by: [signature] RS date 10/30/06

Authorization to Construct by: [signature] RS date 12/20/05 Existing System Inspection by: date

HEALTH DEPT. COPY: WHITE OWNER COPY (FINAL): YELLOW OWNER COPY (INITIAL): PINK