4624 278291 Brian Jones 980 25.

IREDELL COUNTY HEALTH DEPARTMENT

STATESVILLE 704-878-5305 MOORESVILLE 704-664-5281

IMPROVEMENT PERMIT / AUTHORIZATION TO CONSTRUCT / OPERATION PERMIT / EXISTING SYSTEM INSPECTION

PERMIT # 125025 PIN # ~~4624362585.001~~ DATE 1-25-2011

OWNER or APPLICANT E S Johnson PHONE: Business John Wakefield 704 201-2158 Home:

OWNER or APPLICANT ADDRESS P.O. Box 1402 Cornelius 28031

LOCATION / DIRECTIONS Brawley School Rd TR Bunker Way on RT Corner

SUBDIVISION The Pointy BLOCK / SECTION 10 LOT # 100A LOT AREA .842Ac DESIGN FLOW 480gpd L.T.A.R. 3

Septic Tank 1000 Gallons: STB 338 Date 12-21-10

Pump Tank 1500 Gallons: P T Date

Pump Make Model Serial #

Nitrification Field No Fields 1 No Lines 4 Linear Feet 400'

Trench Width 36" Max. Trench Bottom Depth 36" Gravel Depth N/A

☒ New System ☐ Repair ☐ Expansion System Type I II III IV V VI

System Description: Gravity -25% Reduction

Repair System Description: Pump LP Panel Blk

Maintenance Agreement Required ☐ YES ☒ NO Not Initially

☒ GRAVITY ☐ PRESSURE


☒ Residence No. Bedrooms 4 ☐ Business No. Persons ☐ Other No. Employees ☐ Slab ☐ Crawl Space ☐ Basement w/plumbing ☐ Basement w/o plumbing

Water Supply ☐ Private ☒ Public ☒ Community


Comments / Conditions Must keep Septic System at least 10Ft From PL & out of Easement (Including Repair Area)

Comments / Conditions 2/15/11 OK to move ST back 10Ft.

INITIAL SITE SKETCH

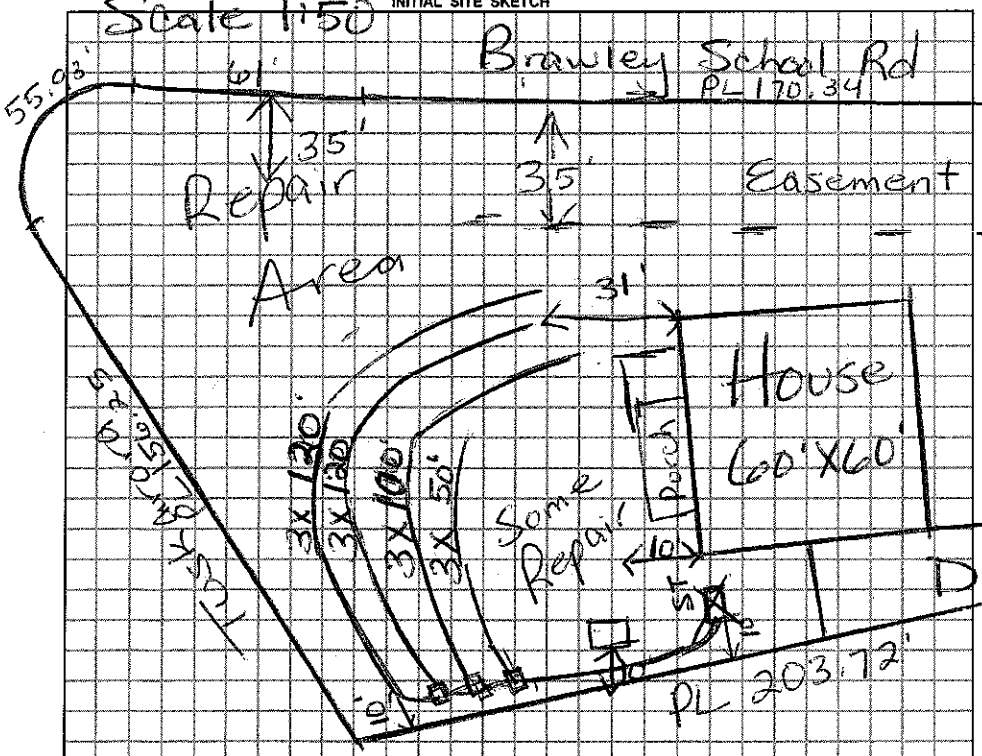

AS BUILT SKETCH

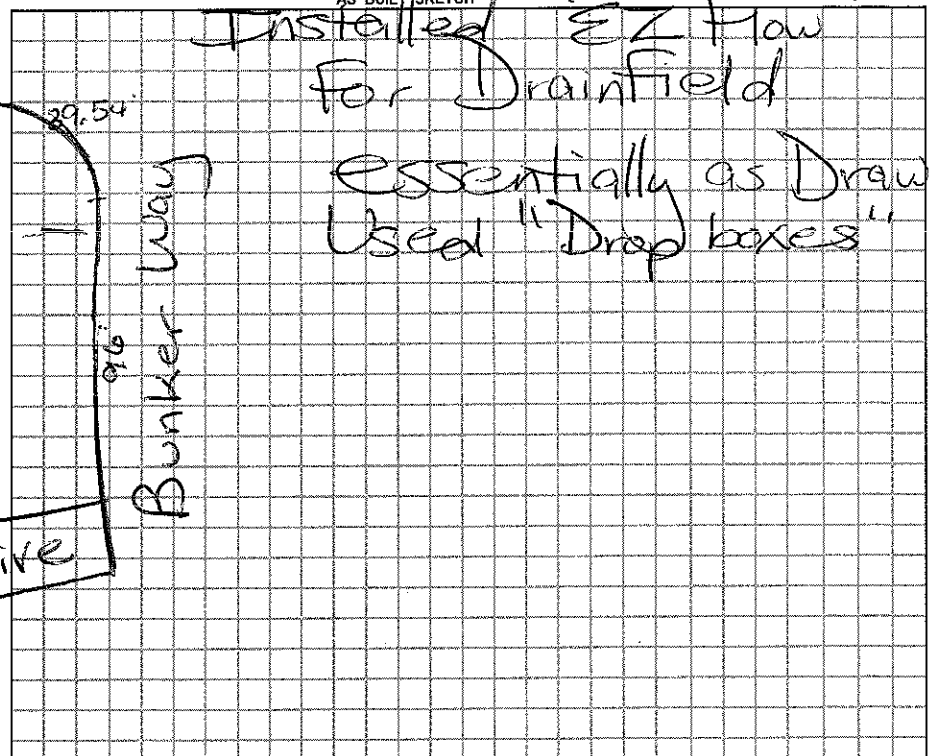

Permit can be suspended or revoked if any false information is supplied toward securing the permit / any unauthorized changes are made to the site / any unauthorized changes are made in the installation of the system.

☐ *IMPROVEMENT PERMIT w / plat valid without expiration* ☐ *IMPROVEMENT PERMIT w / site plan valid for 60 mos.* ☐ *AUTHORIZATION TO CONSTRUCT valid for period equal to IMPROVEMENT PERMIT-not to exceed 60 mo.*

Owner / Applicant Signature: Date 1-26-11

Improvement Permit by: Marian H. Olson REHS Date 1/25/11

Authorization to Construct by: Marian H. Olson REHS Date 1/25/11

Installed by: Willie Christenbury

Operation Permit by: Marian H. Olson Date: 2/16/2011

Existing System Inspected by: Date:

YOU SHOULD CONTACT A LOCATOR SERVICE PRIOR TO ANY EXCAVATION.

WHITE COPY Environmental Health YELLOW COPY (Final) Owner / Applicant PINK COPY (Initial) Owner / Applicant