...DELL COUNTY HEALTH DEPARTMENT

...PROVEMENT PERMIT / AUTHORIZATION TO CONSTRUCT / OPERATION PERMIT / EXISTING SYSTEM INSPECTION

STATESVILLE ...018-5305 50.00 Paid MOORESVILLE 704-664-5281 11:05

PERMIT# 105464 / 105466 PIN# 4624-27-5705.970 4624 28 0340

OWNER OR CONTRACTOR Mooring, Bldrs Charlotte NC 28202 PHONE: Business 704 201-8776 Home DATE 7/29/04

ADDRESS 801 E. Morehead St

LOCATION BSR TR 2nd Mansfield Tr Brockton TR 2nd Dedham 6th on Lt

SUBDIVISION Point BLOCK / SECTION Q LOT 970 LOT AREA 1.06 Ac SITE CLASS. PS

Septic Tank: 1000+ Gallons: STB 338 Date 12-7-04

Pump Tank: Gallons; PT Date

Pump Make: Model Serial No.

Nitrification Field: No Fields 1 Square Feet 1440 Linear Feet 480

No Lines 8@60' Trench Width 36" Max Trench Bottom Depth 36

Comments:/Conditions: Flow Divider to 2 D-Boxes

☒ New System ☐ Repair System Type: I II III IV V VI

System Description: Gravity 25% Reduct.

Repair System Description: 24" Panel Block

Maintenance Agreement Required: ☐ Yes ☒ No

Gravel Depth —

☐ Slab ☒ Crawl Space ☐ Basement w/plumbing ☐ Basement wo/plumbing

DESIGN FLOW 480 L.T.A.R. 0.25


☒ House/Mod. Home ☐ Mobile Home ☐ Business ☐ Other

No. Bedrooms 4 No. Bathrooms 4 No. Employees —


Water Supply: ☐ Individual ☐ Public ☒ Community

Comments:/Conditions: Checked tank & 7 of 8 lines 11/9/05
Checked last line 1/20/05 MS

INITIAL SITE SKETCH

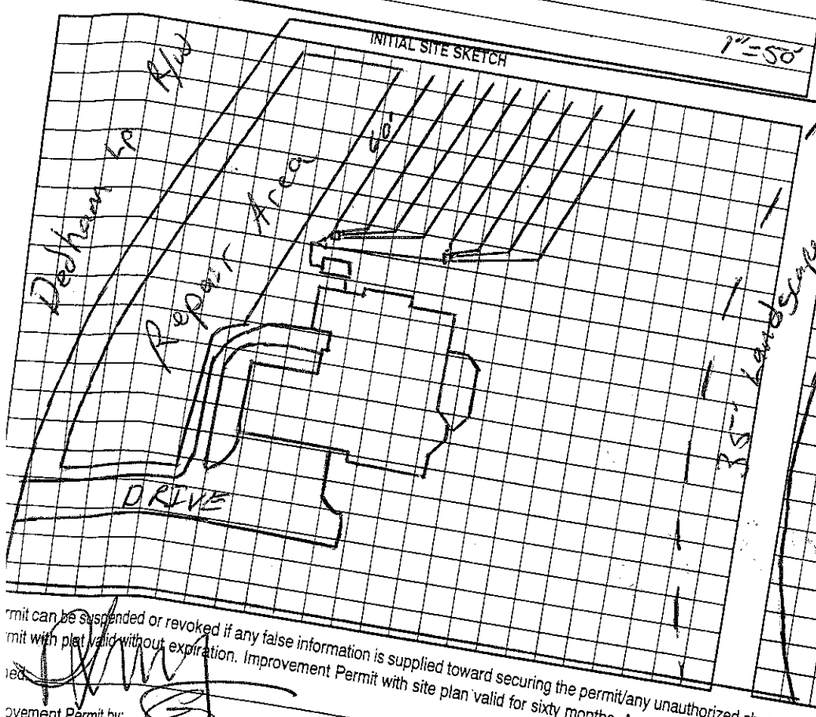

AS BUILT SKETCH

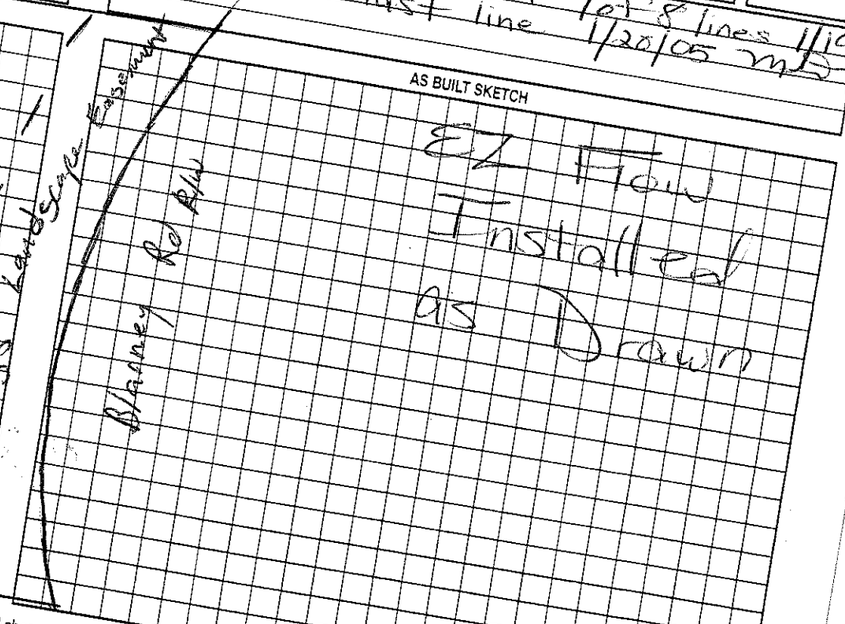

...rmit can be suspended or revoked if any false information is supplied toward securing the permit/any unauthorized changes are made to the site/any unauthorized changes are made in the installation of the system. Improvement ...rmit with plat valid without expiration. Improvement Permit with site plan valid for sixty months. Authorization to Construct is valid for a period equal to that of Improvement Permit – not to exceed sixty months.

...ovement Permit by: date 9-17-04

...rization to Construct by: date 7/29/04

Installed by: R&I RS

Operation Permit by: date 7/29/04

Existing System Inspection by: date 1/20/05

HEALTH DEPT. COPY: WHITE OWNER COPY (FINAL): YELLOW OWNER COPY (INITIAL): PINK