IREDELL COUNTY HEALTH DEPARTMENT

STATESVILLE 704-878-5305 MOORESVILLE 704-664-5281

IMPROVEMENT PERMIT / AUTHORIZATION TO CONSTRUCT / OPERATION PERMIT / EXISTING SYSTEM INSPECTION

PERMIT# 105463 PIN# ~~4624 27 5905 969~~ Zone 4624-28-0447 DATE 5/13/02

OWNER OR CONTRACTOR POINT ON NORMAN / Hughes, Hamelinke PHONE: Business 660-1185 Home

ADDRESS 2214 BRAWLEY SCHOOL MOORESVILLE NC 28117

LOCATION BRAWLEY SCHOOL - TR 2nd MANSFIELD - TL BROCKTON - TR 2nd DEDHAM - 7th ON LT #190

SUBDIVISION POINT BLOCK / SECTION 9 LOT 969 LOT AREA 1.83AC SITE CLASS. PS DESIGN FLOW 480GPD L.T.A.R. .2 gal/ft²

Septic Tank: ~~1000~~ 1500 Gallons: STB 338 Date 4/20/03

Pump Tank: 1000+ Gallons: PT 27 Date 3/22/03

Pump Make: Goulds Model 1PLWE03 Serial No S0357094

Nitrification Field: No Fields 1 Square Feet 800 Linear Feet 400

No Lines 4@100' Trench Width 24-36" Max Trench Bottom Depth 36" Gravel Depth N/A

☑ New System ☐ Repair System Type: I, II, III, (IV), V, VI

System Description: LP PANEL

Repair System Description: SAME

Maintenance Agreement Required: ☑ Yes ☐ No

☑ House/Mod. Home No. Bedrooms 4

☐ Mobile Home No. Bathrooms 4

☐ Business No. Employees

☐ Other

☐ Slab ☐ Crawl Space ☑ Basement w/plumbing ☐ Basement wo/plumbing

Water Supply: ☐ Individual ☐ Public ☐ Community

Comments/Conditions: INLINE PUMP FILTER TO BE INSTALLED


Reviewed plans 11/15/2002 essentially in Compliance with original Septic permit.

Comments/Conditions: ~~2 gutter or~~ Foundation drains emptying onto drainfield, needs to be relocated--okay 6/25/03

Checked lines & tanks 6/13/03 MD


Pressure, elect & alarm checked 6/20/03

INITIAL SITE SKETCH 1" = 50'

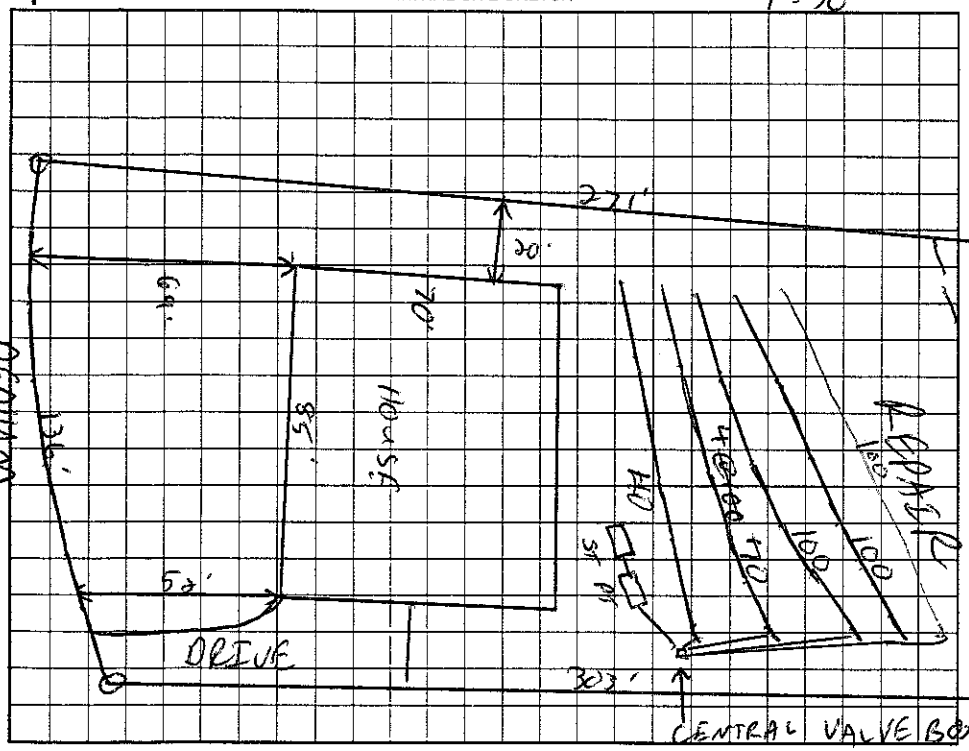

AS BUILT SKETCH

Installed 5 panel lines

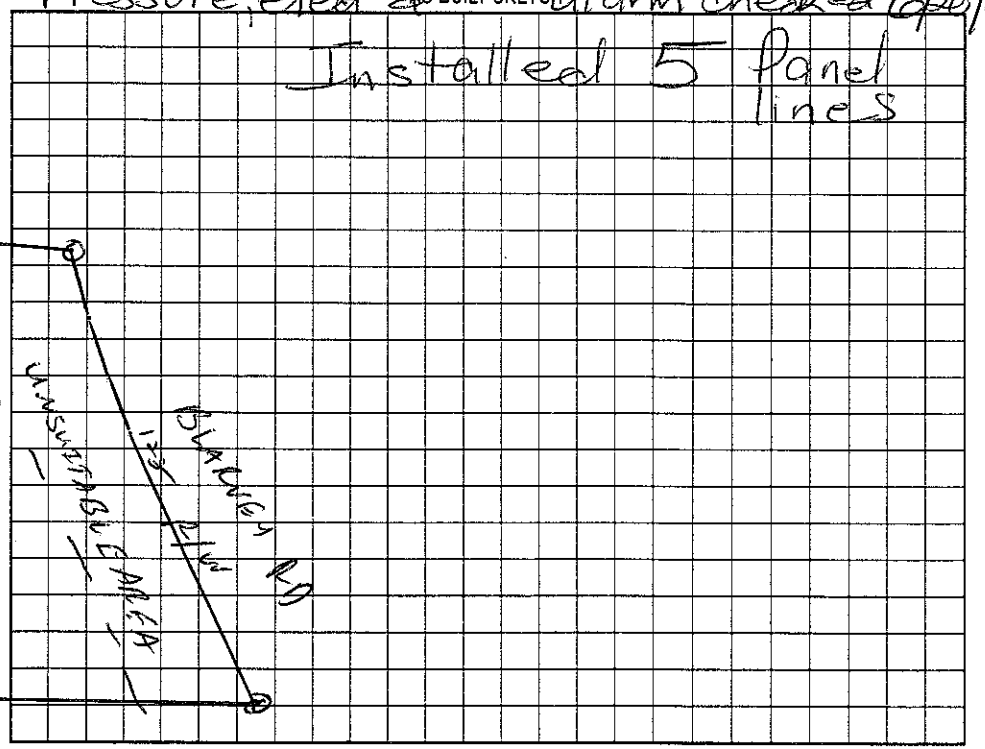

Permit ~~can be suspended~~ or revoked if any false information is supplied toward securing the permit/any unauthorized changes are made to the site/any unauthorized changes are made in the installation of the system. Improvement Permit with plat valid without expiration. Improvement Permit with site plan valid for sixty months. Authorization to Construct is valid for a period equal to that of Improvement Permit – not to exceed sixty months.

Signed: _____ date 5-23-02 Installed by: Bobby Mayhew

Improvement Permit by: _____ RS date 5/13/02 Operation Permit by: _____ RS date 6/25/03

Authorization to Construct by: _____ RS date 11/15/02 Existing System Inspection by: _____ date _____

HEALTH DEPT. COPY: WHITE OWNER COPY (FINAL): YELLOW OWNER COPY (INITIAL): PINK