IREDELL COUNTY HEALTH DEPARTMENT

STATESVILLE 704-878-5305 MOORESVILLE 704-664-5281

IMPROVEMENT PERMIT / AUTHORIZATION TO CONSTRUCT / OPERATION PERMIT / EXISTING SYSTEM INSPECTION

PERMIT# 105493 PIN# 4624 27 5905, 990 Zande 4624 28 2174 Charlie DATE 5/20/02

OWNER OR CONTRACTOR POINT ON NORMAN / Hughes, Hamelink PHONE: Business 660-1185 Home 363-8762

ADDRESS 2214 BRAWLEY SCHOOL RD MOORESVILLE NC 28117

LOCATION BRAWLEY SCHOOL - TR 2nd MANSFEELD - TL BROCKTON - TL 2nd OEDHAM - 2nd ON RT

SUBDIVISION POINT BLOCK / SECTION 9 LOT 990 LOT AREA 1.16AC SITE CLASS. PS DESIGN FLOW 360GPD L.T.A.R. .25 3x4/4A=

Septic Tank: 1000T Gallons; STB 338 Date 9-21-03

Pump Tank: 1500 Gallons; PT _____ Date _____

Pump Make: _____ Model _____ Serial No. _____

Nitrification Field: No Fields 1 Square Feet 1440 Linear Feet 480

No Lines 4@120' Trench Width 36" Max Trench Bottom Depth 36" Gravel Depth N/A

☑ New System ☐ Repair System Type: I, II, III, IV, V, VI

System Description: GRAVITY 25% REDUCTION

Repair System Description: _____

Maintenance Agreement Required: ☐ Yes ☑ No

☐ House/Mod. Home No. Bedrooms 4

☐ Mobile Home No. Bathrooms 4

☐ Business No. Employees _____

☐ Other _____


☐ Slab ☐ Crawl Space ☐ Basement w/plumbing ☐ Basement wo/plumbing

Water Supply: ☐ Individual ☐ Public ☑ Community


Comments/Conditions: Reviewed House plans 6/3/03; essentially in compliance with original permit. House sits further back, however not as deep as original houseprint.

Comments/Conditions: Note: Study has "Cased entry" & no closet.

INITIAL SITE SKETCH 1"=50'

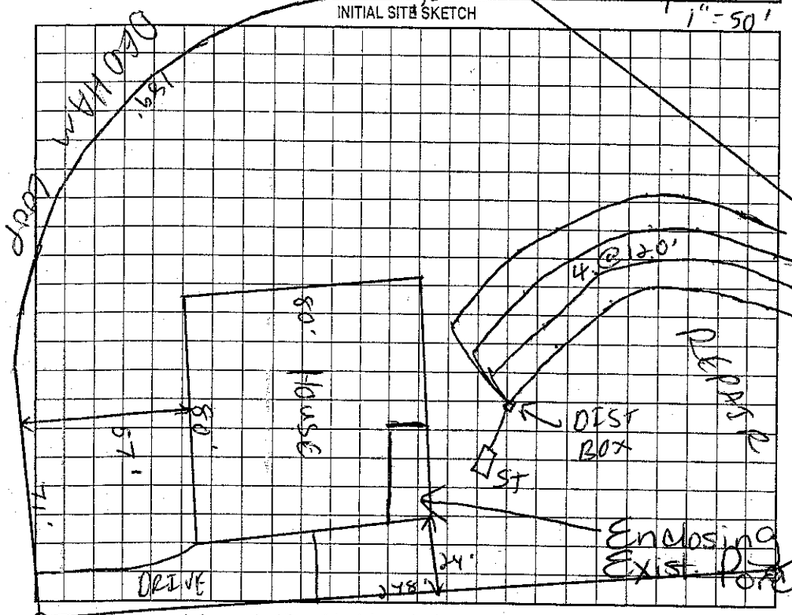

AS BUILT SKETCH

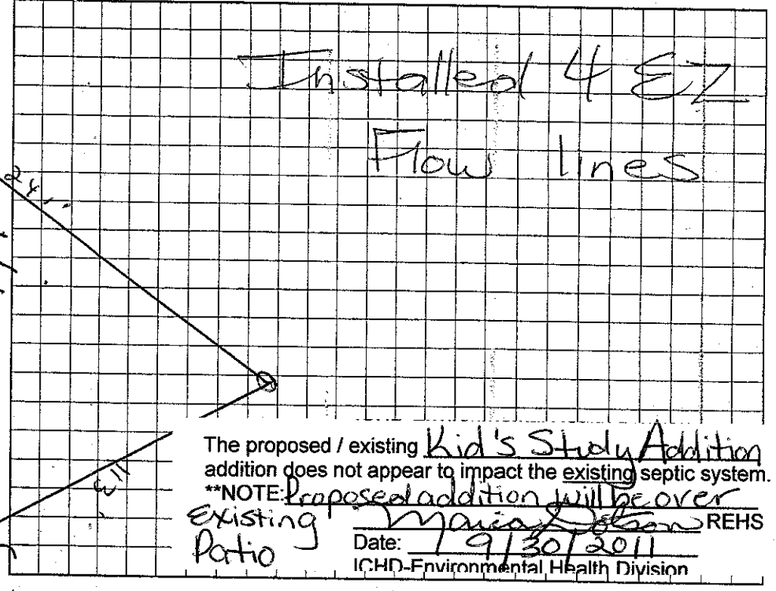

The proposed / existing Kid's Study Addition addition does not appear to impact the existing septic system.

**NOTE: Proposed addition will be over

Maria W. Johnson REHS

Date: 9/30/2011

ICHD-Environmental Health Division

Permit can be suspended or revoked if any false information is supplied toward securing the permit/any unauthorized changes are made to the site/any unauthorized changes are made in the installation of the system. Improvement Permit with plat valid without expiration. Improvement Permit with site plan valid for sixty months. Authorization to Construct is valid for a period equal to that of Improvement Permit - not to exceed sixty months.

Signed: _____ date _____ Installed by: Bobby Mayhew RS

Improvement Permit by: _____ RS date 5/20/02

Operation Permit by: Maria W. Johnson date 11/12/03