IREDELL COUNTY HEALTH DEPARTMENT

STATESVILLE 704-878-5305 MOORESVILLE 704-664-5281

IMPROVEMENT PERMIT / AUTHORIZATION TO CONSTRUCT / OPERATION PERMIT / EXISTING SYSTEM INSPECTION

PERMIT# 105493 PIN# 4624 27 5905, 990 Zone 4624 28 2174 Charlie DATE 5/20/02

OWNER OR CONTRACTOR POINT ON NORMAN / Hughes, Hamelink PHONE: Business 660-1155 Home 363-8762

ADDRESS 2214 BRAWLEY SCHOOL RD. MOORESVILLE NC 28117

LOCATION BRAWLEY SCHOOL - TR 2nd MANSFIELD - TL BROUGHTON - TL 2nd DEDHAM - 2nd ON RT

SUBDIVISION POINT BLOCK / SECTION 9 LOT 9 90 LOT AREA 1.16AC SITE CLASS. PS DESIGN FLOW 480GPD L.T.A.R. .25 gpd/SF

Septic Tank: 1000T Gallons; STB 338 Date 9-21-03

Pump Tank: 1500 Gallons; PT Date

Pump Make: Model Serial No.

Nitrification Field: No Fields 1 Square Feet 1440 Linear Feet 480

No Lines 4@120' Trench Width 36" Max Trench Bottom Depth 36" Gravel Depth N/A

☑ New System ☐ Repair System Type: I. II. III. IV. V. VI

System Description: GRAVITY 25% REDUCTION

Repair System Description: COPANEL

Maintenance Agreement Required: ☐ Yes ☑ No

☑ House/Mod. Home No. Bedrooms 4

☐ Mobile Home No. Bathrooms 4

☐ Business No. Employees

☐ Other

☐ Slab ☑ Crawl Space ☐ Basement w/plumbing ☐ Basement wo/plumbing


Water Supply: ☐ Individual ☐ Public ☑ Community

Comments:/Conditions: Reviewed House plans 6/3/03: essentially in compliance with original permit. House sits further back, however not as deep as original houseprint.


Comments:/Conditions: Note: Study has "cased entry" & no closet.

4/9/13 Needs some fill were drainlines settled

INITIAL SITE SKETCH

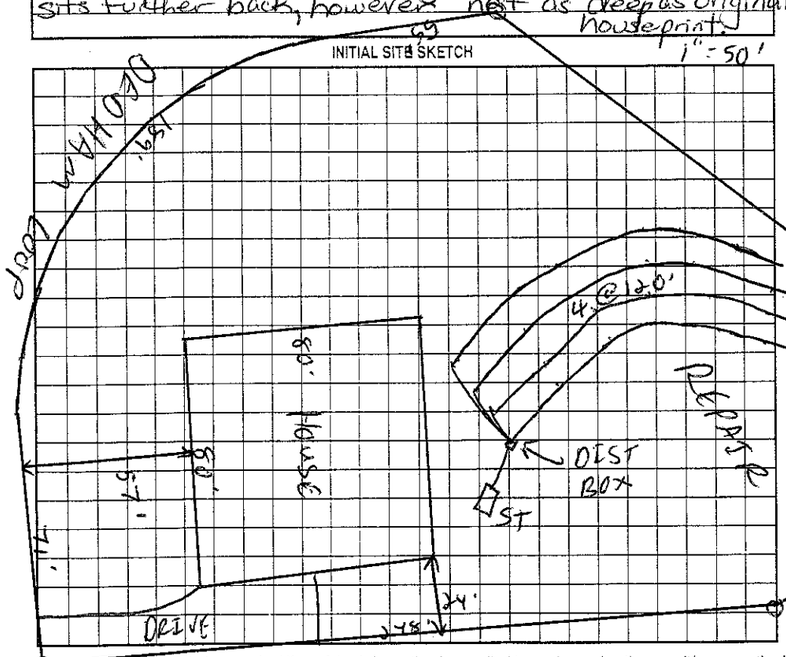

AS BUILT SKETCH

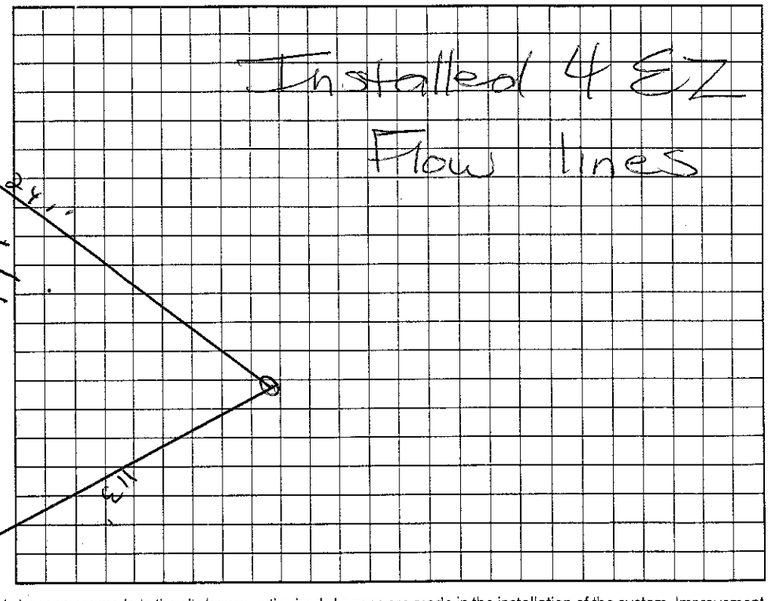

Permit can be suspended or revoked if any false information is supplied toward securing the permit/any unauthorized changes are made to the site/any unauthorized changes are made in the installation of the system. Improvement Permit with plat valid without expiration. Improvement Permit with site plan valid for sixty months. Authorization to Construct is valid for a period equal to that of Improvement Permit - not to exceed sixty months.

Signed: date 5-20-02 Installed by: Bobby Mayhew R.S.

Improvement Permit by: C. [illegible] R.S. date 5/20/02 Operation Permit by: Maria H. Hodgson date 11/12/03

Authorization to Construct by: Maria H. Hodgson R.S. date 6/3/03 Existing System Inspection by: date

HEALTH DEPT. COPY: WHITE OWNER COPY (FINAL): YELLOW OWNER COPY (INITIAL): PINK