IREDELL COUNTY HEALTH DEPARTMENT

STATESVILLE 704-878-5305 50.00 Paid MOORESVILLE 704-664-5281

IMPROVEMENT PERMIT / AUTHORIZATION TO CONSTRUCT / OPERATION PERMIT / EXISTING SYSTEM INSPECTION

PERMIT# 105501 PIN# 4624 27 5905.988 4624 28 2948 DATE 8/14/03

OWNER OR CONTRACTOR Kenneth Becker Homes PHONE: Business 704-662-6400 Home

ADDRESS PO Box 3398 Mooresville, NC 28117

LOCATION 1100 TR 2nd Mansfield Tr Brockton TR 1st Dedham Circle on (L) in big Curve

SUBDIVISION Point BLOCK / SECTION 9 LOT 988 LOT AREA 1.17 Ac SITE CLASS. PS DESIGN FLOW 480 L.T.A.R. .25

Septic Tank: 1500 Gallons; STB 338 Date 3/2/04

Pump Tank: Gallons; PT Date

Pump Make: Model Serial No.

Nitrification Field: No Fields 1 Square Feet 1440 Linear Feet 490

No Lines 5@100 Trench Width 3' Max Trench Bottom Depth 3' Gravel Depth N/A

[X] New System [ ] Repair System Type: I, II, (III) IV, V, VI

System Description: GRAVITY - 25% Reduced

Repair System Description: 16" PABPS

Maintenance Agreement Required: [ ] Yes [X] No

[X] House/Mod. Home No. Bedrooms 4

[ ] Mobile Home No. Bathrooms 3.5

[ ] Business No. Employees

[ ] Other


[ ] Slab [X] Crawl Space [ ] Basement w/plumbing [ ] Basement wo/plumbing

Water Supply: [ ] Individual [ ] Public [X] Community


Comments:/Conditions (1" = 50')

Comments:/Conditions:

INITIAL SITE SKETCH

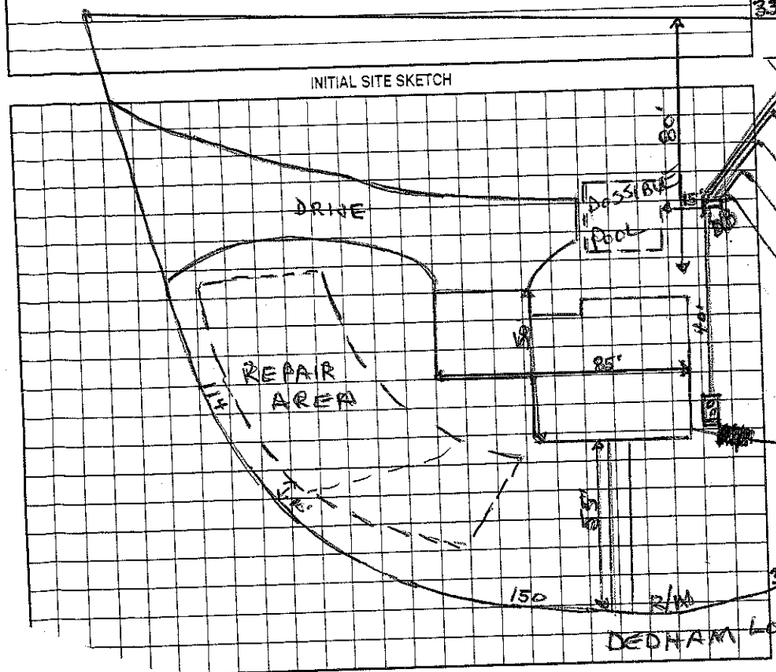

AS BUILT SKETCH

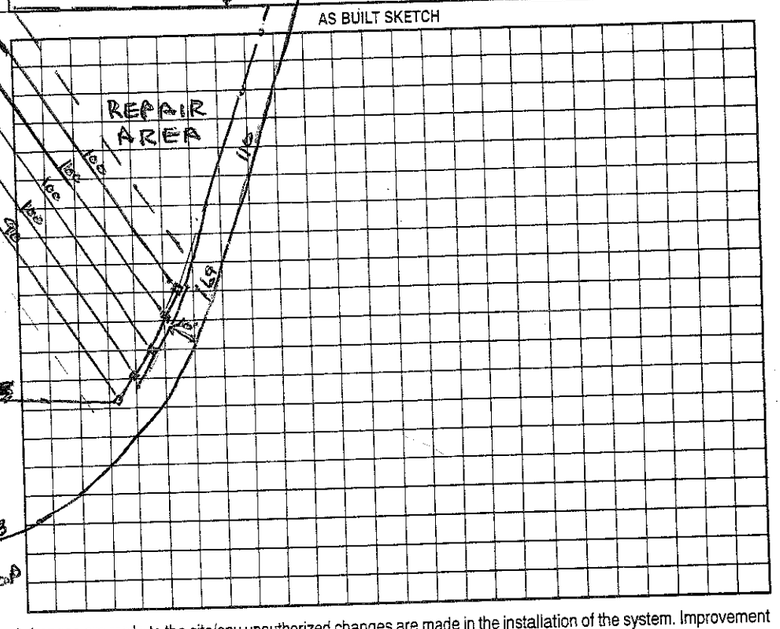

Revoked if any false information is supplied toward securing the permit/any unauthorized changes are made to the site/any unauthorized changes are made in the installation of the system. Improvement Permit with site plan valid for sixty months. Authorization to Construct is valid for a period equal to that of Improvement Permit – not to exceed sixty months.

E.S. date 8/15/03

date 8/15/03

date 8/15/03

Installed by: Hallman Const. Inc.

Operation Permit by: Wesley Sparks R.S. date 4/16/04

Existing System Inspection by: date

OWNER COPY (FINAL): YELLOW OWNER COPY (INITIAL): PINK