IREDELL COUNTY HEALTH DEPARTMENT

STATESVILLE 704-878-5305 MOORESVILLE 704-664-5281

IMPROVEMENT PERMIT / AUTHORIZATION TO CONSTRUCT / OPERATION PERMIT / EXISTING SYSTEM INSPECTION

1115 #480

PERMIT# 105502 / 108603 PIN# 4624 27 5905.989 4624-28-3327 DATE 5/21/02

OWNER OR CONTRACTOR ~~POINT OF NORMAN~~ (HUGHES, MAMELINK, ZANDE) Business 660-1185 Home

ADDRESS 2214 BRAWLEY SCHOOL - MOORESVILLE 28117

LOCATION BRAWLEY SCHOOL - TR 2nd MANSFIELD - TL BROCKTON - TR 2nd DEDHAM - 3RD ON RT.

SUBDIVISION POINT BLOCK / SECTION 9 LOT 989 LOT AREA .96AC SITE CLASS PS DESIGN FLOW 480GPD L.T.A.R. .3600/KF²

Septic Tank: ~~1000~~ 1500 Gallons; STB 338 Date 12-29-02

Pump Tank: 1000 Gallons; PT 27 Date 1-11-03

Pump Make Goulds Model WE0312M1 Serial No. S0331663

Nitrification Field: No Fields 1 Square Feet 1200 Linear Feet 400

No Lines 4@100' Trench Width 36" Max Trench Bottom Depth 36" Gravel Depth N/A

☑ New System ☐ Repair System Type: I, II, (III), IV, V, VI

System Description: PUMP 25% REDUCTION/OFFSITE

Repair System Description: LP PANEL/OFFSITE

Maintenance Agreement Required: ☐ Yes ☐ No

☑ House/Mod. Home No. Bedrooms 4

☐ Mobile Home No. Bathrooms 4

☐ Business No. Employees

☐ Other


☐ Slab ☐ Crawl Space ☑ Basement w/plumbing ☐ Basement wo/plumbing

Water Supply: ☐ Individual ☐ Public ☑ Community

Comments:/Conditions: SEE PLAT FOR SEPTIC LOCATION


Comments:/Conditions: 8/9/02 Reviewed plan essentially complies with 4BD. plan. AWS. Tanks & lines checked 3/12/03 press, elect. & alarm 3/14/03

INITIAL SITE SKETCH

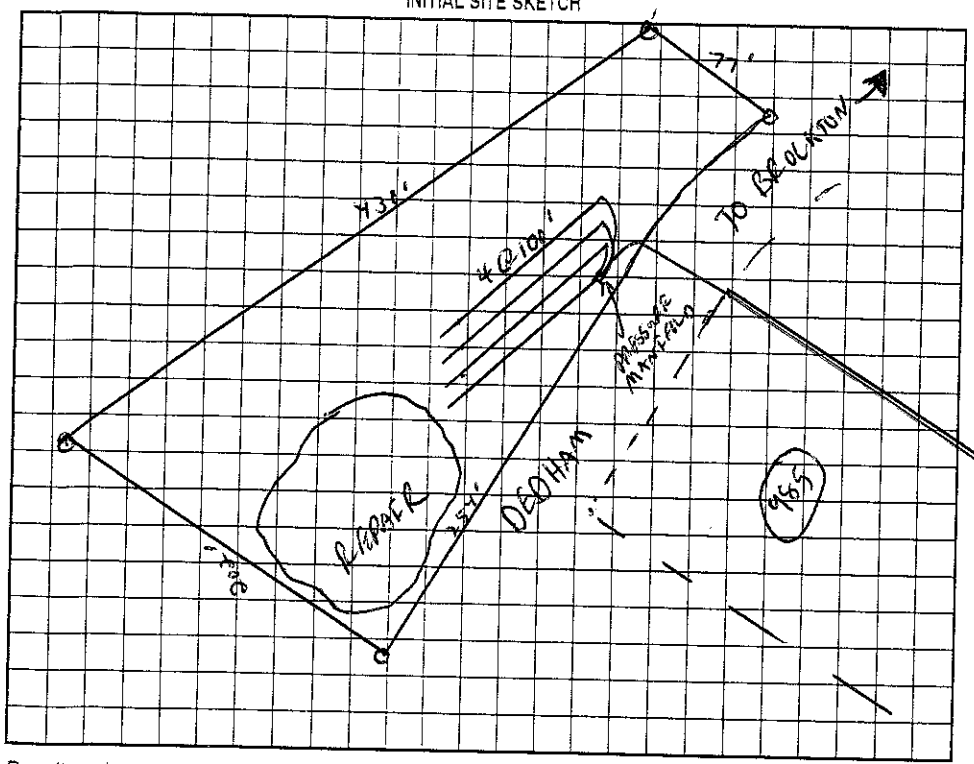

1" = 100'

AS BUILT SKETCH

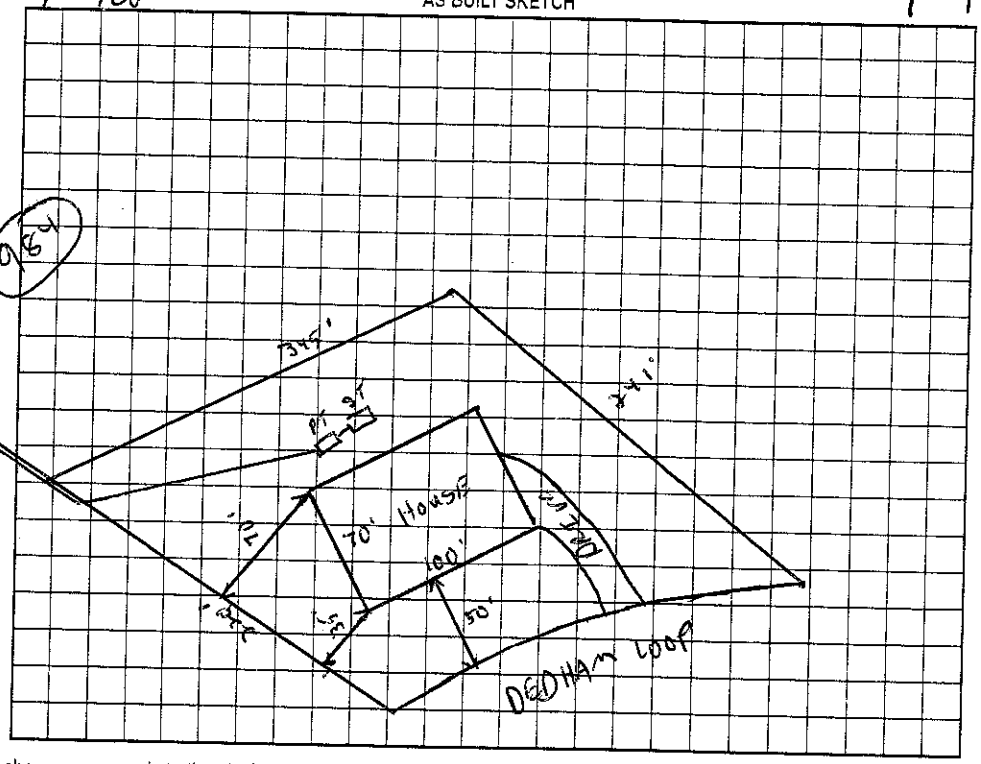

Permit can be suspended or revoked if any false information is supplied toward securing the permit/any unauthorized changes are made to the site/any unauthorized changes are made in the installation of the system. Improvement Permit with plat valid without expiration. Improvement Permit with site plan valid for sixty months. Authorization to Construct is valid for a period equal to that of Improvement Permit – not to exceed sixty months.

Signed: _____ date 5-21-02 Installed by: Bobby Mayhew RS

Improvement Permit by: _____ RS date 5/21/02 Operation Permit by: _____ date 3/14/03

Authorization to Construct by: _____ RS. date 8/9/02 Existing System Inspection by: _____ date _____

HEALTH DEPT. COPY: WHITE OWNER COPY (FINAL): YELLOW OWNER COPY (INITIAL): PINK