IREDELL COUNTY HEALTH DEPARTMENT

STATESVILLE 704-87[illegible] 100.00 Paid MOORESVILLE 704-664-5281

2:00

IMPROVEMENT PERMIT / AUTHORIZATION TO CONSTRUCT / OPERATION PERMIT / EXISTING SYSTEM INSPECTION

PERMIT# 105 497 PIN# 4624-27-5705.985 4624283589 DATE 4/26/04

OWNER OR CONTRACTOR Simmons Builders PHONE: Business 704-358-9940 Home

ADDRESS 817 E. Morehead St, Suite 100 Charlotte NC 28202-2705

LOCATION BSR, TR 2nd Mansfield TL Brockton, TR Dr Dotham, 3rd on Lt.

SUBDIVISION Point BLOCK / SECTION 9 LOT 985 LOT AREA 1.24Ac SITE CLASS PS DESIGN FLOW 600 L.T.A.R. 0.5

Septic Tank: 1500 Gallons; STB 338 Date 4-9-04
Pump Tank: 1500 Gallons; PT 353 Date 4-12-04
Pump Make Gould Model WE03M10 Serial No.
Nitrification Field: No Fields 1 Square Feet 1500 Linear Feet 500
No Lines 5 @ 100' Trench Width 36" Max Trench Bottom Depth 36" Gravel Depth —

☒ New System ☐ Repair System Type: I, II, III, IV, V, VI
System Description: PM 25% Reduction
Repair System Description: Some
Maintenance Agreement Required: ☐ Yes ☒ No

☒ House/Mod. Home No. Bedrooms 5
☐ Mobile Home No. Bathrooms 5
☐ Business No. Employees
☐ Other


☐ Slab ☒ Crawl Space ☐ Basement w/plumbing ☐ Basement wo/plumbing

Water Supply: ☐ Individual ☐ Public ☒ Community


Comments:/Conditions:

Comments:/Conditions: Checked lines & ST 7/13/04
Pres, elect & alarm 10/21/04

INITIAL SITE SKETCH

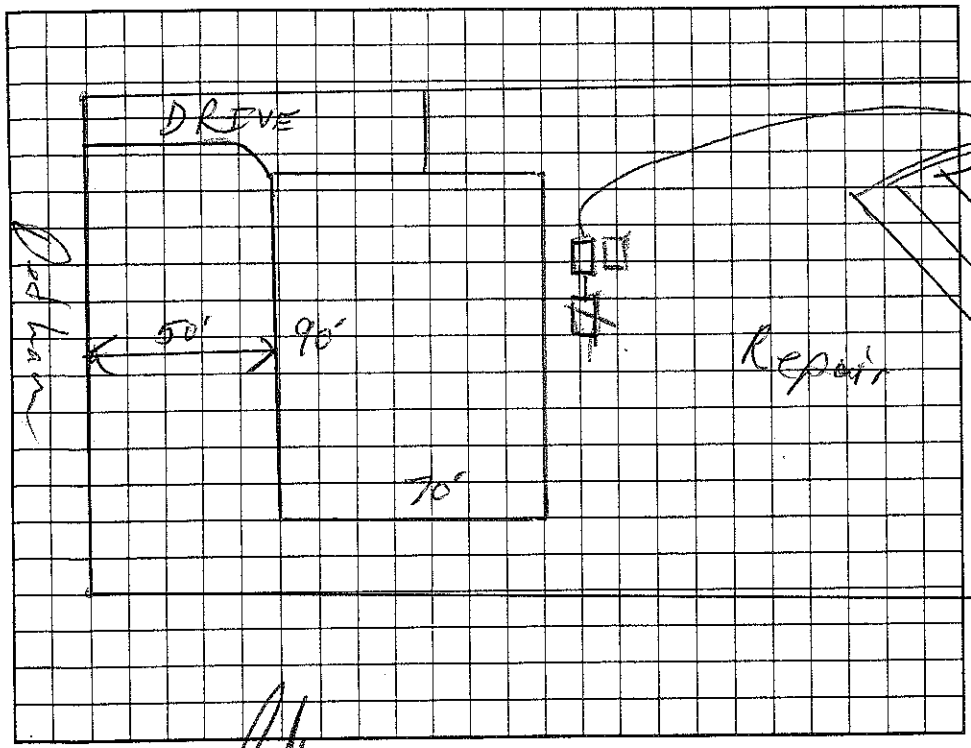

AS BUILT SKETCH

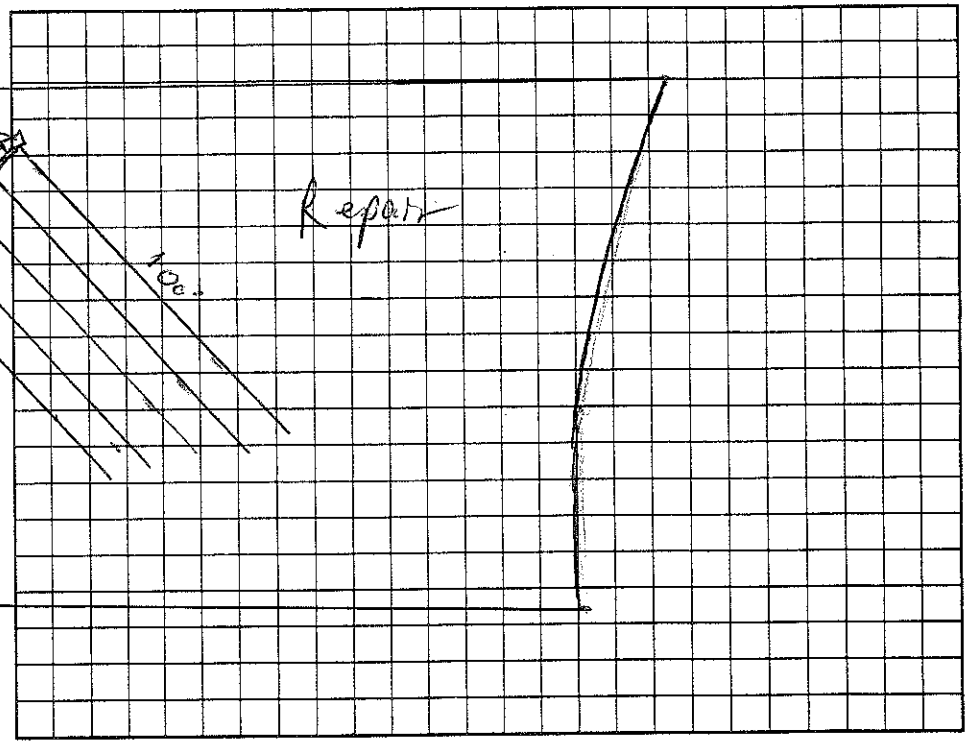

Permit can be suspended or revoked if any false information is supplied toward securing the permit/any unauthorized changes are made to the site/any unauthorized changes are made in the installation of the system. Improvement Permit with plat valid without expiration. Improvement Permit with site plan valid for sixty months. Authorization to Construct is valid for a period equal to that of Improvement Permit – not to exceed sixty months.

Signed: date 5/11/04 Installed by: R&H

Improvement Permit by: date 4/26/04 Operation Permit by: Maria H. Dotson RS date 10/21/04

Authorization to Construct by: RS date 4/26/04 Existing System Inspection by: date

HEALTH DEPT. COPY: WHITE OWNER COPY (FINAL): YELLOW OWNER COPY (INITIAL): PINK