IREDELL COUNTY HEALTH DEPARTMENT

STATESVILLE 704-878-5305 MOORESVILLE 704-664-5281

IMPROVEMENT PERMIT / AUTHORIZATION TO CONSTRUCT / OPERATION PERMIT / EXISTING SYSTEM INSPECT

PERMIT# 105498 PIN# 4624 27 5905.986 4624 28 3731 DATE 5/20/02

OWNER OR CONTRACTOR POINT ON NORMAN // SIMMONS, TRUS PHONE: Business 660-1185 Home

ADDRESS 2214 BRAWLEY SCHOOL - MOORESVILLE NC 28117

LOCATION BRAWLEY SCHOOL - JR 2nd MANSFIELD - TL BROKTON - JR 1st DEDHAM - 4TH ON LT

SUBDIVISION POINT BLOCK / SECTION 9 LOT 986 LOT AREA 1.3AC SITE CLASS PS DESIGN FLOW 480GPD L.T.A.R. 36PD/FT

Septic Tank: 1000+ Gallons; STB 338 Date 7-17-04

Pump Tank: Gallons; PT Date

Pump Make: Model Serial No.

Nitrification Field: No Fields 1 Square Feet 1200 Linear Feet 400

No Lines 4@100' Trench Width 36" Max Trench Bottom Depth 36" Gravel Depth N/A

☑ New System ☐ Repair System Type: I, II, (III), IV, V, VI

System Description: GRAVITY 25% REDUCTION

Repair System Description: LP PANEL

Maintenance Agreement Required: ☐ Yes ☑ No

☐ Slab ☑ Crawl Space ☐ Basement w/plumbing ☐ Basement wo/plumbing

☑ House/Mod. Home No. Bedrooms 4

☐ Mobile Home No. Bathrooms 4

☐ Business No. Employees


☐ Other

Water Supply: ☐ Individual ☐ Public ☑ Community


Comments./Conditions:

Comments:/Conditions: Checked tank & lines 8/20/04 Divert stormwater away from Septic System. MDJ Checked D-box 8/26/04

INITIAL SITE SKETCH 1"=50'

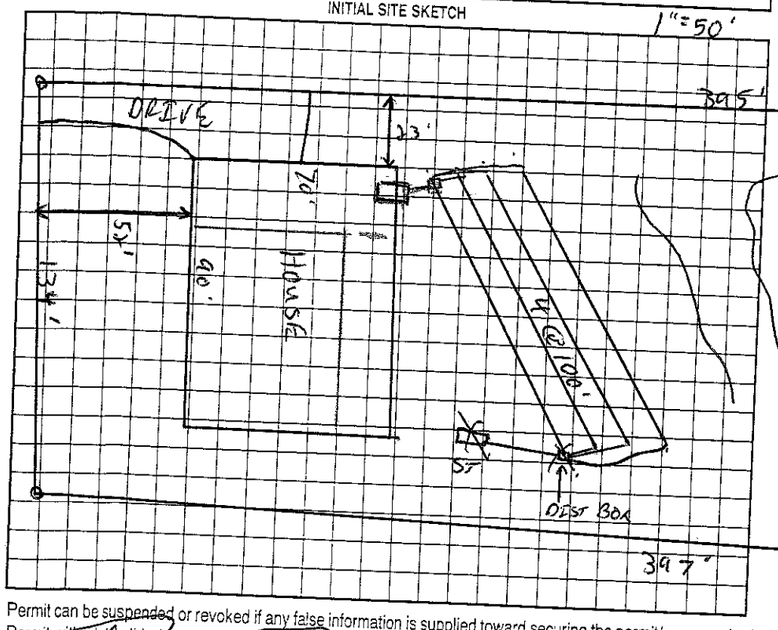

AS BUILT SKETCH

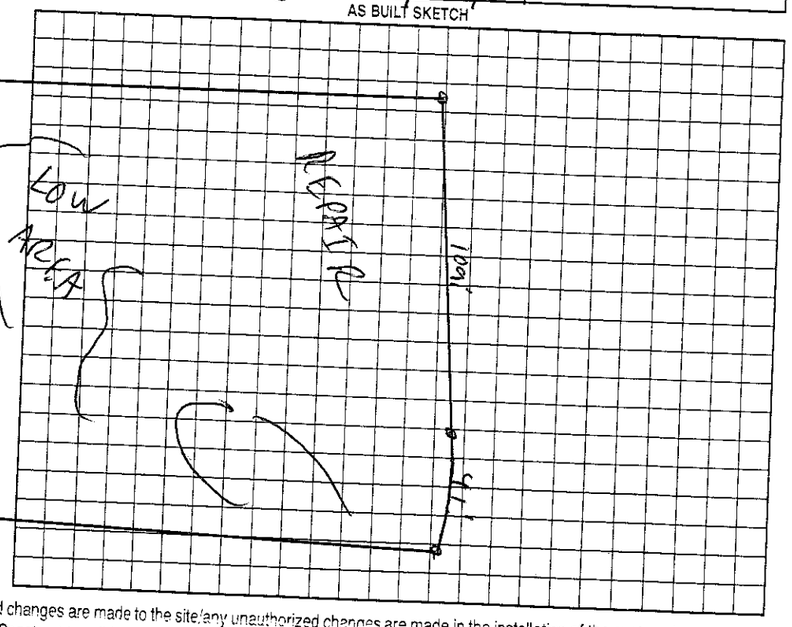

Permit can be suspended or revoked if any false information is supplied toward securing the permit/any unauthorized changes are made to the site/any unauthorized changes are made in the installation of the system. Improvement Permit with plat valid without expiration. Improvement Permit with site plan valid for sixty months. Authorization to Construct is valid for a period equal to that of Improvement Permit – not to exceed sixty months.

Signed: date 5-20-02 Installed by: R&H R.S.

Improvement Permit by: date 5/20/02 Operation Permit by: date

Authorization to Construct by: date 12-12-03 Existing System Inspection by:

HEALTH DEPT. COPY: WHITE OWNER COPY (FINAL): YELLOW OWNER COPY (INITIAL): PINK