2:30

IREDELL COUNTY HEALTH DEPARTMENT

STATESVILLE 704-878-53[illegible] MOORESVILLE 704-664-5281

IMPROVEMENT PERMIT / AUTHORIZATION TO CONSTRUCT / OPERATION PERMIT / EXISTING SYSTEM INSPECTION

PERMIT# 105490 PIN# 4624 27 5905.482 4624-28-5102 DATE 5/16/02

OWNER OR CONTRACTOR POINT ON NORMAN (Debbie Conat.) PHONE: Business 660-1185 Home

ADDRESS 2214 BRAWLEY SCHOOL RD. MOORESVILLE NC 28117

LOCATION BRAWLEY SCHOOL RD. TR 2nd MANSFIELD - TL BROKTON - 2nd LOT ON RT PAST DEOHAM

SUBDIVISION POINT BLOCK / SECTION 9 LOT 982 LOT AREA .81 AC SITE CLASS. BS DESIGN FLOW 450GPD L.T.A.R. ~.36 PD/FT²

Septic Tank: ~~1000~~ 1500 Gallons; STB 338 Date 2/11/03

Pump Tank: 1000 Gallons; PT 27 Date 2/22/03

Pump Make: MYERS Model WEG-5HH Serial No.

Nitrification Field: No Fields 1 Square Feet 1350 Linear Feet 450

No Lines 5@90' Trench Width 36" Max Trench Bottom Depth 36" Gravel Depth N/A

☑ New System ☐ Repair System Type: I, II, (III), IV, V, VI

System Description: Pump 25% REDUCTION

Repair System Description: 16" ~~STONE~~ PPBAS

Maintenance Agreement Required: ☐ Yes ☑ No

☐ ~~House~~/Mod. Home No. Bedrooms 4

☐ Mobile Home No. Bathrooms 4

☐ Business No. Employees

☐ Other


☐ Slab ☑ Crawl Space ☐ Basement w/plumbing ☐ Basement wo/plumbing

Water Supply: ☐ Individual ☐ Public ☑ ~~Community~~


Comments:/Conditions: NO ROOM REMAINS FOR SWIMMING POOL ON THIS LOT, AWS.
9/17/02 - Plans received, essentially complywith Permit - AWS.

Comments:/Conditions:

INITIAL SITE SKETCH 1"=50'

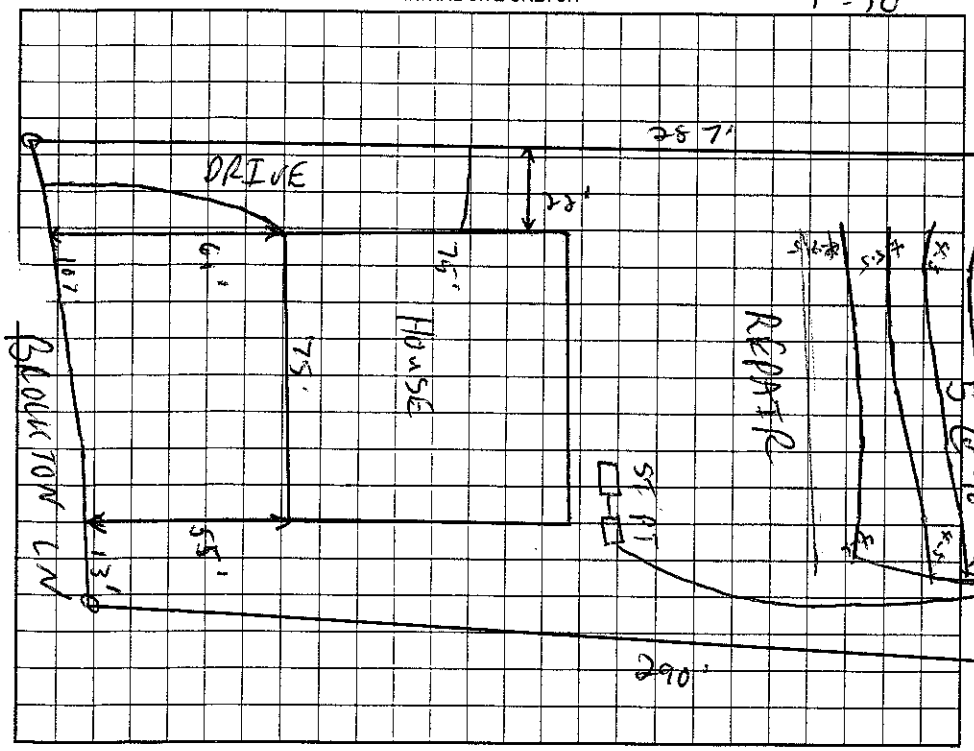

AS BUILT SKETCH

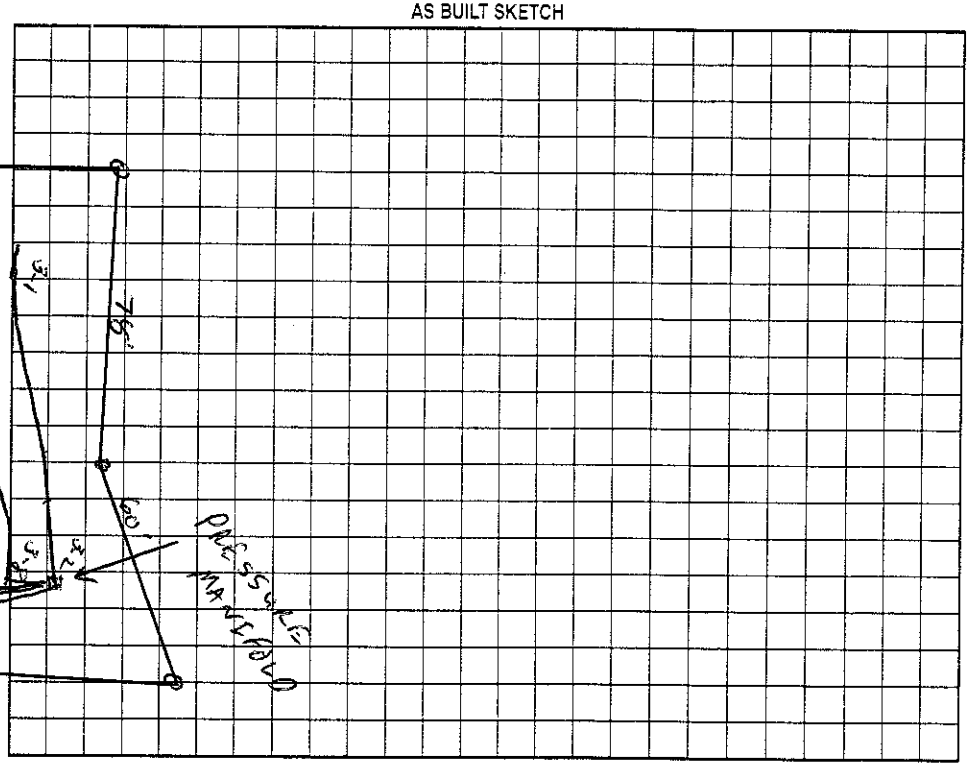

Permit can be ~~suspended~~ or revoked if any false information is supplied toward securing the permit/any unauthorized changes are made to the site/any unauthorized changes are made in the installation of the system. Improvement Permit with plat valid without expiration. Improvement Permit with site plan valid for sixty months. Authorization to Construct is valid for a period equal to that of Improvement Permit – not to exceed sixty months.

Signed: [signature] date 5-[illegible]-02 Installed by:

Improvement Permit by: [signature] RS date 5/16/02 Operation Permit by: [signature] RS date 5/13/03

Authorization to Construct by: Whitney Sparks RS. date 9/17/02 Existing System Inspection by: date

HEALTH DEPT. COPY: WHITE OWNER COPY (FINAL): YELLOW OWNER COPY (INITIAL): PINK