IREDELL COUNTY HEALTH DEPARTMENT

STATESVILLE 704-878-5305 MOORESVILLE 704-664-5281

IMPROVEMENT PERMIT / AUTHORIZATION TO CONSTRUCT / OPERATION PERMIT / EXISTING SYSTEM INSPECTION

PERMIT# 105492 PIN# 4624275905.983 4624285247 DATE 11-1-04

OWNER OR CONTRACTOR Simonini Builders PHONE: Business 358-9940 ext 104 Home 980-722-9629

ADDRESS 1910 South Blvd. Charlotte, NC

LOCATION Brawley School Rd TR 2nd Mansfield TL Brockton TR Deadham on left Corner

SUBDIVISION The Point BLOCK / SECTION 3 LOT 983 LOT AREA 1.23 Acre SITE CLASS. PS DESIGN FLOW 480 gpd L.T.A.R. .3

Septic Tank: 1000 Gallons; STB ~~1-21-05~~ 338 Date 1-21-05

Pump Tank: 1000 Gallons; PT 27 Date 1-21-04

Pump Make: Gould Model WE0312M Serial No.

Nitrification Field: No Fields 1 Square Feet 1200 Linear Feet 400

No Lines 4@100' Trench Width 36" Max Trench Bottom Depth 36" Gravel Depth

☒ New System ☐ Repair System Type: I, II, III, IV, V, VI

System Description: Pump - 25% Reduction

Repair System Description: Pump - Panel Blk

Maintenance Agreement Required: ☐ Yes ☒ No Not Initially

☒ House/Mod. Home No. Bedrooms 4

☐ Mobile Home No. Bathrooms 4

☐ Business No. Employees

☐ Other

☐ Slab ☐ Crawl Space ☒ Basement w/plumbing ☐ Basement wo/plumbing


Water Supply: ☐ Individual ☒ Public ☒ Community

Comments:/Conditions:

Scale 1:50'

Comments:/Conditions: Note: Keep Septic System at least 15 ft From "Future Pool Area".

INITIAL SITE SKETCH

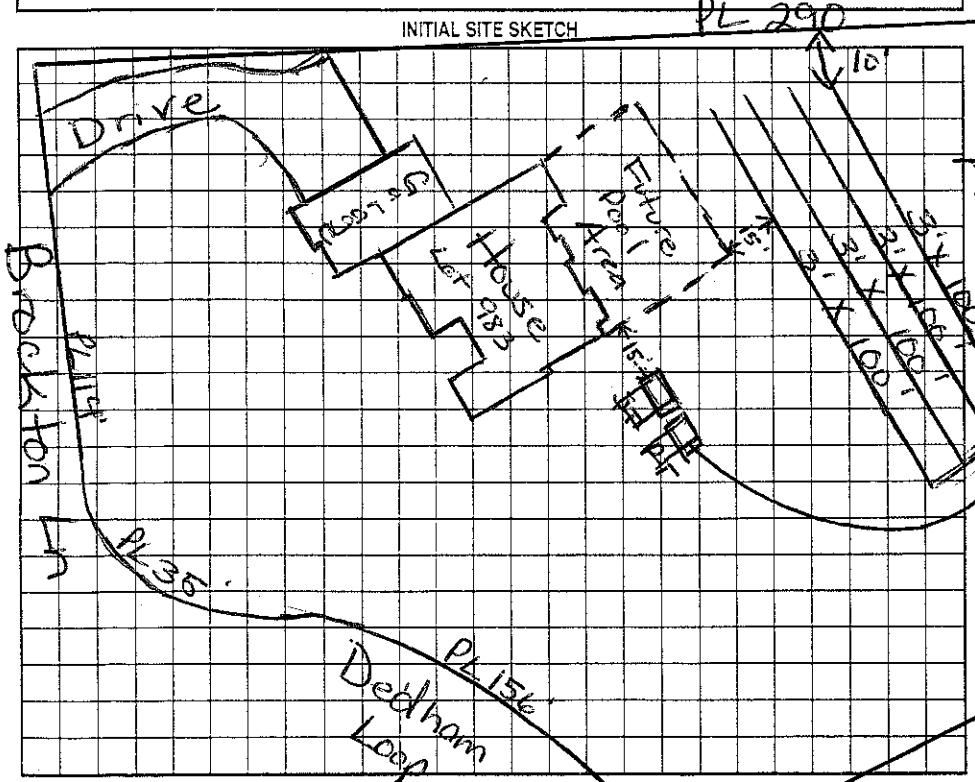

AS BUILT SKETCH

Installed EZ Flow as Drawn

Permit can be suspended or revoked if any false information is supplied toward securing the permit/any unauthorized changes are made to the site/any unauthorized changes are made in the installation of the system. Improvement Permit with plat valid without expiration. Improvement Permit with site plan valid for sixty months. Authorization to Construct is valid for a period equal to that of Improvement Permit – not to exceed sixty months.

Signed: date 11-11-04 Installed by: R H RS.

Improvement Permit by: Maria H Dotson RS date 11/1/04 Operation Permit by: Maria H Dotson date 10/14/05

Authorization to Construct by: Maria H Dotson RS date 11/1/04 Existing System Inspection by: date

HEALTH DEPT. COPY: WHITE OWNER COPY (FINAL): YELLOW OWNER COPY (INITIAL): PINK