IREDELL COUNTY HEALTH DEPARTMENT

STATESVILLE 704-878-5305 MOORESVILLE 704-664-5281

IMPROVEMENT PERMIT / AUTHORIZATION TO CONSTRUCT / OPERATION PERMIT / EXISTING SYSTEM INSPECTION

PERMIT# 105430 PIN# 4624275905 959 4624287473 DATE 5/21/02

OWNER OR CONTRACTOR POINT ON NORMAN / John R. Poore PHONE: Business 660-1185 Home

ADDRESS 2214 BRAWLEY SCHOOL - MOORESVILLE NC 28117

LOCATION BRAWLEY SCHOOL - TR 2nd MANSFIELD (SEPTIC ON RT CORNER) - (TL BROCKTON - TR DEDHAM ON CORNER FOR LOT)

SUBDIVISION POINT BLOCK / SECTION 9 LOT 959 959A LOT AREA 1.171C SITE CLASS PS DESIGN FLOW 480GPD L.T.A.R. ~.20 gal/ft =

Septic Tank: ~~1000~~ 1500 Gallons; STB 338 Date 3-08-05

Pump Tank: 1000 Gallons; PT 27 Date 3-11-05

Pump Make: Goulds Model WE0312 Serial No.

Nitrification Field: No Fields 1 Square Feet 1800 Linear Feet 600

No Lines 5 Trench Width 36" Max Trench Bottom Depth 36" Gravel Depth N/A

☑ New System ☐ Repair System Type: I, II, (III), IV, V, VI

System Description: PUMP 25% REDUCTION

Repair System Description: LP PANEL

Maintenance Agreement Required: ☐ Yes ☒ No

☑ House/Mod. Home No. Bedrooms 4

☐ Mobile Home No. Bathrooms 4

☐ Business No. Employees

☐ Other


☐ Slab ☑ Crawl Space ☐ Basement w/plumbing ☐ Basement wo/plumbing

Water Supply: ☐ Individual ☐ Public ☒ Community

Comments:/Conditions: 3@100' - 1" TAPS
2@150 - 3/4" TAPS

1" = 100'

INITIAL SITE SKETCH

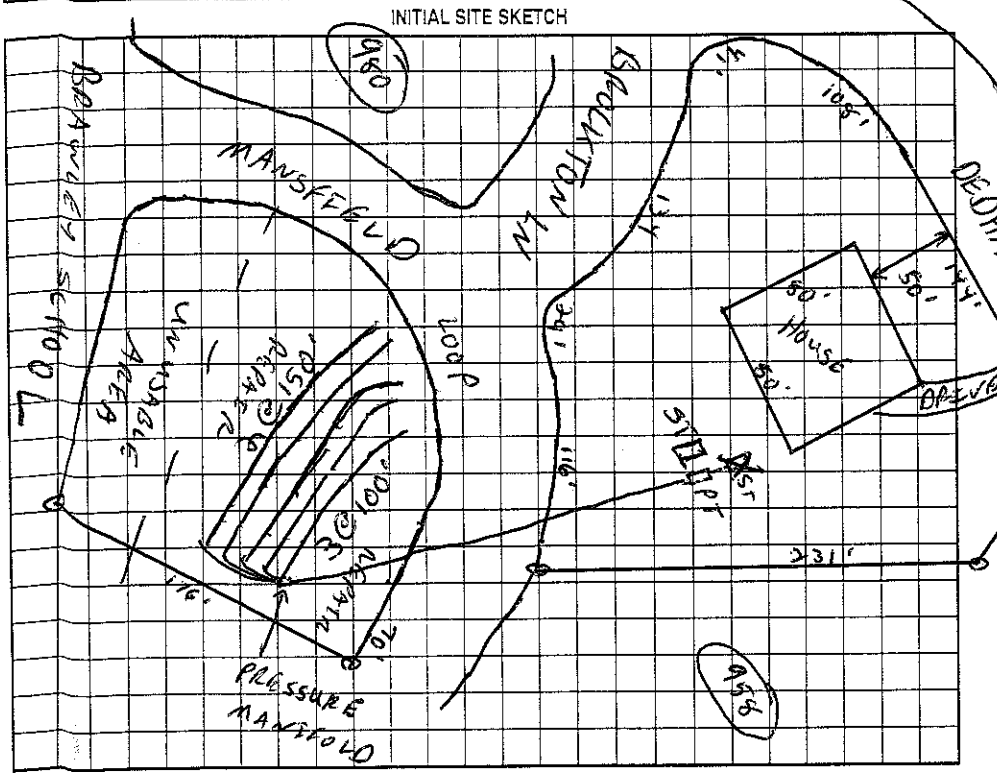

Comments:/Conditions: Reviewed Building plans & site 9/15/04 essentially in compliance with I.P.
Checked tanks 4/29/05 mw
Checked lines 7/1/05 mw

AS BUILT SKETCH

Pressure, elect & alarm 7/21/05

Installed as Drawn

Permit can be ~~suspended~~ or revoked if any false information is supplied toward securing the permit/any unauthorized changes are made to the site/any unauthorized changes are made in the installation of the system. Improvement Permit with plat valid without expiration. Improvement Permit with site plan valid for sixty months. Authorization to Construct is valid for a period equal to that of Improvement Permit – not to exceed sixty months.

Signed: date 5-23-02 Installed by: R&H date 7/21/05

Improvement Permit by: C. B. RS date 5/21/02 Operation Permit by: Marie H. Dolan RS

Authorization to Construct by: Marie H. Dolan RS date 9/15/04 Existing System Inspection by: date

HEALTH DEPT. COPY: WHITE OWNER COPY (FINAL): YELLOW OWNER COPY (INITIAL): PINK