# IREDELL COUNTY HEALTH DEPARTMENT

## IMPROVEMENT PERMIT / AUTHORIZATION TO CONSTRUCT / OPERATION PERMIT / EXISTING SYSTEM INSPECTION

STATESVILLE 704-878-5305 MOORESVILLE 704-664-5281

PERMIT# 105487 PIN# 4624 27 5905.980 4624 28 8152

OWNER OR CONTRACTOR POINT ON NORMAN / YOUNG BUILDERS PHONE: Business 660-1185 Home DATE 5/14/02

ADDRESS 2214 BRAWLEY SCHOOL RD MOORESVILLE 28117

LOCATION BRAWLEY SCHOOL - TR 2nd MANSFIELD - TL BROOKTON - ON LT CORNER

SUBDIVISION POINT BLOCK / SECTION 9 LOT 980 LOT AREA 1.29AC SITE CLASS PS DESIGN FLOW 480GPD L.T.A.R. ~.25gal/ft²

Septic Tank: 1000+ Gallons: STB 338 Date 4/4/05

Pump Tank: Gallons: PT Date

Pump Make: Model Serial No.

Nitrification Field: No Fields 1 Square Feet 1500 Linear Feet 500

No Lines 5@100' Trench Width 36" Max Trench Bottom Depth 36" Gravel Depth N/A

☑ New System ☐ Repair System Type: I, II, III, IV, V, VI

System Description: GRAV. 25% REDUCTION

Repair System Description: GRAV. 25% REDUCTION

Maintenance Agreement Required: ☐ Yes ☑ No

☐ Slab ☑ Crawl Space ☐ Basement w/plumbing ☐ Basement wo/plumbing


☑ House/Mod. Home ☐ Mobile Home ☐ Business ☐ Other

No. Bedrooms 4 No. Bathrooms 4 No. Employees

Water Supply: ☐ Individual ☐ Public ☑ Community


Comments:/Conditions:

INITIAL SITE SKETCH

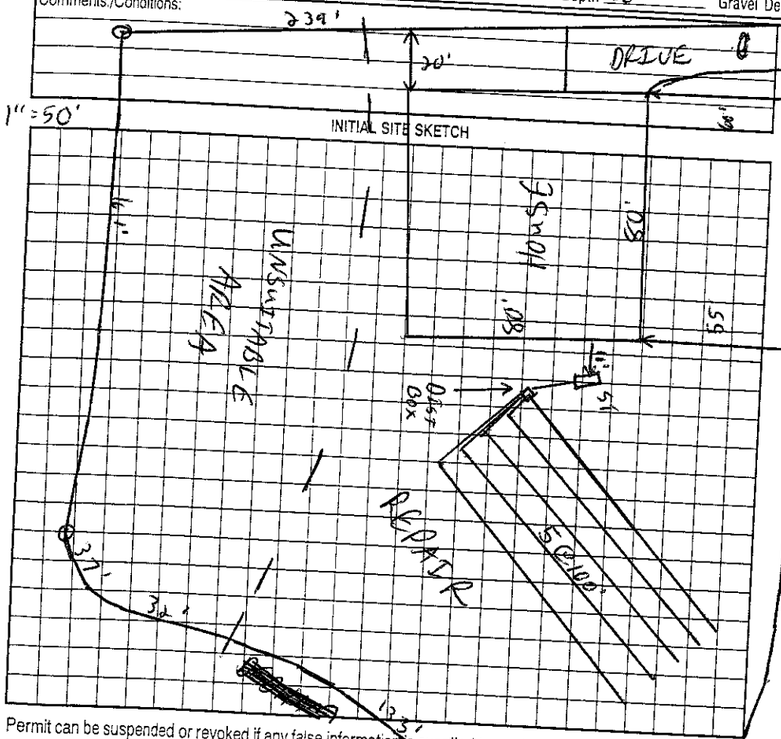


Comments:/Conditions:

AS BUILT SKETCH

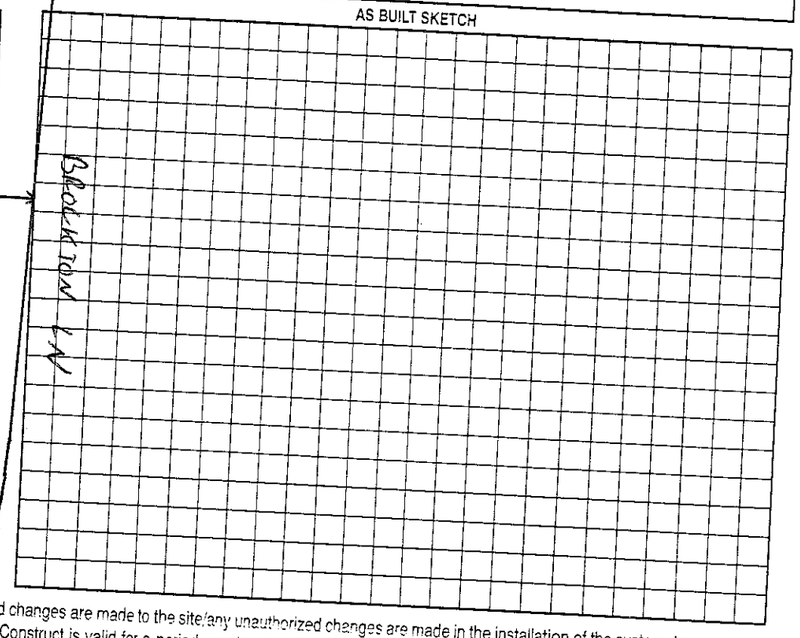


Permit can be suspended or revoked if any false information is supplied toward securing the permit/any unauthorized changes are made to the site/any unauthorized changes are made in the installation of the system. Improvement Permit with plat valid without expiration. Improvement Permit with site plan valid for sixty months. Authorization to Construct is valid for a period equal to that of Improvement Permit – not to exceed sixty months.

Signed: date 5-24-05

Improvement Permit by: date 5/14/02 Installed by: Orbison + Sons.

Authorization to Construct by: Wesley Sparks AS. date 11/24/04 Operation Permit by: Wesley Sparks date 5/13/05

Existing System Inspection by: date

HEALTH DEPT. COPY: WHITE OWNER COPY (FINAL): YELLOW OWNER COPY (INITIAL): PINK