IREDELL COUNTY HEALTH DEPARTMENT

STATESVILLE 704-878-5305 MOORESVILLE 704-664-5281

IMPROVEMENT PERMIT / AUTHORIZATION TO CONSTRUCT / OPERATION PERMIT / EXISTING SYSTEM INSPECTION

PERMIT# 105429 PIN# ~~4624 27 5905.058~~ 4624-28-8889 DATE 5/8/02

OWNER OR CONTRACTOR POINT ON NORMAN / Poore Builders PHONE: Business 660-1185 Home

ADDRESS 2214 BRAWLEY SCHOOL RD / MOORESVILLE NC 28115 #105

LOCATION BRAWLEY SCHOOL TR MANSFIELD - TR HALWICK - ON LT CORNER LOT

SUBDIVISION POINT BLOCK / SECTION 9 LOT 958 LOT AREA .79AC SITE CLASS. KS DESIGN FLOW 480GPD L.T.A.R. .39 gal/ft²

Septic Tank: ~~1000~~ 1500 Gallons; STB 358 Date 4/2/03

Pump Tank: 1000 Gallons; PT 27 Date 11/14/03

Pump Make: Myers Model ME3AF-21 Serial No.

Nitrification Field: No Fields 1 Square Feet 540 Linear Feet 270

No Lines 4 Trench Width 24"&36" Max Trench Bottom Depth 36" Gravel Depth N/A

☑ New System ☐ Repair System Type: I, II, III, IV, V, VI

System Description: LP PANEL

Repair System Description: LP PANEL (OFFSITE)

Maintenance Agreement Required: ☑ Yes ☐ No

☑ House/Mod. Home No. Bedrooms 4

☐ Mobile Home No. Bathrooms 4

☐ Business No. Employees

☐ Other

☐ Slab ☑ Crawl Space ☐ Basement w/plumbing ☐ Basement wo/plumbing

Water Supply: ☐ Individual ☐ Public ☑ Community


Comments:/Conditions: IN LINE PUMP FILTER SHALL BE INSTALLED

Comments:/Conditions:

~~2 LINES 60' OK GM~~

Tanks & lines checked by GM

INITIAL SITE SKETCH 1"=50'

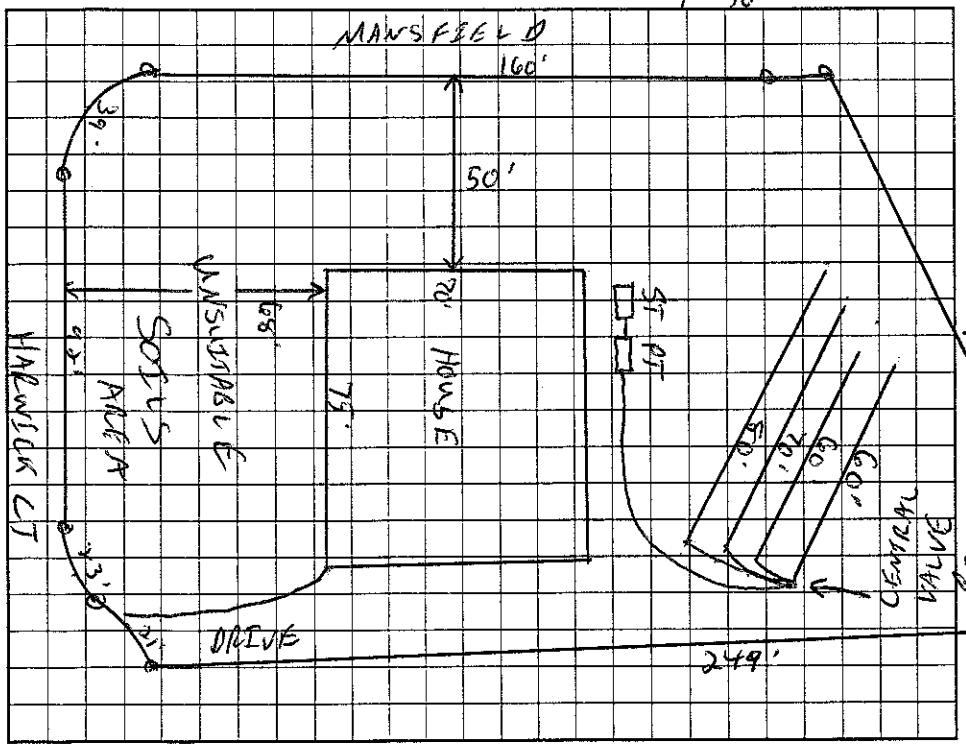

AS BUILT SKETCH

Permit can be suspended or revoked if any false information is supplied toward securing the permit/any unauthorized changes are made to the site/any unauthorized changes are made in the installation of the system. Improvement Permit with plat valid without expiration. Improvement Permit with site plan valid for sixty months. Authorization to Construct is valid for a period equal to that of Improvement Permit – not to exceed sixty months.

Signed: [signature] date 5-23-03 Installed by: R&H Inc

Improvement Permit by: [signature] RS date 5/8/02 Operation Permit by: [signature] RS date 6/9/03

Authorization to Construct by: [signature] RS date 11-18-02 Existing System Inspection by: date

HEALTH DEPT. COPY: WHITE OWNER COPY (FINAL): YELLOW OWNER COPY (INITIAL): PINK