




OWNER'S SUITE
9'-0" CLG.
CARPET
TILE
SHOWER
WHIRLPOOL
TUB
TEMPERED
ENCLOSURE
LINEN
HIS
CLOSET
CARPET
R/A
LINEN
BALCONY
CARPET
10'-0" CLG.
DOWN 7
RISERS
OPT. COMP.
STATION
SUITE TWO
CARPET
9'-0" CLG.
CLOSET
CARPET
DRESSING
BATH
TILE
9'-0" CLG.
2 x 8 CLG. JOIST
@ 16" O.C.
CLIPPED CLG.
4 JACK
STUDS
TIE DOWN
THIS SHEET
BAY WINDOW HANGING
DETAIL THIS SHEET
OVERALL
OVERALL

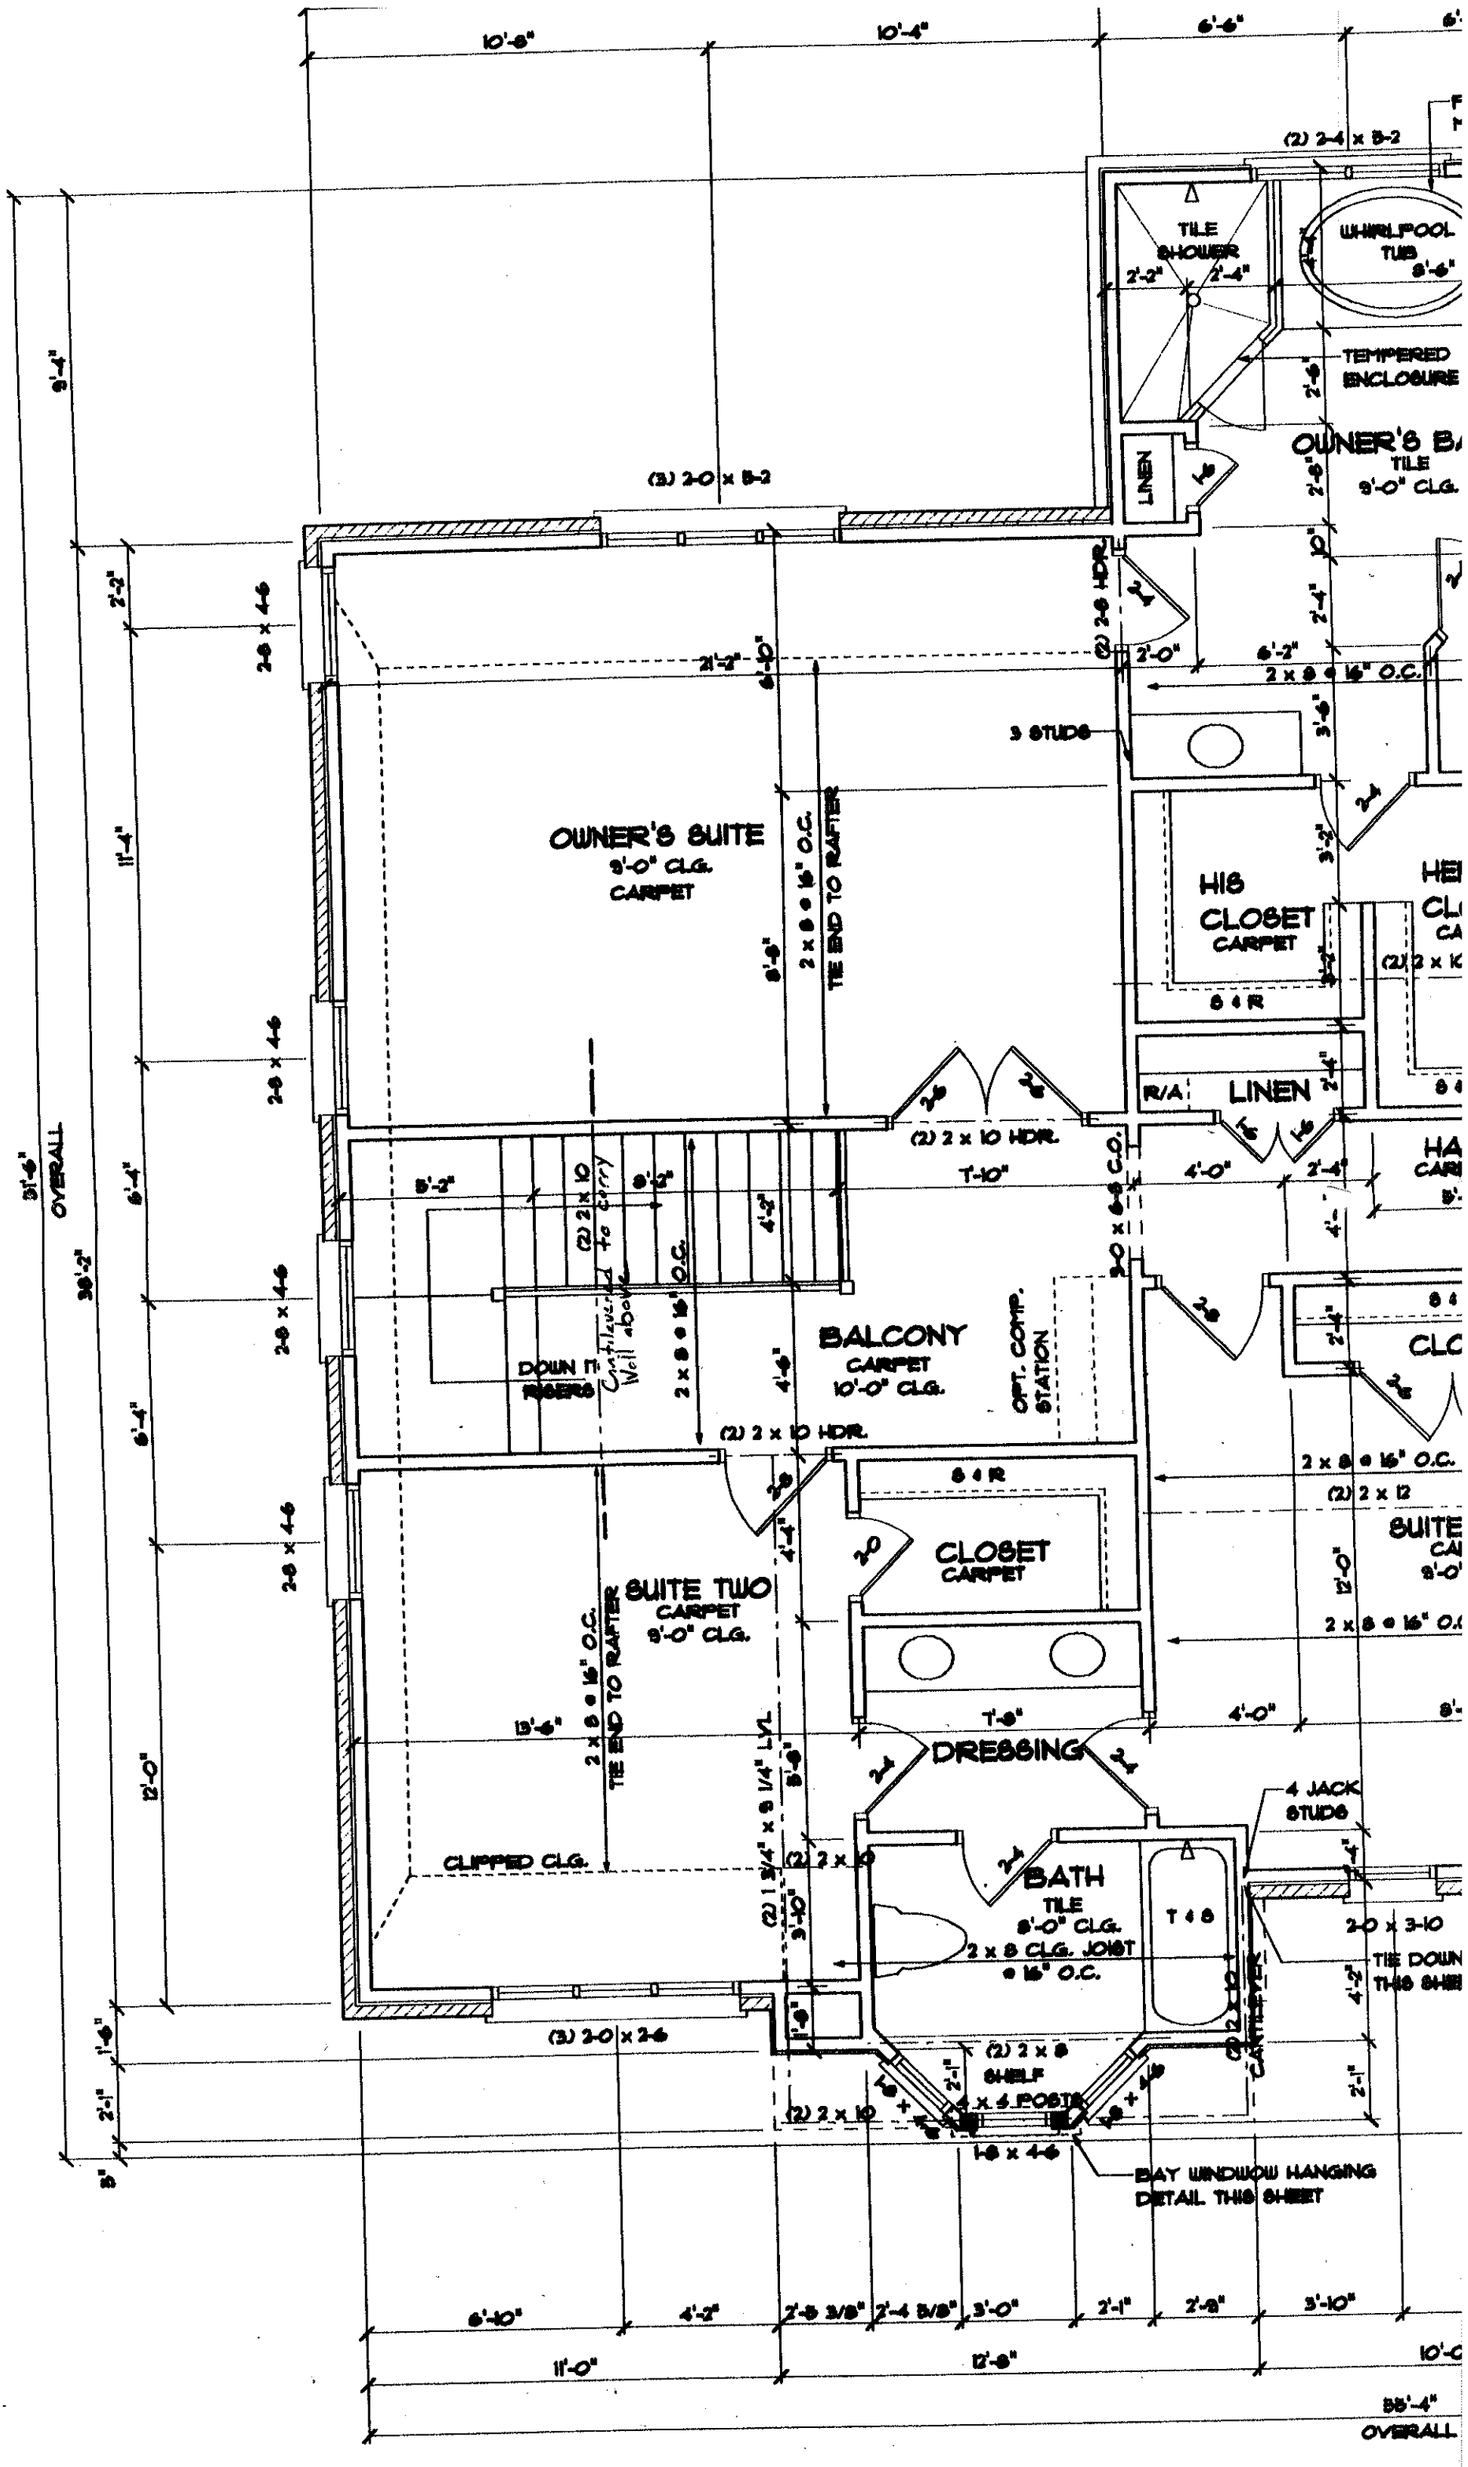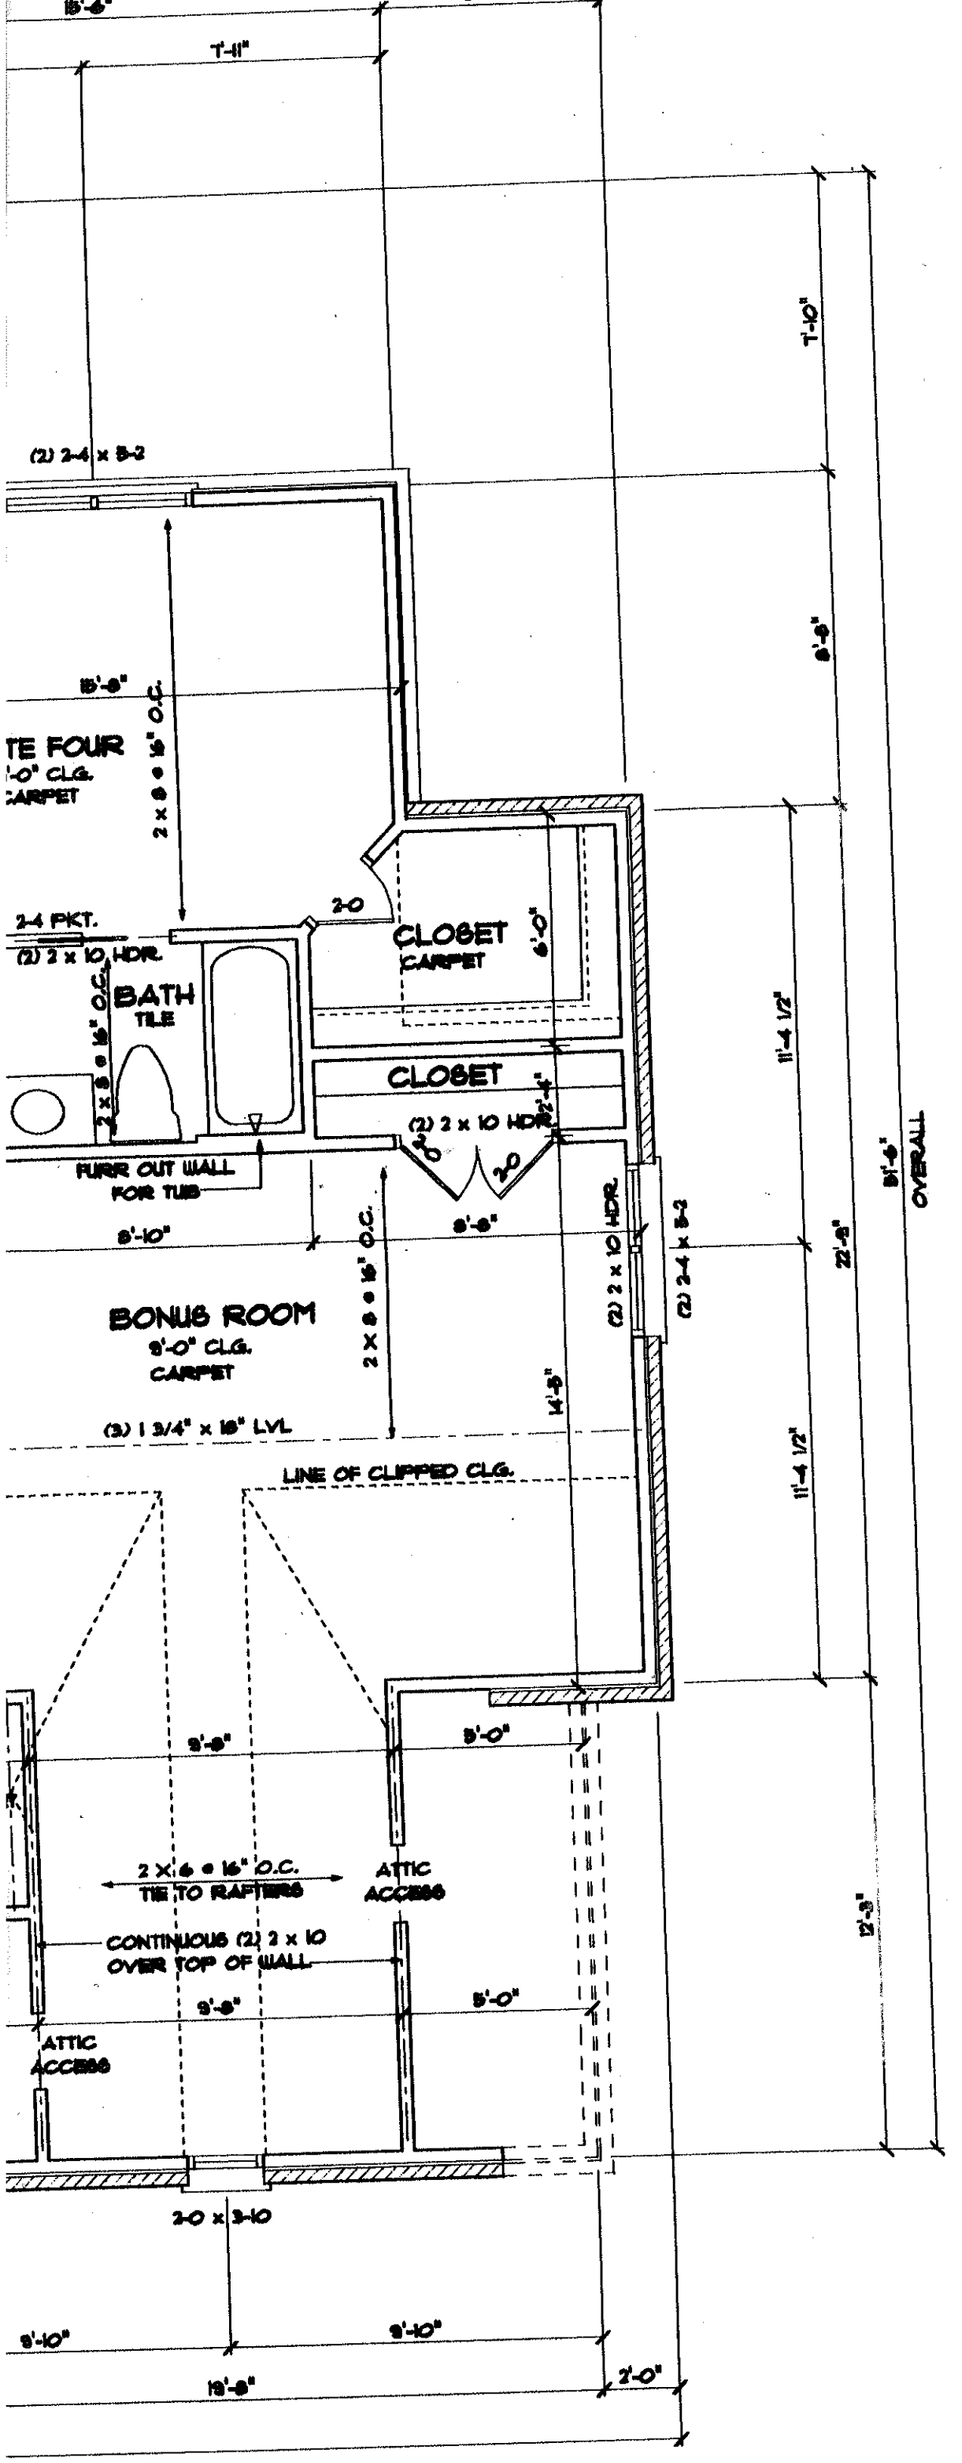

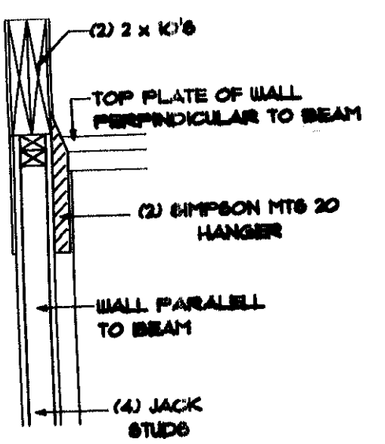


TIE DOWN DETAIL

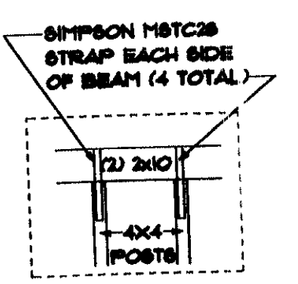


BAY WINDOW HANGING DETAIL

NOTE:
SEE GN-1 SHEET, NOTE 5
FOR ALL BRICK LINTELS

NOTE:

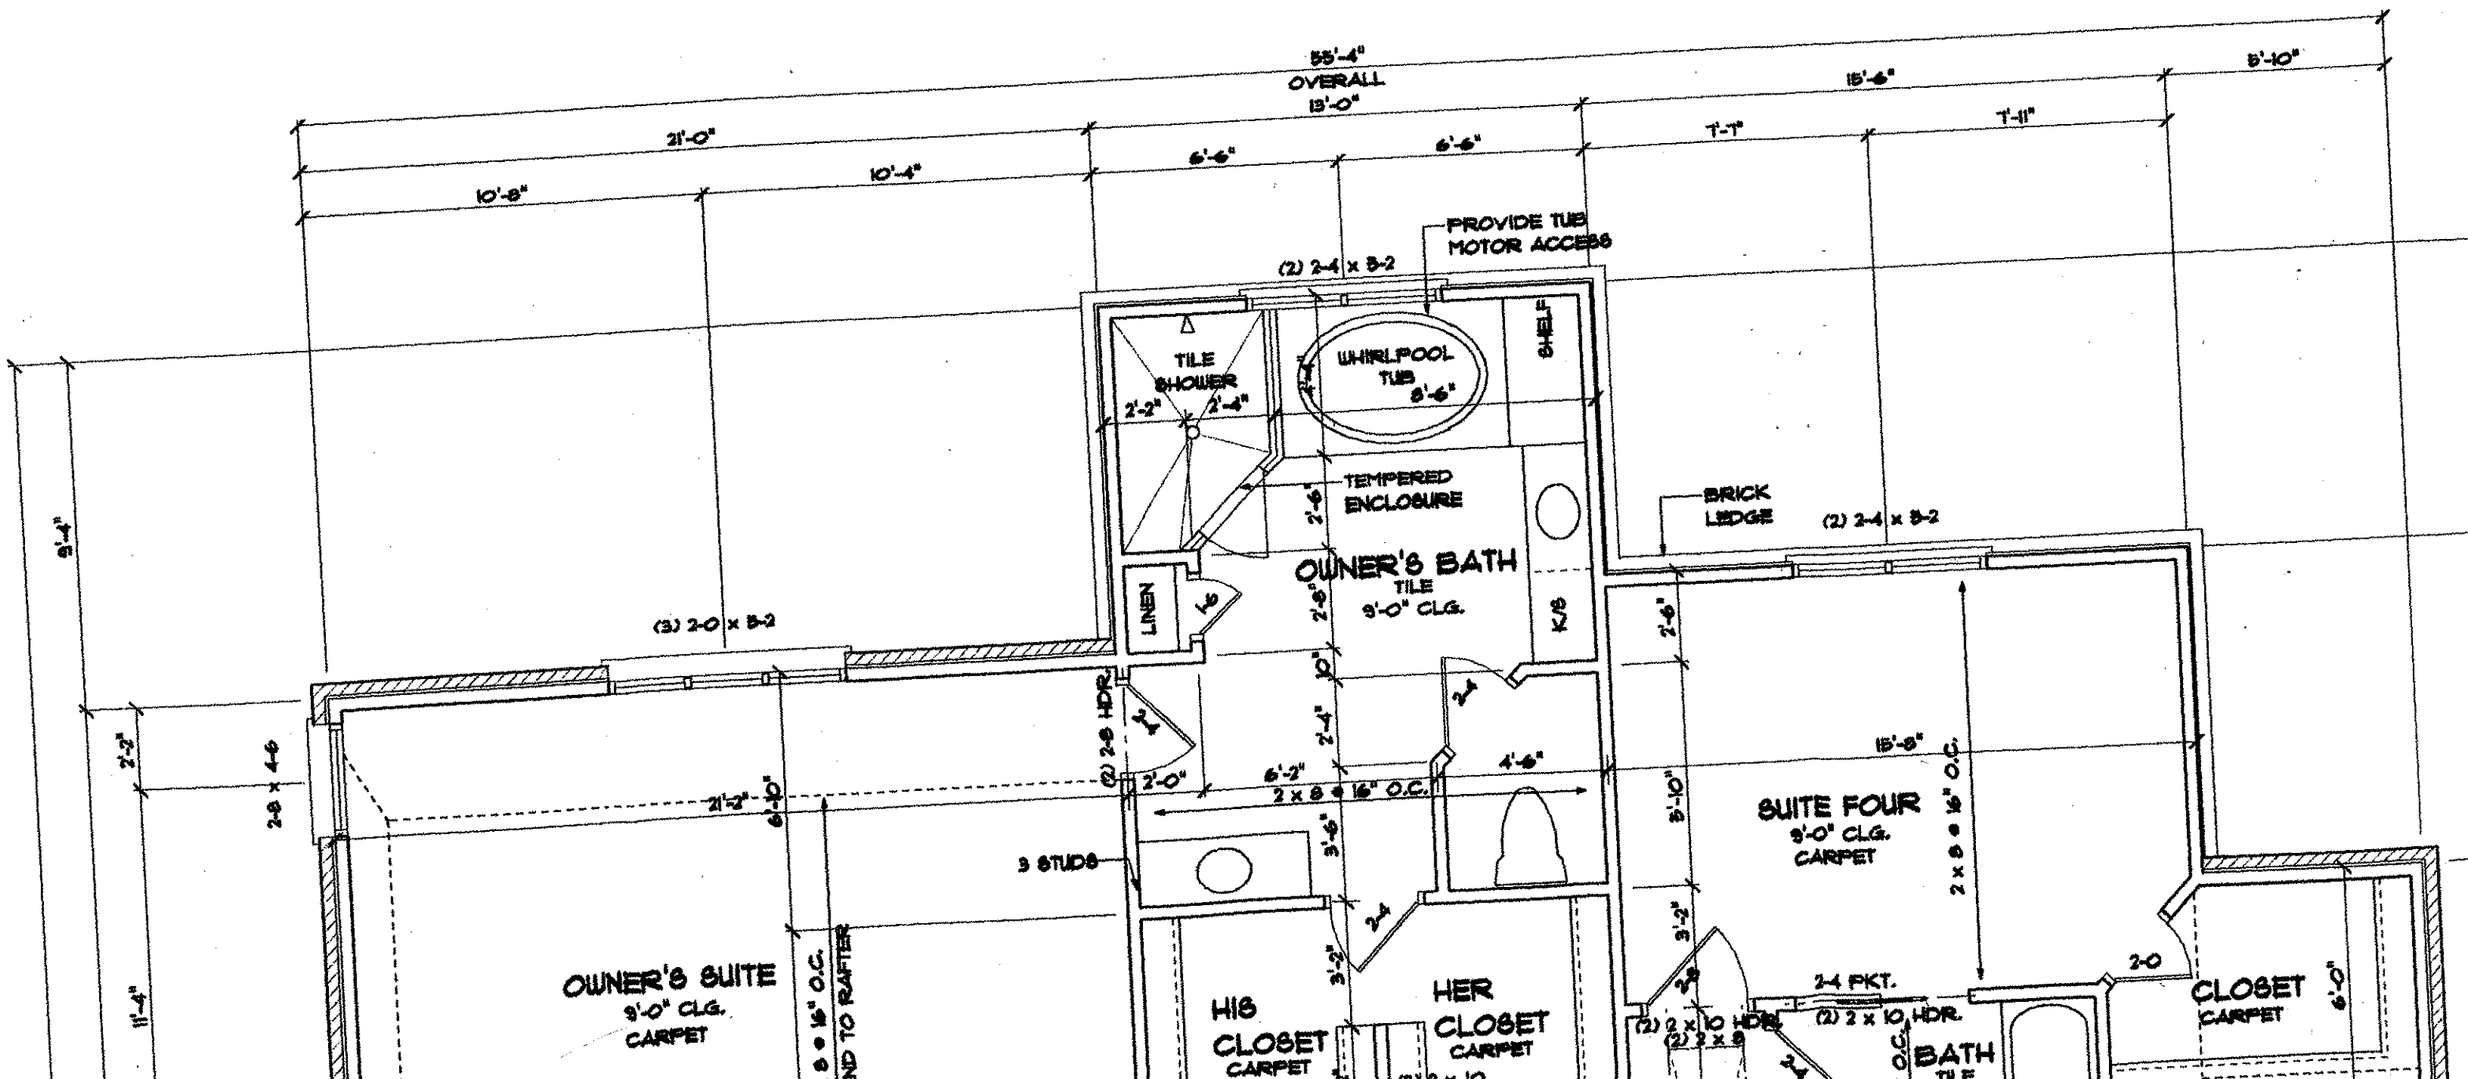
55'-4"
OVERALL
21'-0"
10'-8"
10'-4"
13'-0"
6'-6"
6'-6"
15'-6"
7'-7"
7'-11"
5'-10"
PROVIDE TUB MOTOR ACCESS
(2) 2-4 x 5-2
TILE SHOWER
2'-2"
2'-4"
WHIRLPOOL TUB 5'-6"
SHELF
TEMPERED ENCLOSURE
BRICK LEDGE
(2) 2-4 x 5-2
OWNER'S BATH
TILE
9'-0" CLG.
LINEN
K/S
(3) 2-0 x 5-2
(2) 2-8 HDR.
2'-0"
6'-2"
2 x 8 @ 16" O.C.
4'-6"
3 STUDS
SUITE FOUR
9'-0" CLG.
CARPET
15'-8"
2 x 8 @ 16" O.C.
OWNER'S SUITE
9'-0" CLG.
CARPET
2 x 8 @ 16" O.C. TO RAFTER
HIS CLOSET
CARPET
HER CLOSET
CARPET
2-4 PKT.
(2) 2 x 10 HDR.
(2) 3 x 9
2-0
CLOSET
CARPET
BATH
2-8 x 4-6
11'-4"
5'-4"
2'-3"
21'-2"
6'-10"
3'-6"
3'-2"
2'-6"
5'-10"

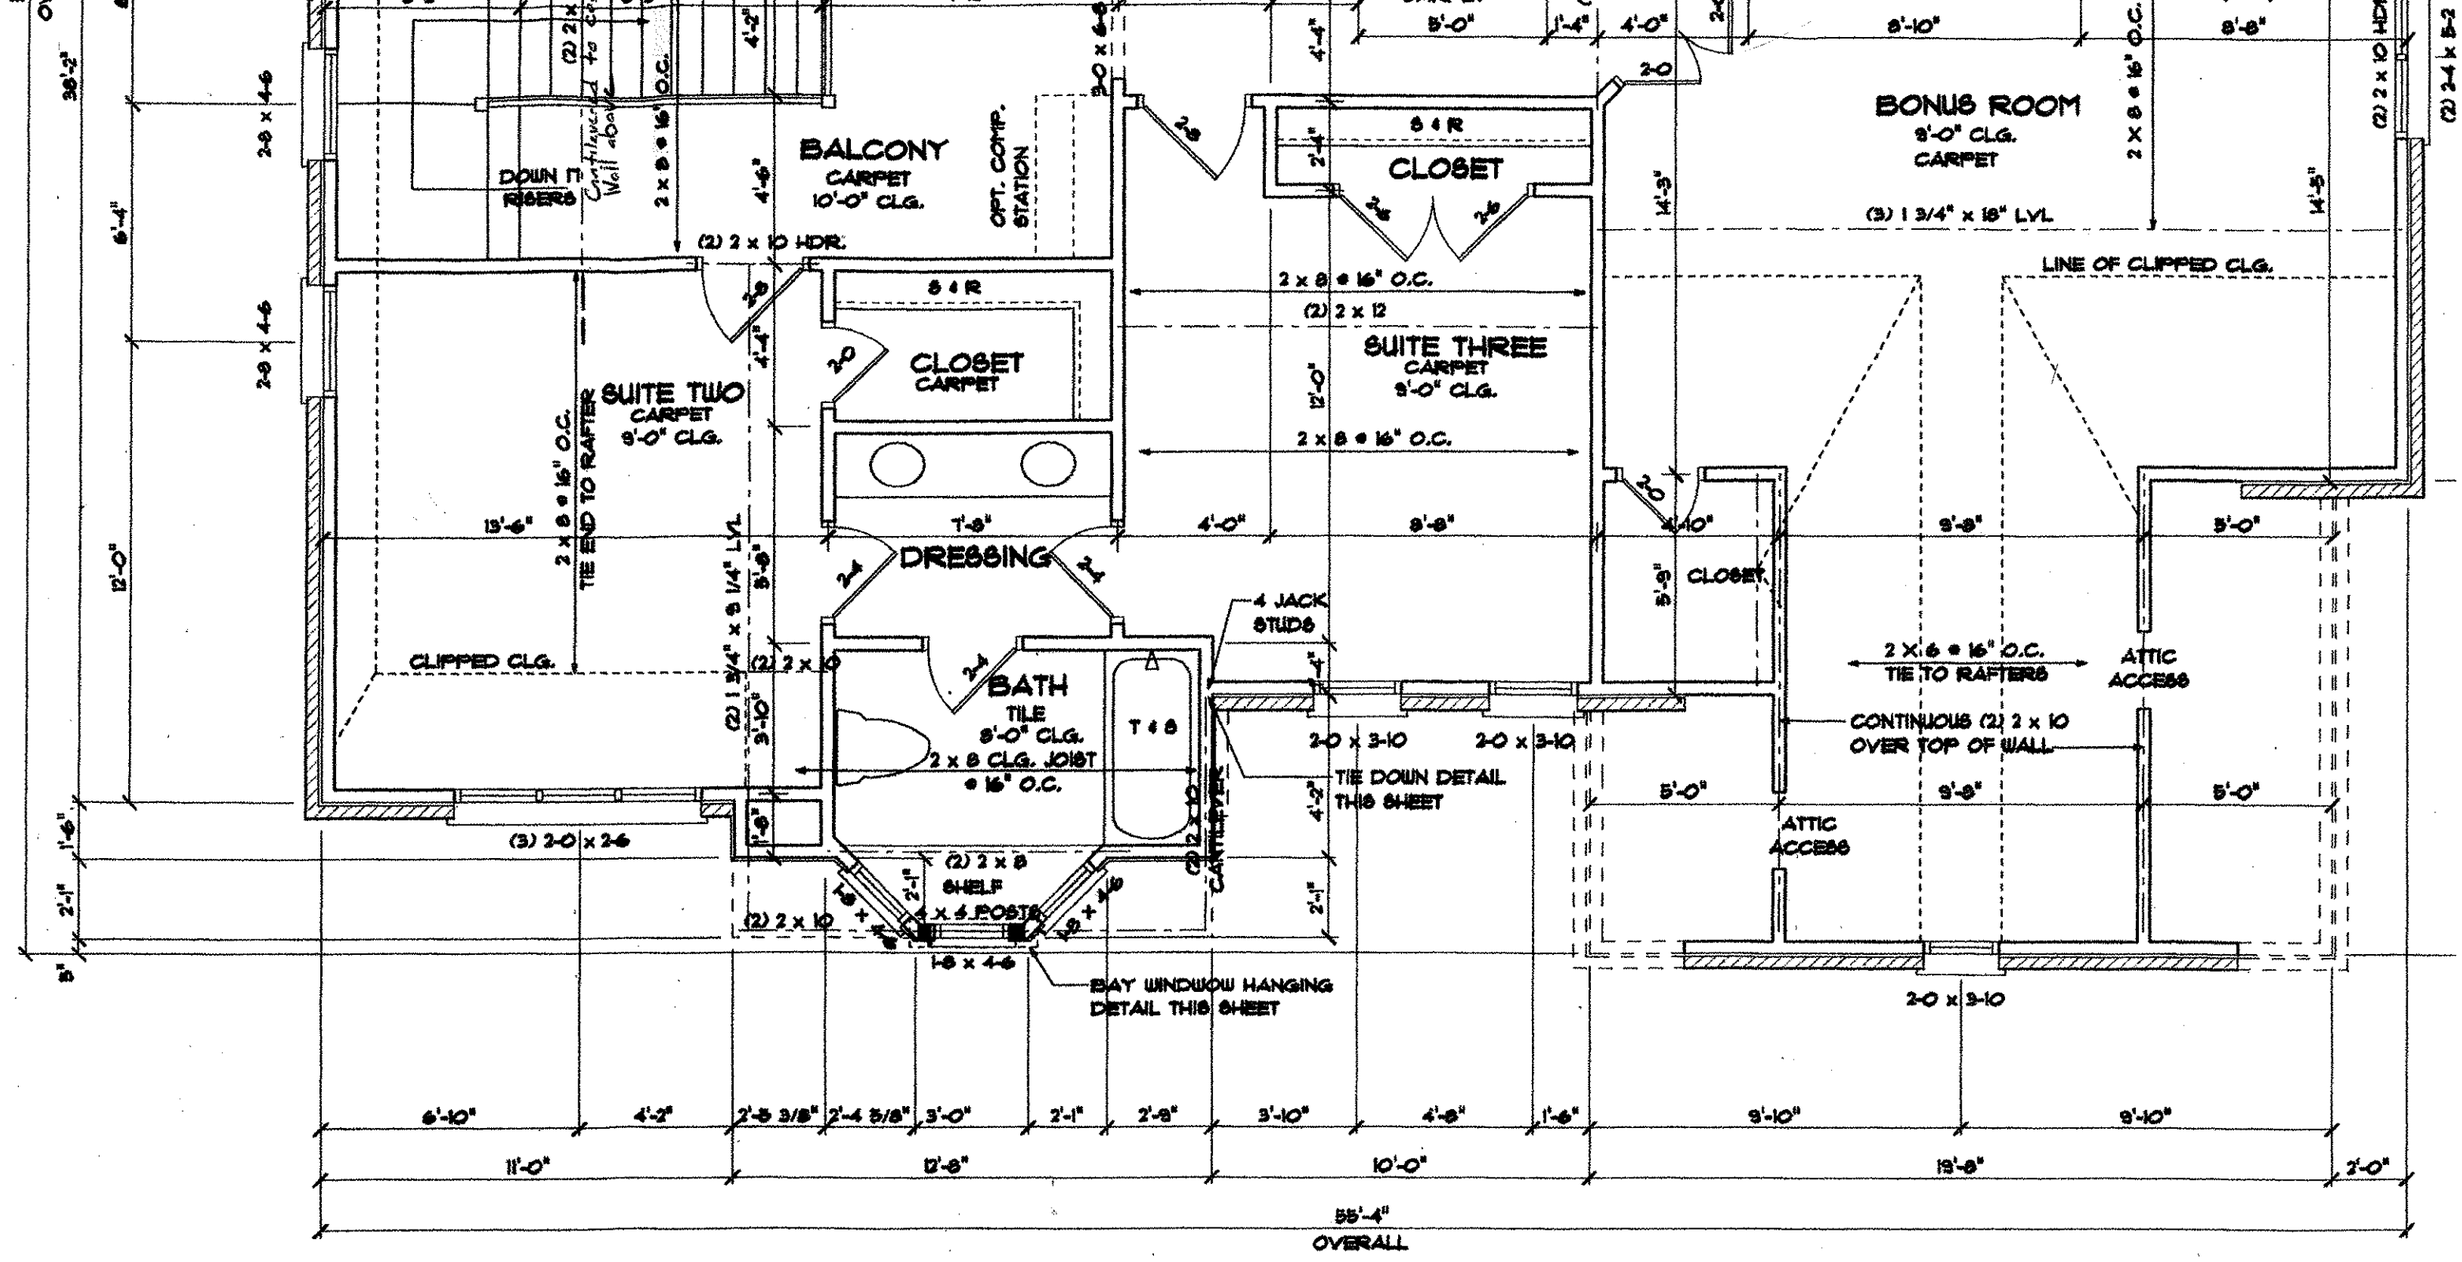

SECOND FLOOR PLAN

SCALE: 1/4" = 1'-0"

IREDELL COUNTY HEALTH DEPARTMENT

STATESVILLE 704-878-5305 MOORESVILLE 704-664-5281

IMPROVEMENT PERMIT / AUTHORIZATION TO CONSTRUCT / OPERATION PERMIT / EXISTING SYSTEM INSPECTION

PERMIT# 105428 PIN# 4624 27 5905.457 4624 28 8659 DATE 5/7/02

OWNER OR CONTRACTOR POINT ON NORMAN / KINGSWOOD CUSTOM HOMES PHONE: Business ~~660-1155~~ Home 704-506-3456

ADDRESS 2214 BRAWLEY SCHOOL RD - MOORESVILLE NC 28115 / 8033 Corporate Center Dr. Ste 400 Charlotte, NC. 28226

LOCATION BRAWLEY SCHOOL - TR MANSFIELD - TR HARWICK - ON LEFT

SUBDIVISION POINT BLOCK / SECTION 9 LOT 957 LOT AREA 1.18 AC SITE CLASS PS DESIGN FLOW 480GPD L.T.A.R. .25 gpd/sq ft

Septic Tank: 1500 Gallons; STB 338 Date 10/11/63

Pump Tank: _____ Gallons; PT _____ Date _____

Pump Make: _____ Model _____ Serial No. _____

Nitrification Field: No Fields 1 Square Feet 1440 Linear Feet 480

No Lines 4@120' Trench Width 36" Max Trench Bottom Depth 36" Gravel Depth N/A

☑ New System ☐ Repair System Type: I, II, III, IV, V, VI

System Description: GRAVITY ~~I-A/B~~ 15% REDUCTION

Repair System Description: LD DANEC

Maintenance Agreement Required: ☐ Yes ☑ No

☑ House/Mod. Home ☐ Mobile Home ☐ Business ☐ Other

No. Bedrooms 4 No. Bathrooms 4 No. Employees ____

☐ Slab ☑ Crawl Space ☐ Basement w/plumbing ☐ Basement wo/plumbing


Water Supply: ☐ Individual ☐ Public ☑ Community

Comments:/Conditions:


1" = 50'

Comments:/Conditions: EZ FLOW INSTALLED

INITIAL SITE SKETCH

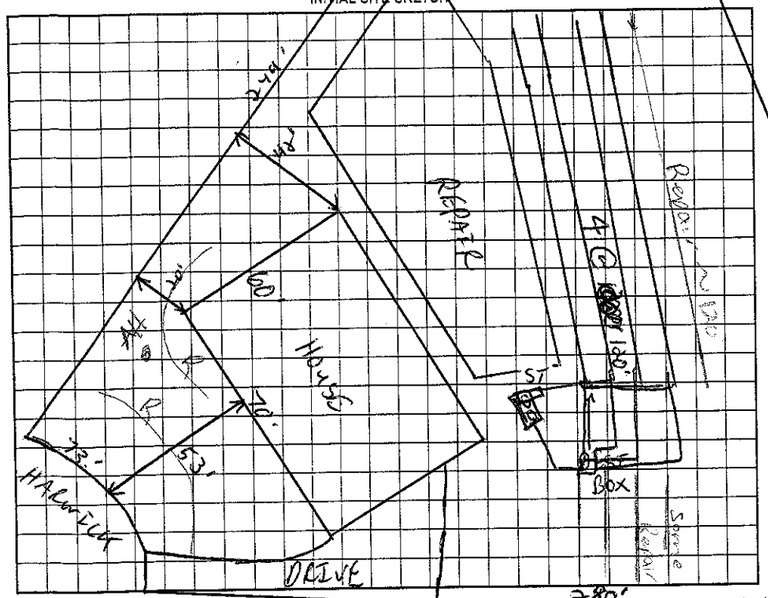

AS BUILT SKETCH

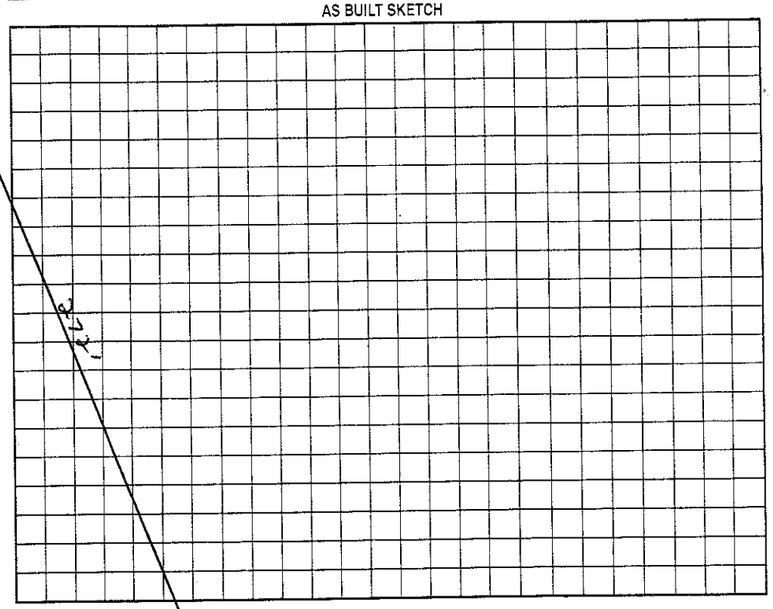

Permit can be suspended or revoked if any false information is supplied toward securing the permit/any unauthorized changes are made to the site/any unauthorized changes are made in the installation of the system. Improvement Permit with plat valid without expiration. Improvement Permit with site plan valid for sixty months. Authorization to Construct is valid for a period equal to that of Improvement Permit – not to exceed sixty months.

Signed: _____ date 5-23-02 Installed by: Hallman

Improvement Permit by: _____ date 5/7/02 Operation Permit by: Wesley Sparks R.S. date 11/18/03

Authorization to Construct by: Wesley Sparks RS date 6/4/03 Existing System Inspection by: _____ date _____

HEALTH DEPT. COPY: WHITE OWNER COPY (FINAL): YELLOW OWNER COPY (INITIAL): PINK