131

ADDRESS 311 BRAWLEY SCHOOL RD MOORESVILLE NC 28115 PHONE: Business 660 1113 Home

LOCATION BRAWLEY SCHOOL - TR 2nd MANSFIELD - TL BROUGHTON - TR DEDHAM - 6th on RT

SUBDIVISION POINT BLOCK / SECTION 9 LOT 964 LOT AREA 1.33AC SITE CLASS. PS DESIGN FLOW 480GPD L.T.A.R. .3660/F12

Septic Tank: 1000 gal Gallons: STB 444 Date 8-29-06

Pump Tank: ____ Gallons: PT ____ Date ____

Pump Make: ____ Model ____ Serial No. ____

Nitrification Field: No Fields 1 Square Feet 1200 Linear Feet 400

No Lines 4@100' Trench Width 36" Max Trench Bottom Depth 36" Gravel Depth N/A

☑ New System ☐ Repair System Type: I, II, III, IV, V, VI

System Description: GRAVITY 25% REDUCTION

Repair System Description: LP PANEL

Maintenance Agreement Required: ☐ Yes ☑ No

~~☐ House/Mod. Home~~ No. Bedrooms 4

☐ Mobile Home No. Bathrooms 4

☐ Business No. Employees ____

☐ Other ____


☐ Slab ☑ Crawl Space ☐ Basement w/plumbing ☐ Basement wo/plumbing

Water Supply: ☐ Individual ☐ Public ~~☑ Community~~

Comments:/Conditions:


1" = 50'

INITIAL SITE SKETCH

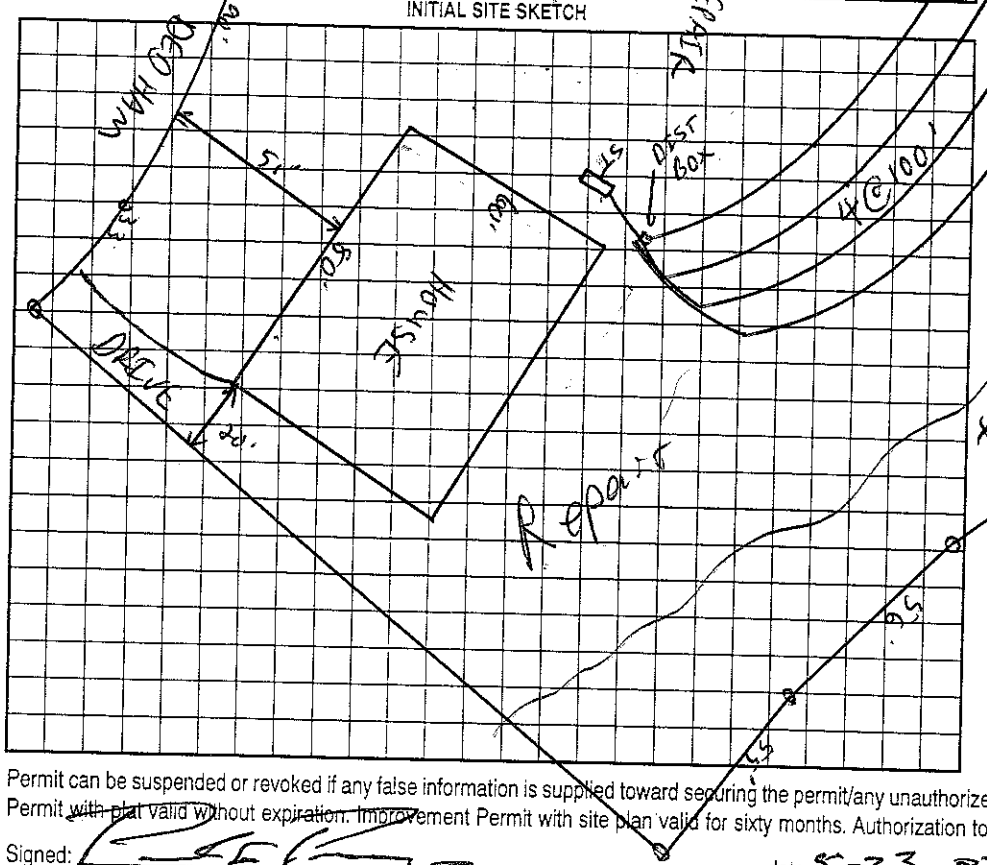

Comments:/Conditions:

AS BUILT SKETCH

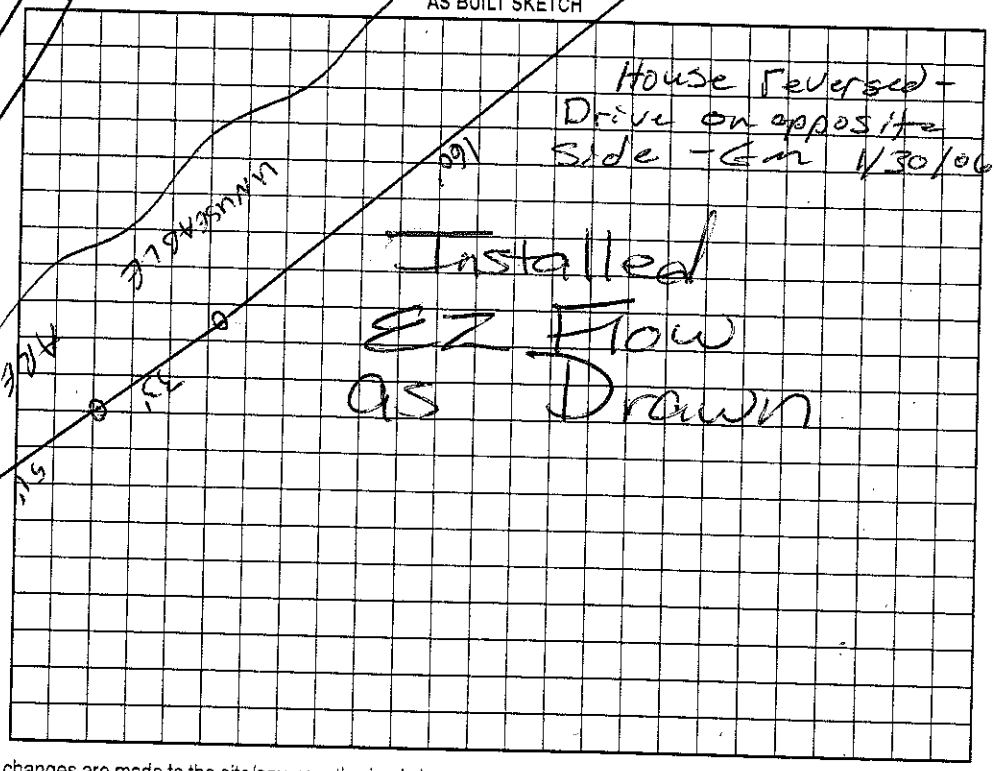

Permit can be suspended or revoked if any false information is supplied toward securing the permit/any unauthorized changes are made to the site/any unauthorized changes are made in the installation of the system. Improvement Permit ~~with plat~~ valid ~~without expiration~~. Improvement Permit with site plan valid for sixty months. Authorization to Construct is valid for a period equal to that of Improvement Permit – not to exceed sixty months.

Signed: ____ date 5-23-02

Improvement Permit by: ____ date 5/8/02

Authorization to Construct by: ____ date 7/31/03

Installed by: R&H

Operation Permit by: ____ date 10/13/06

Existing System Inspection by: ____

HEALTH DEPT. COPY: WHITE OWNER COPY (FINAL): YELLOW