IREDELL COUNTY HEALTH DEPARTMENT

IMPROVEMENT PERMIT / AUTHORIZATION TO CONSTRUCT / OPERATION PERMIT / EXISTING SYSTEM INSPECTION

STATESVILLE 704-878-5305 MOORESVILLE 704-664-5281

3/3

PERMIT# 105436 PIN# 4624 27 5905.963 4624 29 2267

OWNER OR CONTRACTOR POINT ON NORMAN / Simmons Bldrs. PHONE: Business 660-1185 Home

ADDRESS 2214 BRAWLEY SCHOOL RD - MOORESVILLE 28117 DATE 5/8/02

LOCATION BRAWLEY SCHOOL - TR 2nd MANSFIELD - TL BROCKTON - TR DEDHAM LOOP - 5TH ON RT

SUBDIVISION POINT BLOCK / SECTION 9 LOT 963 LOT AREA 1.36AC SITE CLASS PS DESIGN FLOW 480GPD L.T.A.R. .36PP/FT

Septic Tank: 1000+ Gallons; STB 338 Date 6-2-04

Pump Tank: Gallons; PT Date

Pump Make: Model Serial No.

Nitrification Field: No Fields 1 Square Feet 1200 Linear Feet 400

No Lines 4@100' Trench Width 36" Max Trench Bottom Depth 36" Gravel Depth 1/4

☑ New System ☐ Repair System Type: I, II, III, IV, V, VI

System Description: GRAVITY 25% REDUCTION

Repair System Description: LP PANEL

Maintenance Agreement Required: ☐ Yes ☑ No

☐ Slab ☑ Crawl Space ☑ Basement w/plumbing ☐ Basement wo/plumbing

☑ House/Mod. Home No. Bedrooms 4

☐ Mobile Home No. Bathrooms 4

☐ Business No. Employees


☐ Other

Water Supply: ☐ Individual ☐ Public ☑ Community


Comments:/Conditions:
10-9-03 Homeplan substantially in Compliance w/ IP.

Comments:/Conditions: Checked tank & lines

INITIAL SITE SKETCH

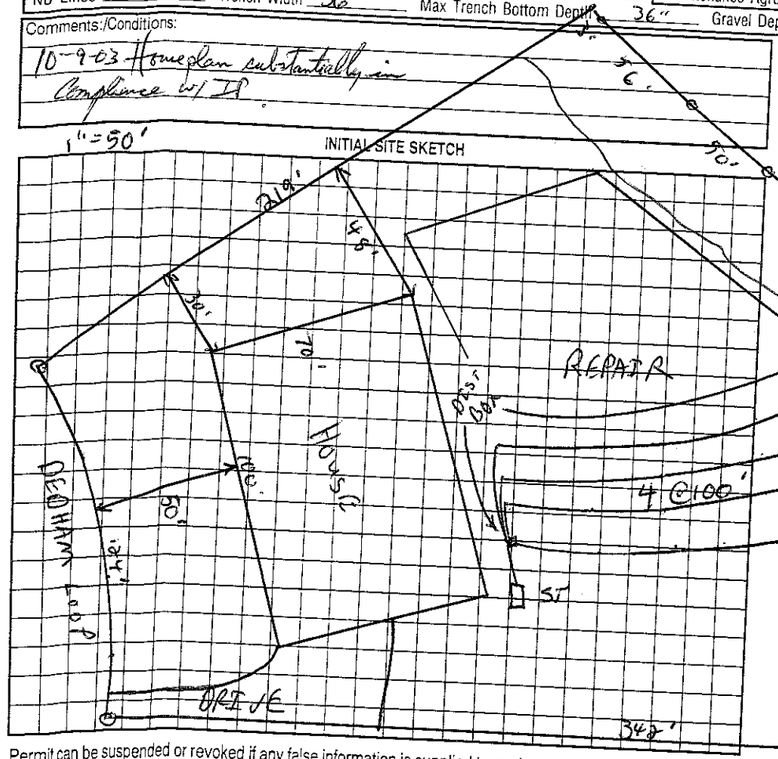

AS BUILT SKETCH

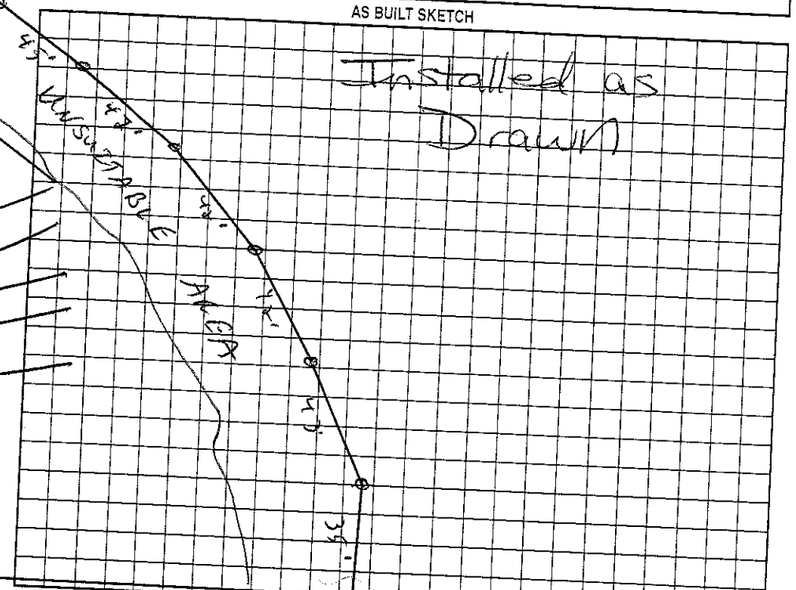

Permit can be suspended or revoked if any false information is supplied toward securing the permit/any unauthorized changes are made to the site/any unauthorized changes are made in the installation of the system. Improvement Permit with plat valid without expiration. Improvement Permit with site plan valid for sixty months. Authorization to Construct is valid for a period equal to that of Improvement Permit – not to exceed sixty months.

Signed: date 5-23-02

Improvement Permit by: date 5/8/02

Authorization to Construct by: date 10-9-03

Installed by: R & H R S

Operation Permit by: date 7/12

Existing System Inspection by: date

HEALTH DEPT. COPY: WHITE OWNER COPY (FINAL): YELLOW OWNER COPY (INITIAL): PINK