IREDELL COUNTY HEALTH DEPARTMENT

STATESVILLE 704-878-5305 MOORESVILLE 704-664-5281

IMPROVEMENT PERMIT / AUTHORIZATION TO CONSTRUCT / OPERATION PERMIT / EXISTING SYSTEM INSPECTION

PERMIT# 105435 PIN# 4624.27.5905.962 9624 29 4243 DATE 5/8/02

OWNER OR CONTRACTOR POINT ON NORMAN/BURGWIN Bldrs. PHONE: Business 660-1185 Home

ADDRESS 2214 BRAWLEY SCHOOL RD - MOORESVILLE 28117

LOCATION BRAWLEY SCHOOL - TR 2nd MANFIELD - TL BROUGHTON - TL DEDHAM - 4TH ON RT

SUBDIVISION POINT BLOCK / SECTION 9 LOT 962 LOT AREA 1.49AC SITE CLASS. PS DESIGN FLOW 480GPD L.T.A.R. .36GPD/FT²

Septic Tank: 1000+ Gallons; STB 338 Date 7-23-04

Pump Tank: Gallons; PT Date

Pump Make: Model Serial No.

Nitrification Field: No Fields 1 Square Feet 1200 Linear Feet 400

No Lines 4@100' Trench Width 36" Max Trench Bottom Depth 36" Gravel Depth N/A

☑ New System ☐ Repair System Type: I, II, III, IV, V, VI

System Description: GRAVITY 25% REDUCTION

Repair System Description: PUMP SAME

Maintenance Agreement Required: ☐ Yes ☑ No

☐ Slab ☑ Crawl Space ☑ Basement w/plumbing ☐ Basement wo/plumbing

☑ House/Mod. Home No. Bedrooms 4

☐ Mobile Home No. Bathrooms 4

☐ Business No. Employees

☐ Other


Water Supply: ☐ Individual ☐ Public ☐ Community

Comments:/Conditions: 10-09-03 Home plan substantially in compliance w/ IP Dwt 342'


Comments:/Conditions: Installed EZ Flow for Drainfield as Drawn

1"=50'

INITIAL SITE SKETCH

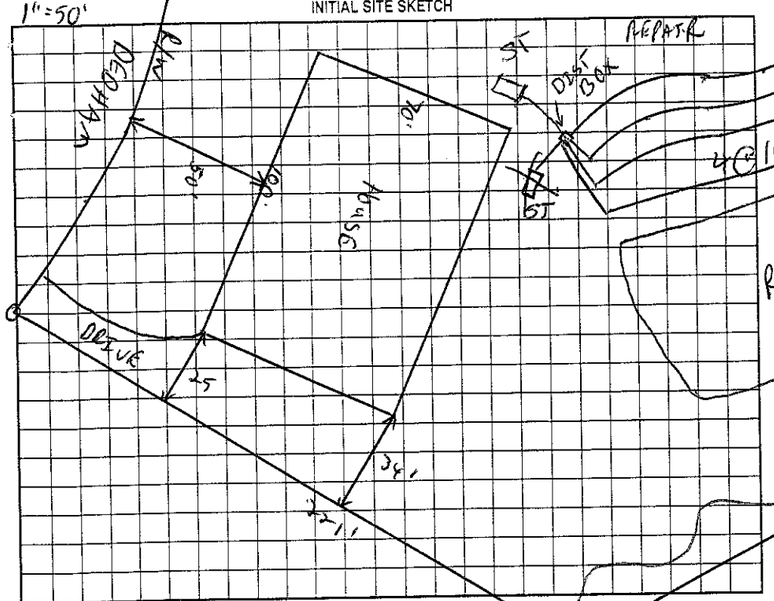

AS BUILT SKETCH Exist. System done 4/28/05

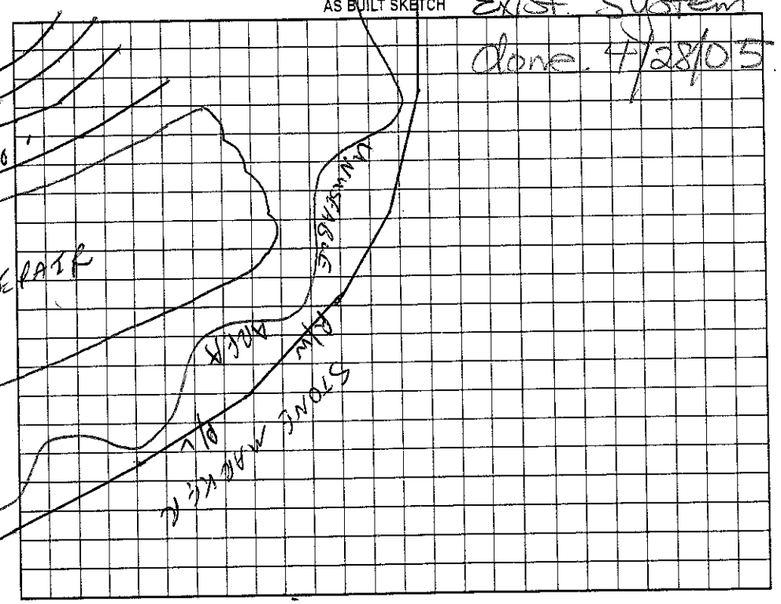

Permit can be suspended or revoked if any false information is supplied toward securing the permit/any unauthorized changes are made to the site/any unauthorized changes are made in the installation of the system. Improvement Permit with plat valid without expiration. Improvement Permit with site plan valid for sixty months. Authorization to Construct is valid for a period equal to that of Improvement Permit – not to exceed sixty months.

Signed: date 5-25-05

Improvement Permit by: RS date 5/8/02

Authorization to Construct by: RS date 10-9-03

Installed by: R&T RS

Operation Permit by: Maria H. Dobson date 8/26/04

Existing System Inspection by: date

HEALTH DEPT. COPY: WHITE OWNER COPY (FINAL): YELLOW OWNER COPY (INITIAL): PINK