IREDELL COUNTY HEALTH DEPARTMENT

Statesville Office (704) 878-5305 Mooresville Office (704) 660-3625 PERMIT # 210763

IMPROVEMENT PERMIT / AUTHORIZATION TO CONSTRUCT / OPERATION PERMIT / EXISTING SYSTEM

PIN #: 4624295072

APPLICANT: Kent's Backyard Vision / Rob Miller APPLICANT ADDRESS: 2311 Village Lake Dr Charlotte NC 28212

SITE ADDRESS: 138 Dedham Lp/ Mooresville NC PHONE: ALT. PHONE: 704 900 1182

SITE DIRECTIONS: Brawley School Rd TR 2nd Mansfield TL Brockton TR Dedham LP 3rd on rt.

SUBDIVISION: The Point SECTION: 9 LOT # 961 LOT AREA: 1.19 Ac DESIGN FLOW: 480gpd L.T.A.R.: .25 gpd

Septic Tank 1500 (gal) STB Date
Pump Tank 1000 (gal) PT Date
Pump Make Model Serial #
Nitrification Fields 1 # Lines 4 @ 80ft Linear Ft: 320ft
Trench Width 24" Max. Trench Bottom Depth 36" Gravel Depth N/A


☐ New System ☐ Repair ☐ Expansion System Type: I II III IV V VI
System Description: Exist LP- Panel Block
Repair System Description: Same
Maintenance Agreement Required: ☒ YES ☐ NO
☐ GRAVITY ☒ PRESSURE

☒ Residence ☐ Business ☐ Other ☐ Slab ☒ Basement w/plumbing
No. Bedrooms 4 No. Persons 8 No. Employees
☐ Crawl Space ☐ Basement w/o plumbing


Water Supply: ☐ Private ☐ Public ☒ Community

Comments / Conditions: The proposed deck & porch extension does not appear to impact the existing Septic System. It meets setbacks to Septic

INITIAL SITE SKETCH

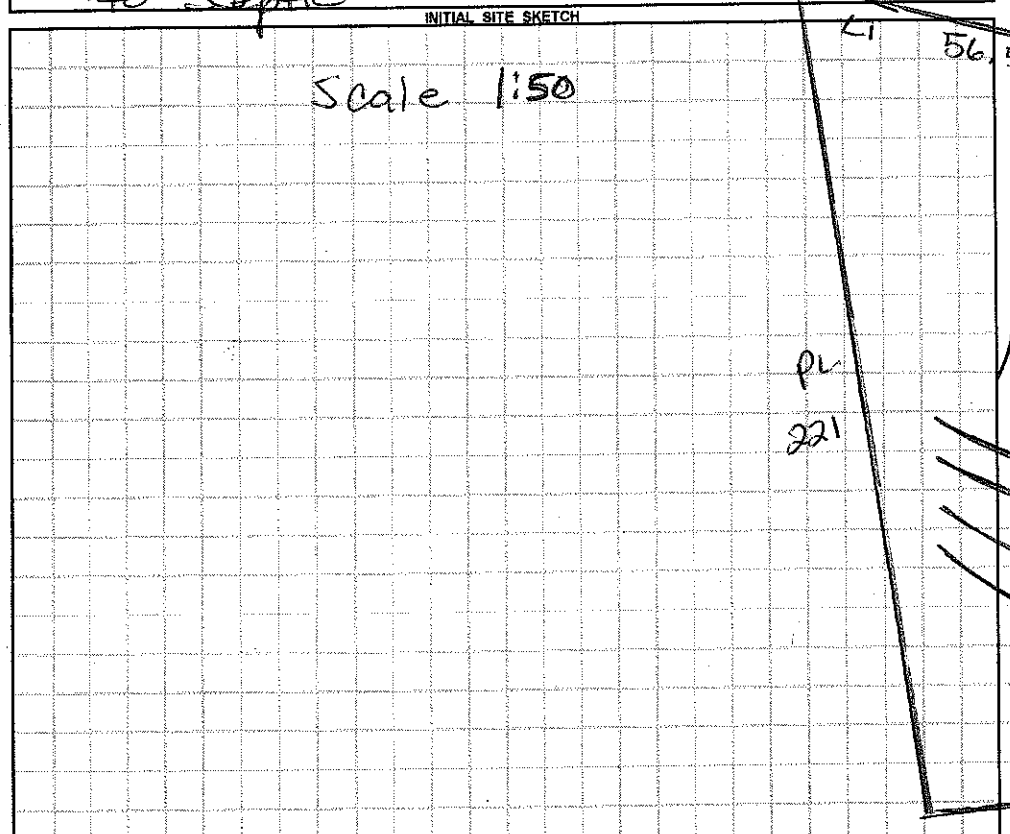

AS BUILT SKETCH

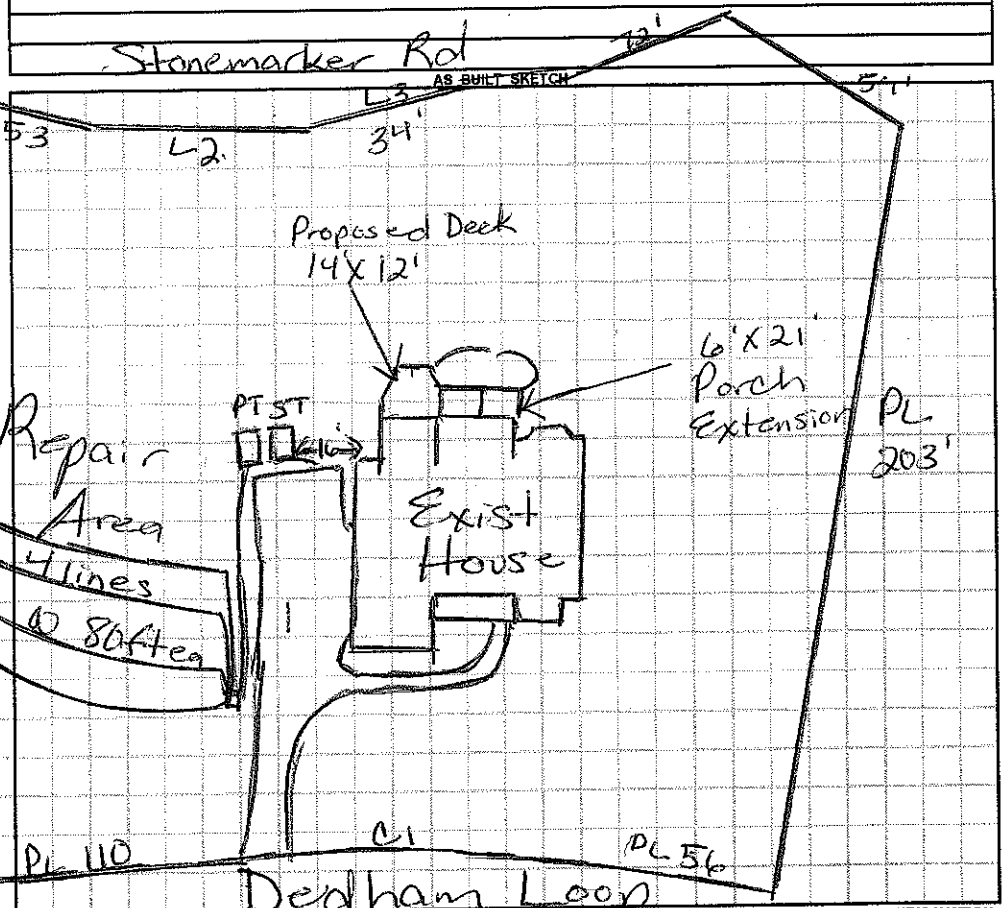

Permit can be suspended or revoked if any false information is supplied toward securing the permit / any unauthorized changes are made to the site / any unauthorized changes are made in the installation of the system. **CONTACT A LOCATOR SERVICE PRIOR TO ANY EXCAVATION**

☐ **IMPROVEMENT PERMIT** *with plat valid without expiration.* ☐ **IMPROVEMENT PERMIT** *with site plan valid for 60 mos.* ☐ **AUTHORIZATION TO CONSTRUCT** *valid for period equal to IMPROVEMENT PERMIT--not to exceed 60 mo.*

Owner / Applicant Signature: Jamia Miller Date: 6/23/15 Installed by:

IMPROVEMENT PERMIT by: Date: OPERATION PERMIT by: Date:

AUTHORIZATION TO CONSTRUCT by: Date: Existing System Inspected by: Mairead Dolan RS Date: 6/19/15

Health Dept. Copy - WHITE Applicant (Final Approval) - YELLOW Applicant (Conditional Approval) - PINK