ICHD - ENVIRONMENTAL HEALTH DIVISION

Statesville Office (704) 878-5305 | Mooresville Office (704) 660-3625 (MW) | PERMIT # 2022-11659

SEPTIC: IMPROVEMENT PERMIT / AUTHORIZATION TO CONSTRUCT / OPERATION PERMIT / EXISTING SYSTEM

PIN # 4624 -- 33 -- 5867 ✓

APPLICANT/OWNER: Bridget Castoria | APPLICANT ADDRESS: 203 Washam Rd, Mooresville

SITE ADDRESS: 203 Washam Rd, Mooresville 28117 ✓ | PHONE: 415-713-9017 | ALT. PHONE -

SITE DIRECTIONS: Brawley School - Washam | SAP CONTROLLED: ☐ YES ☐ NO


SUBDIVISION: Southpointe ✓ | SECTION: - | LOT # 1 ✓ | LOT AREA: 0.93 acres | DESIGN FLOW: EX | L.T.A.R.: EX

Septic Tank	1000 (gal)	STB 760	Date 3-2-23	☐ New System ☒ Repair ☐ Expansion	System Type: I II III (IV) V VI	☒ Residence	No. Bedrooms	EX	**Water Supply**
Pump Tank	1000 (gal)	PT 1000	Date 3-25-23	System Description:		☐ Business	No. Persons	EX	☒ Private
Pump Make		Model	Serial #	Repair System Description:	Tank Replacement	☐ Other	No. Employees		☐ Public
# Nitrification Fields	EX	# Lines EX	Linear Ft EX	Maintenance Agreement Required:	☒ YES ☐ NO	☒ Slab	☐ Crawl Space		☐ Community
Trench Width	EX	Trench Bottom Depth(Low side)	EX	Gravel Depth -	☐ GRAVITY ☒ PRESSURE	☐ Basement w/plumbing		☐ Basement w/o plumbing	

Comments / Conditions: Pump, crush, & fill old tanks. Keep tanks where positive drainage can be achieved.


* Recommend interceptor drain to catch water above system *

INITIAL SITE SKETCH

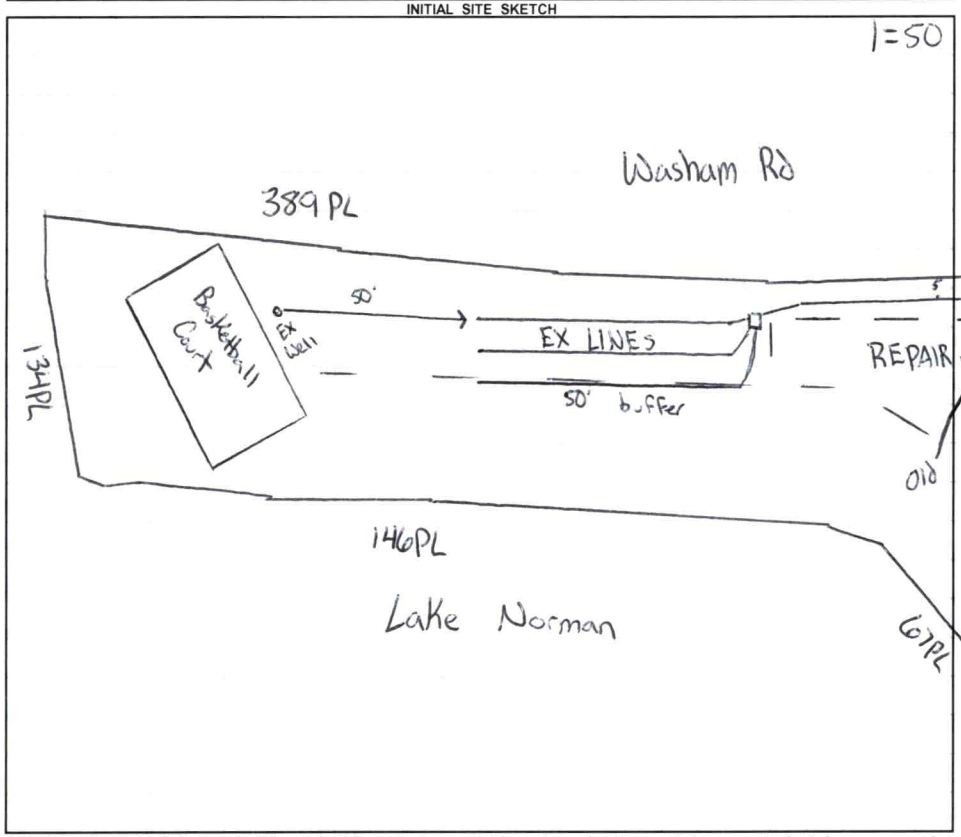

AS BUILT SKETCH

FOR SEPTIC FINAL INSPECTION CALL: 704-664-3703 between 8am-9am the day the inspection is needed. Be sure to speak with an inspector to confirm your time.

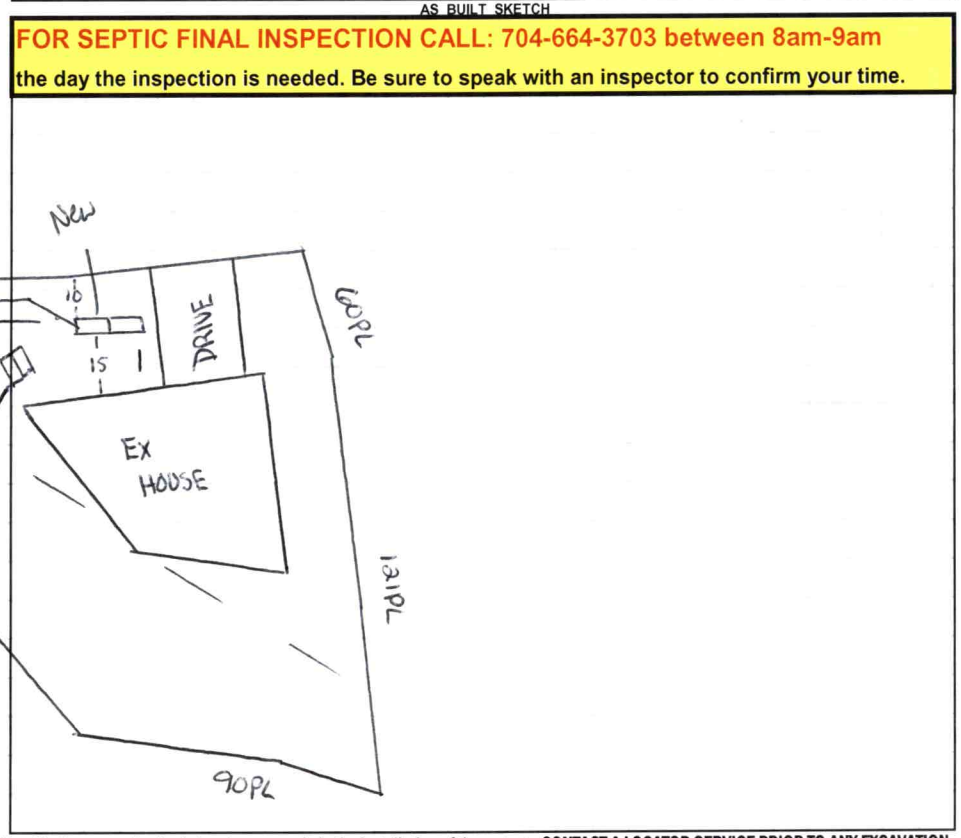

Permit can be suspended or revoked if any false information is supplied toward securing the permit / any unauthorized changes are made to the site / any unauthorized changes are made in the installation of the system. **CONTACT A LOCATOR SERVICE PRIOR TO ANY EXCAVATION**

☐ **IMPROVEMENT PERMIT** ***with plat*** *valid without expiration.* ☒ **IMPROVEMENT PERMIT** ***with site plan*** *valid for 60 mos.* ☒ **AUTHORIZATION TO CONSTRUCT** *valid for period equal to IMPROVEMENT PERMIT--not to exceed 60 mo.*

Owner / Applicant Signature: Online Signature | Date: | Installed by: Lentz

IMPROVEMENT PERMIT by: [signature] | Date: 3/13/23 | OPERATION PERMIT by: Sydney Holland | Date: 5/17/23

AUTHORIZATION TO CONSTRUCT by: [signature] | Date: 3/13/23 | Existing System Inspected by: | Date:

FOR SEPTIC FINAL INSPECTION: CALL 704-664-3703 between 8am-9am the day the inspection is needed.