SOUTHPOINTE (ONE WORD) 375.00 Paid 3130

IREDELL COUNTY HEALTH DEPARTMENT

STATESVILLE 704-878-5305 MOORESVILLE 704-664-5281

IMPROVEMENT PERMIT / AUTHORIZATION TO CONSTRUCT / OPERATION PERMIT / EXISTING SYSTEM INSPECTION

PERMIT# 117085 PIN# 4624-33-5867 DATE 12/5/03

OWNER OR CONTRACTOR W. M. Kellem / Carl + Kathy Smith PHONE: Business 704-873-2171 Home

ADDRESS 1227 Troutman Dr Statesville NC 28625

LOCATION BSR / TL 2nd Washam, on RT

SUBDIVISION South Pointe BLOCK / SECTION LOT 1 LOT AREA 0.934c SITE CLASS. PS DESIGN FLOW 360 L.T.A.R. 0.3

Septic Tank: 1000 Gallons; STB 525 Date 8/12/04

Pump Tank: 1000 Gallons; PT 302 Date 8/24/04

Pump Make: Zoeller Model N137-C Serial No. 137-0006

Nitrification Field: No Fields 1 Square Feet 420 Linear Feet 210

No Lines 3@70' Trench Width 24" Max Trench Bottom Depth 36" Gravel Depth —

☒ New System ☐ Repair System Type: I, II, III, (IV), V, VI

System Description: CP Panel Block

Repair System Description: None

Maintenance Agreement Required: ☒ Yes ☐ No

☒ House/Mod. Home ☐ Mobile Home ☐ Business ☐ Other

No. Bedrooms 3 No. Bathrooms 3 No. Employees


☐ Slab ☒ Crawl Space ☐ Basement w/plumbing ☐ Basement wo/plumbing

Water Supply: ☒ Individual ☐ Public ☐ Community


Comments:/Conditions:

Comments:/Conditions:

INITIAL SITE SKETCH

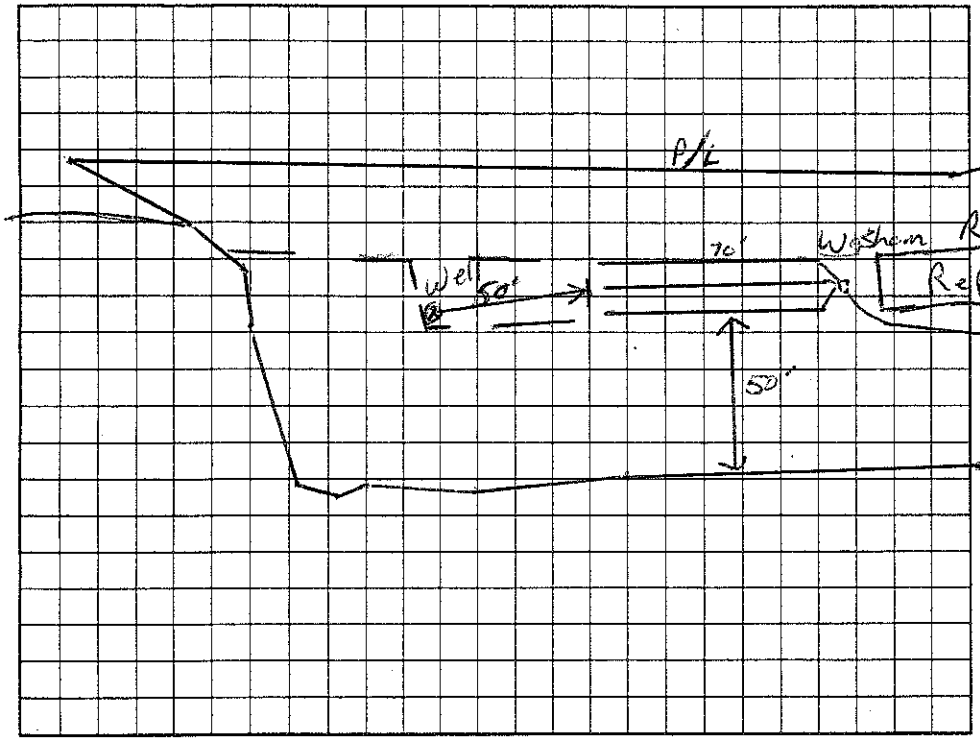

AS BUILT SKETCH

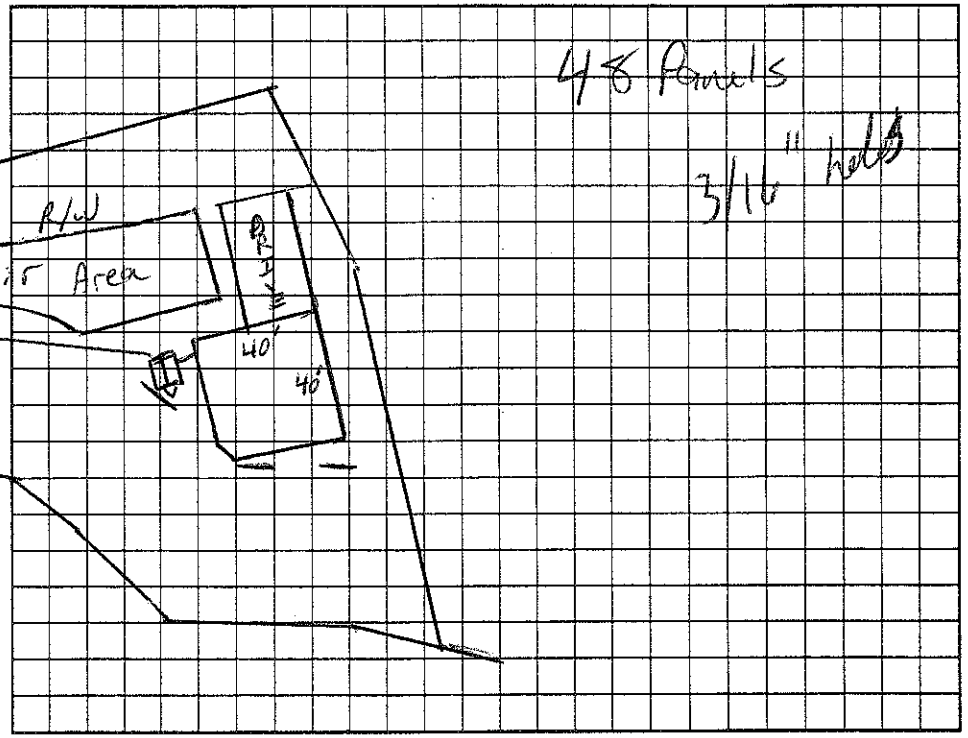

Permit can be suspended or revoked if any false information is supplied toward securing the permit/any unauthorized changes are made to the site/any unauthorized changes are made in the installation of the system. Improvement Permit with plat valid without expiration. Improvement Permit with site plan valid for sixty months. Authorization to Construct is valid for a period equal to that of Improvement Permit – not to exceed sixty months.

Signed: [signature] date 12-8-03 Installed by: Rowan Septic

Improvement Permit by: [signature] RS date 12/5/03 Operation Permit by: Wesley Sparks RS date 3/10/05

Authorization to Construct by: [signature] RS date 3/30/04 Existing System Inspection by: date

HEALTH DEPT. COPY: WHITE OWNER COPY (FINAL): YELLOW OWNER COPY (INITIAL): PINK