IREDELL COUNTY HEALTH DEPARTMENT

STATESVILLE 704-878-5305 375.00 Paid MOORESVILLE 704-664-5281

IMPROVEMENT PERMIT / AUTHORIZATION TO CONSTRUCT / OPERATION PERMIT / EXISTING SYSTEM INSPECTION

PERMIT# 117122 PIN# 4624-33-7705 DATE 12/5/03

OWNER OR CONTRACTOR W. M. Kellam / J+S Building Const. PHONE: Business 704-873-2171 Home

ADDRESS 1227 Trautman Dr. Statesville NC 28625

LOCATION 85R, TL 2nd Washam Rd, on Rt.

SUBDIVISION SouthPointe BLOCK / SECTION LOT 2 LOT AREA 0.70 SITE CLASS. PS DESIGN FLOW 480 L.T.A.R. 0.3

Septic Tank: 1050 Gallons; STB 704 Date 3/15/05

Pump Tank: 1000 Gallons; PT 283 Date 3/15/05

Pump Make: Liberty Model 283 Serial No.

Nitrification Field: No Fields 1 Square Feet 540 Linear Feet 270

No Lines 4 Trench Width 24" Max Trench Bottom Depth 36" Gravel Depth —

☒ New System ☐ Repair System Type: I, II, III, (IV) V, VI

System Description: LP Panel Block

Repair System Description: Same

Maintenance Agreement Required: ☒ Yes ☐ No

☒ House/Mod. Home No. Bedrooms 4

☐ Mobile Home No. Bathrooms 4

☐ Business No. Employees

☐ Other

☐ Slab ☒ Crawl Space ☐ Basement w/plumbing ☐ Basement wo/plumbing


Water Supply: ☒ Individual ☐ Public ☐ Community

Comments:/Conditions:


Comments:/Conditions:

60 Panel 3/16" holes

INITIAL SITE SKETCH

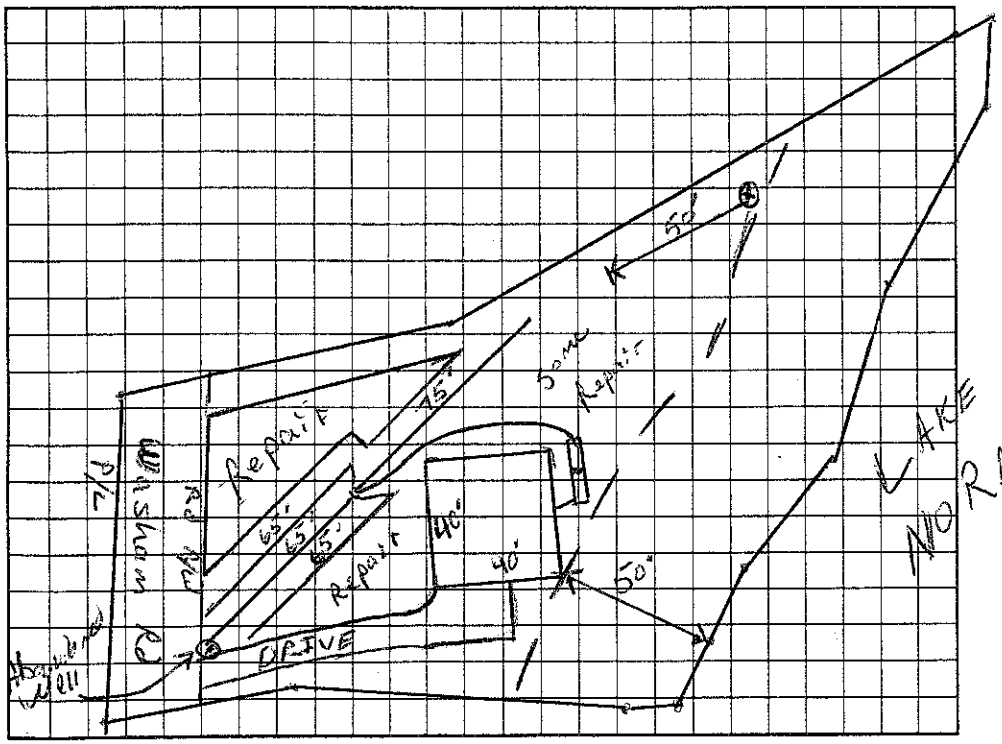

AS BUILT SKETCH

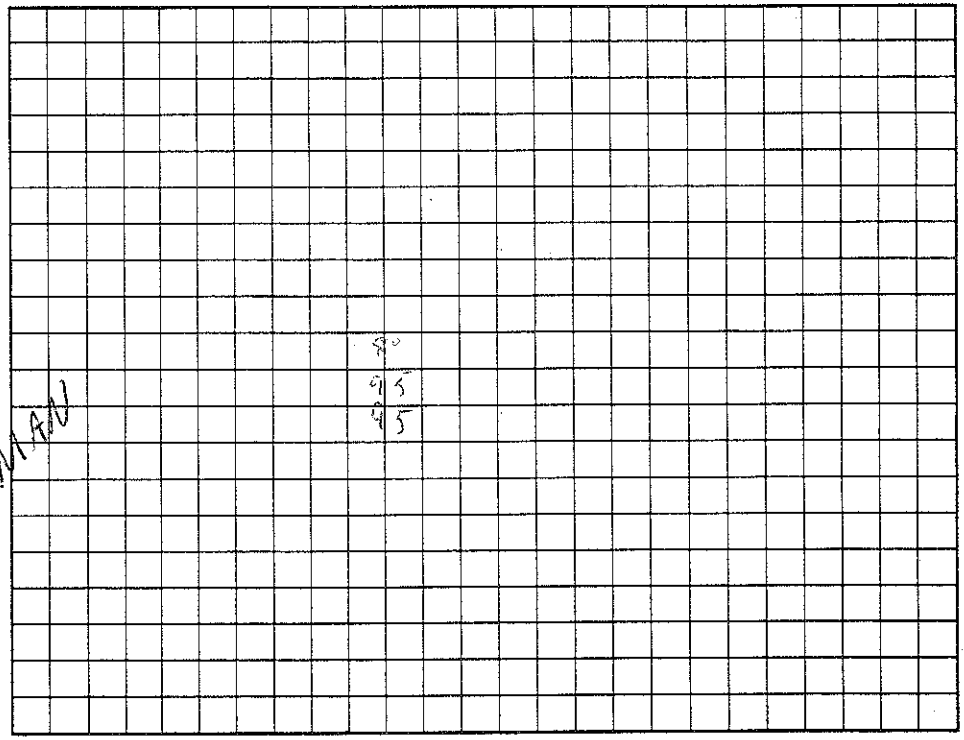

Permit can be suspended or revoked if any false information is supplied toward securing the permit/any unauthorized changes are made to the site/any unauthorized changes are made in the installation of the system. Improvement Permit with plat valid without expiration. Improvement Permit with site plan valid for sixty months. Authorization to Construct is valid for a period equal to that of Improvement Permit – not to exceed sixty months.

Signed: [signature] date 12-8-03 Installed by: Larry Hencle

Improvement Permit by: [signature] RS date 12/5/03 Operation Permit by: [signature] RS date 5/19/05

Authorization to Construct by: [signature] RS date 7/8/04 Existing System Inspection by: date

HEALTH DEPT. COPY: WHITE OWNER COPY (FINAL): YELLOW OWNER COPY (INITIAL): PINK