# IREDELL COUNTY HEALTH DEPARTMENT

STATESVILLE 704-878-5305 MOORESVILLE 704-664-5281

## IMPROVEMENT PERMIT / AUTHORIZATION TO CONSTRUCT / OPERATION PERMIT / EXISTING SYSTEM INSPECTION

PERMIT# 147420 PIN# 4624338710 DATE 1-25-08

OWNER OR APPLICANT Bruce Hartman PHONE: Business 704-664-1708 Home

ADDRESS 193 Washam Rd Mooresville NC 28117

LOCATION Brawley School Rd TL Washam Rd on left 193 Washam

SUBDIVISION Southpointe BLOCK / SECTION LOT 3 LOT AREA .69 Ac SITE CLASS. DESIGN FLOW L.T.A.R.

Septic Tank: Existing Gallons: STB Date

Pump Tank: Existing Gallons: PT Date

Pump Make: Model Serial No.

Nitrification Field: No Fields Square Feet Linear Feet

No Lines Trench Width Max Trench Bottom Depth Gravel Depth ☐ Gravity ☒ Pressure

☐ New System ☐ Repair ☐ Expansion System Type: I II III IV V VI

System Description: Existing 25% reduction

Repair System Description: LP PPBPS

Maintenance Agreement Required: ☐ Yes ☒ No not initially

☒ House/Mod. Home No. Bedrooms 4

☐ Mobile Home No. Persons 8

☐ Business No. Employees

☐ Other

Water Supply: ☒ Individual ☐ Public Existing ☐ Community

☐ Slab ☒ Crawl Space ☐ Basement w/plumbing ☐ Basement wo/plumbing


Comments:/Conditions:

Comments:/Conditions: Existing System refer to 2-10-04 permit # 111001 for original system specifications

INITIAL SITE SKETCH

AS BUILT SKETCH

1" = 60'

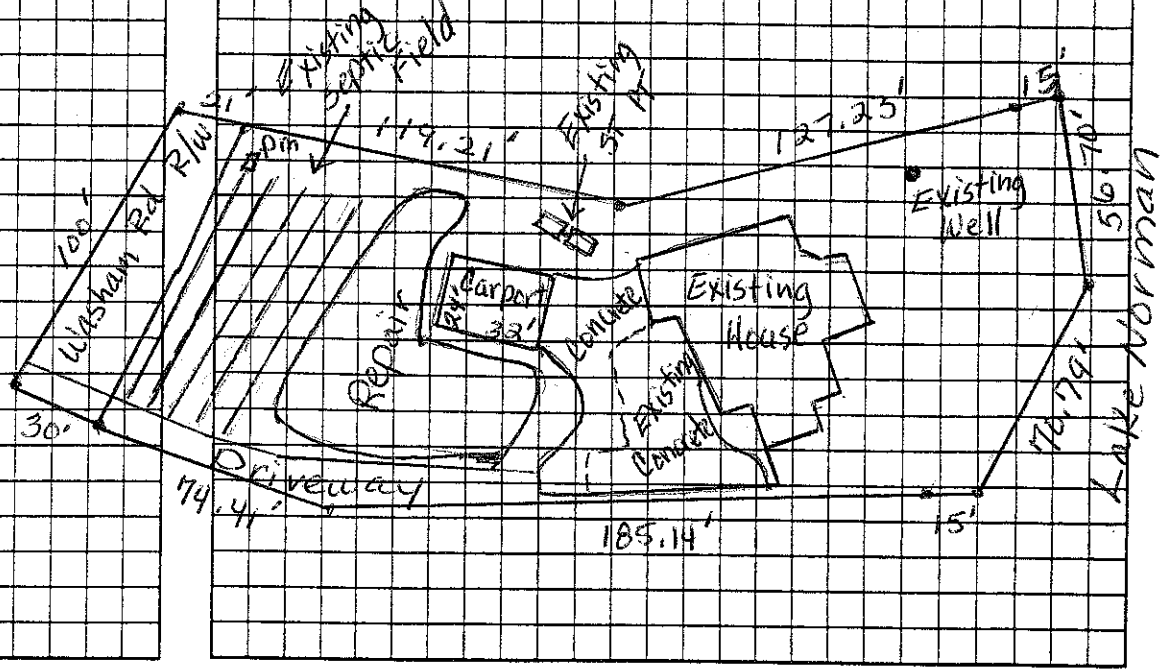


Permit can be suspended or revoked if any false information is supplied toward securing the permit/any unauthorized changes are made to the site/any unauthorized changes are made in the installation of the system. Improvement Permit with plat valid without expiration ☐ Improvement Permit with site plan valid for sixty months ☒ Authorization to Construct is valid for a period equal to that of Improvement Permit – not to exceed sixty months.

Signed: Julie Hartman date 1/28/08

Improvement Permit by: date

Authorization to Construct by: date

Installed by:

Operation Permit by: date

Existing System Inspection by: Judy Medlin date 1-25-08

HEALTH DEPT. COPY: WHITE OWNER COPY (FINAL): YELLOW OWNER COPY (INITIAL): PINK