IREDELL COUNTY HEALTH DEPARTMENT

...LLE 704-878-5305 130.00 Paid MOORESVILLE 704-664-5281

IMPROVEMENT PERMIT / AUTHORIZATION TO CONSTRUC... / OPERATION PERMIT / EXISTING SYSTEM INSPECT...

PERMIT# 111001 PIN# 4624338710 DATE 3-18-03

OWNER OR CONTRACTOR Spivey Construction Company Inc Brad PHONE: Business 704 363-0214 Home 860 537-4181

ADDRESS P.O. Box 6421 Denver, NC 28037

LOCATION Brawley School Rd. TL Washam Rd Property on left ~ 2miles

SUBDIVISION Southpointe BLOCK / SECTION ____ LOT 3 LOT AREA .69 Acre SITE CLASS. PS DESIGN FLOW 480gpd L.T.A.R. .3

Septic Tank: 1000 Gallons; STB 794 Date 9/13/03
Pump Tank: 1000 Gallons; PT 27 Date 9/7/03
Pump Make: Gould Model WE½-511 Serial No. 12/15/03
Nitrification Field: No Fields 1 Square Feet 1200' Linear Feet 400'
No Lines 5@80' Trench Width 36" Max Trench Bottom Depth 36" Gravel Depth 1/4

[X] New System [ ] Repair System Type: I, II, III, IV, V, VI
System Description: Pump-25% Reduction
Repair System Description: Pump- Innovative
Maintenance Agreement Required: [ ] Yes [ ] No


[X] House/Mod. Home No. Bedrooms 4
[ ] Mobile Home No. Bathrooms 3.5
[ ] Business No. Employees ____
[ ] Other ____
[ ] Slab [X] Crawl Space [ ] Basement w/plumbing [ ] Basement wo/plumbing

Water Supply: [X] Individual [ ] Public [ ] Community


Comments:/Conditions: Keep Septic System at least 10' From PL, 50' to lake & 50' to any well

Comments:/Conditions: Reviewed Building plans 5/22/03 Essentially in Compliance with IP Pump Tank Drainfield - 1/16/04

INITIAL SITE SKETCH Scale 1:60

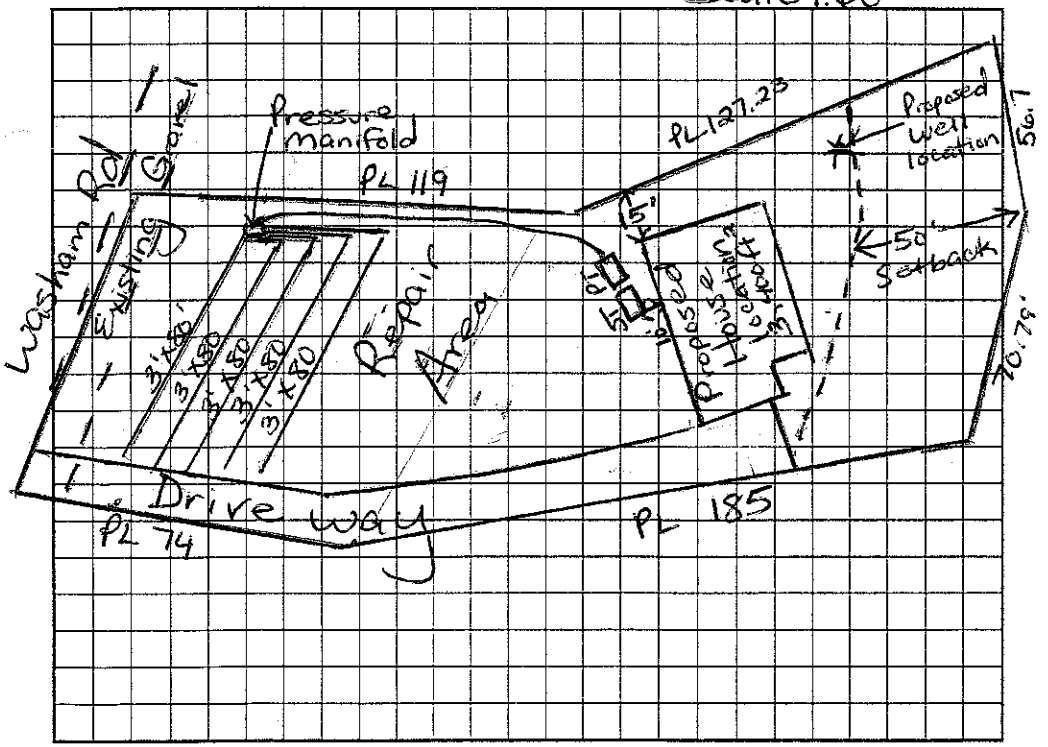

AS BUILT SKETCH

 

Permit can be suspended or revoked if any false information is supplied toward securing the permit/any unauthorized changes are made to the site/any unauthorized changes are made in the installation of the system. Improvement Permit with plat valid without expiration. Improvement Permit with site plan valid for sixty months. Authorization to Construct is valid for a period equal to that of Improvement Permit – not to exceed sixty months.

Signed: [signature] date 3/18/03 Installed by: C & S Grading

Improvement Permit by: [signature] RS date 3/18/03 Operation Permit by: Wesley Sparks RS. date 2/10/04

Authorization to Construct by: [signature] RS date 5/20/03 Existing System Inspection by: ____ date ____

HEALTH DEPT. COPY: WHITE OWNER COPY (FINAL): YELLOW OWNER COPY (INITIAL): PINK