IREDELL COUNTY HEALTH DEPARTMENT

Statesville Office (704) 878-5305 Mooresville Office (704) 660-3625 PERMIT # 216485

IMPROVEMENT PERMIT / AUTHORIZATION TO CONSTRUCT / OPERATION PERMIT / EXISTING SYSTEM

PIN # 4624-34-3228

APPLICANT: IQ Custom Construction APPLICANT ADDRESS: 840 Edmiston Rd Mt. Ulla

SITE ADDRESS: 222 Washam Rd PHONE: 704-578-4951 ~~ALT. PHONE:~~ Kathleen Saunders

SITE DIRECTIONS: BSR TL 2nd Washam, on L

SUBDIVISION: Washam Point SECTION: LOT # 12 LOT AREA: .934AC DESIGN FLOW: 480 L.T.A.R.: .25 (.3R)

Septic Tank 1000 (gal)	STB X25	Date 4-8-16	☑ New System ☐ Repair ☐ Expansion System Type: I II (III) IV V VI		☑ Residence	No. Bedrooms 4	Water Supply
Pump Tank (gal)	PT	Date	System Description: 25% Reduction		☐ Business	No. Persons	☑ Private
Pump Make	Model	Serial #	Repair System Description: Panel Block		☐ Other	No. Employees	☐ Public
# Nitrification Fields 1	# Lines 5	Linear Ft: 480'	Maintenance Agreement Required: ☐ YES ☒ ~~NO~~		☐ Slab	☒ Crawl Space	☐ Community
Trench Width 36"	Max. Trench Bottom Depth 24"	Gravel Depth	☒ GRAVITY ☐ PRESSURE		☐ Basement w/plumbing	☐ Basement w/o plumbing	


Comments / Conditions:

Ef-b Tuffite filter on a mid-seam tank

INITIAL SITE SKETCH

See Plan From The Oaks Group

AS BUILT SKETCH

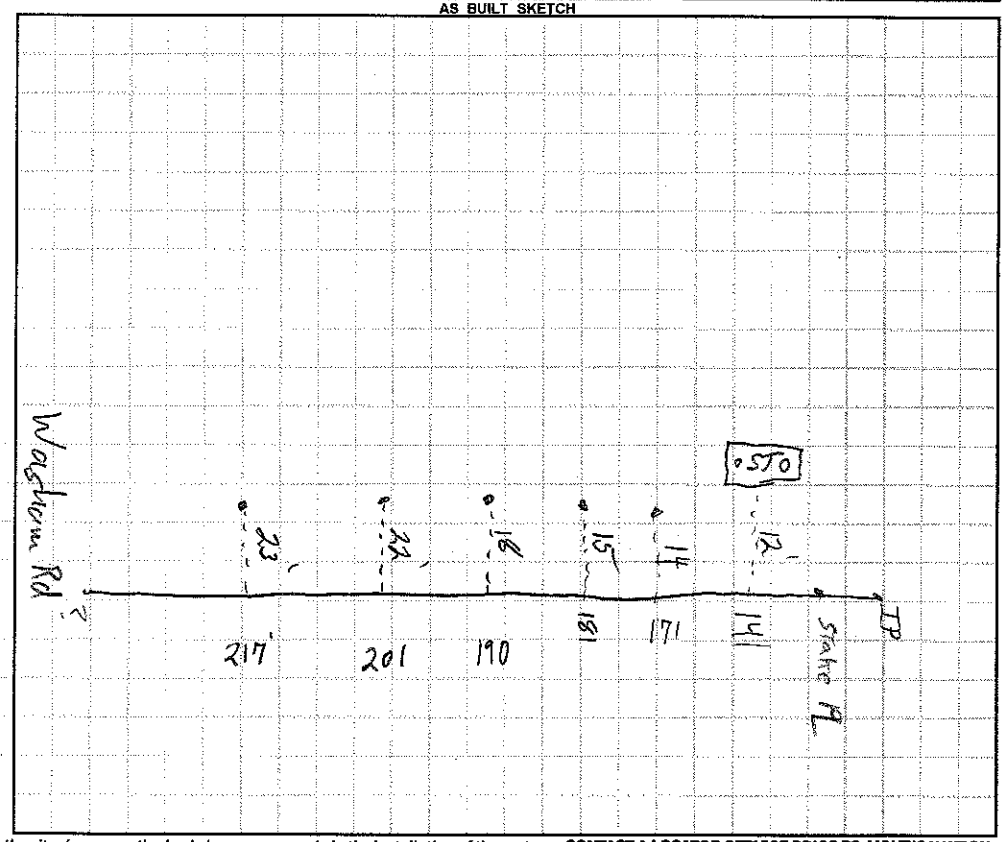

Permit can be suspended or revoked if any false information is supplied toward securing the permit / any unauthorized changes are made to the site / any unauthorized changes are made in the installation of the system. **CONTACT A LOCATOR SERVICE PRIOR TO ANY EXCAVATION**


☐ **IMPROVEMENT PERMIT** *with plat valid without expiration* ☐ **IMPROVEMENT PERMIT** *with site plan valid for 60 mos.* ☒ **AUTHORIZATION TO CONSTRUCT** *valid for period equal to IMPROVEMENT PERMIT--not to exceed 60 mo.*

Owner / Applicant Signature: Date: 2-12-16 Installed by: Rowan Septic Tank

IMPROVEMENT PERMIT by: APPROVED Date: FEB 10 2016 OPERATION PERMIT by: Wally Sparks + Tom Shuck Date: 6-13-16

AUTHORIZATION TO CONSTRUCT by: APPROVED Date: FEB 10 2016 Existing System Inspected by: Date:

Health Dept. Copy - WHITE Applicant (Final Approval) - YELLOW Applicant (Conditional Approval) - PINK

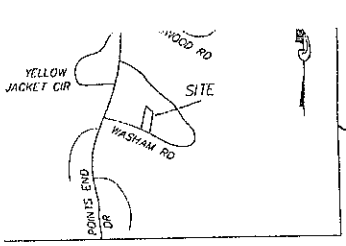

REGULATIONS PRIOR TO ANY PLANNING OR CONSTRUCTION.
3) ALL DISTANCES ARE HORIZONTAL GROUND DISTANCES UNLESS OTHERWISE NOTED.
4) ALL AREAS SHOWN HEREON WERE DETERMINED BY COORDINATE COMPUTATION.

CP = COMPUTED POINT (UNMARKED)
R/W = RIGHT-OF-WAY
EOP = EDGE OF PAVEMENT
C/L = CENTERLINE
= UTILITY POLE

CURVE TABLE				
CURVE	LENGTH	RADIUS	BEARING	CH
C1	137.74'	679.06'	N 61°05'40"W	137

LINE TABLE		
LINE	BEARING	DISTA
L1	N 55°17'00"W	19.0

APPROVED FEB 10 2016

DRAWN BY: SRW
DRAWING FILE NAME: 15214.WP12
PROJECT NO: 15214

HOUSE LOCATION PLAN FOR
IQ CUSTOM

HARRIS LAND SURVEYING,