IREDELL COUNTY HEALTH DEPARTMENT

Statesville Office (704) 878-5305 Mooresville Office (704) 660-3625

A2P Old # 145841

PERMIT # 212269

IMPROVEMENT PERMIT / AUTHORIZATION TO CONSTRUCT / OPERATION PERMIT / EXISTING SYSTEM

✓ PIN # 4624-34-4168

APPLICANT: Killy Lamine / Linnane Homes APPLICANT ADDRESS: 7300 Carmel Executive Park Charlotte

✓ SITE ADDRESS: 214 Washam ~~Point~~ Rd - Mrsvl PHONE: 704-400-9147 ALT. PHONE:

SITE DIRECTIONS: BSL TL 2ND Washam Point, on L

✓ SUBDIVISION: Washam Point SECTION: — LOT # 11 LOT AREA: .927 AC DESIGN FLOW: 600 L.T.A.R.: .3

Septic Tank	1500 (gal)	STB	338	Date	8-16-15	☑ New System ☐ Repair ☐ Expansion	System Type: I II III IV V VI	☑ Residence ☐ Business ☐ Other ☐ Slab ☐ Basement w/plumbing	No. Bedrooms 5 No. Persons No. Employees ☑ Crawl Space
Pump Tank	1500 (gal)	PT	477	Date	2-6-15	System Description:	PM 25% Reduction		
Pump Make	Liberty	Model	FL 5IM	Serial #		Repair System Description:	Same		
# Nitrification Fields	1	# Lines	7	Linear Ft:	520'	Maintenance Agreement Required:	☐ YES ☑ NO		
Trench Width	36"	Max. Trench Bottom Depth	36"	Gravel Depth	—		☐ GRAVITY ☑ PRESSURE		

☐ ☐ ☐ ☐ ☐ Water Supply: ☑ Private ☐ Public ☐ Community

☐ Basement w/o plumbing

Comments / Conditions: 10/2/15 Reviewed Floor plans, in Compliance with Septic plan

#1761-I 3/11/16 Checked tanks, lines & Set 3ft head Used ADS for Drainfield MD

INITIAL SITE SKETCH

See Plan From Kenny Owens

AS BUILT SKETCH

	Date	Initials
Drain Lines Checked	3/11/16	MD
Tanks Checked	3/11/16	MD
Pressure Manifold or Valve Box Checked	3/11/16	MD
Pressure Head Set	3/11/16	MD
Electrical Checked	4-29	BA
Floats Set		
Alarm Checked	4-29	BA
Maintenance Contract Y (N)		

Permit can be suspended or revoked if any false information is supplied toward securing the permit / any unauthorized changes are made to the site / any unauthorized changes are made in the installation of the system. **CONTACT A LOCATOR SERVICE PRIOR TO ANY EXCAVATION**


☐ **IMPROVEMENT PERMIT** *with plat valid without expiration.* ☑ **IMPROVEMENT PERMIT** *with site plan valid for 60 mos.* ☐ **AUTHORIZATION TO CONSTRUCT** *valid for period equal to IMPROVEMENT PERMIT--not to exceed 60 mo.*

Owner / Applicant Signature: Killy Lamine Date: 9-28-15 Installed by: Stevens Septic

IMPROVEMENT PERMIT by: [signature] Date: APPROVED SEP 10 2015 OPERATION PERMIT by: [signature] Date: APPROVED APR 29 2016

AUTHORIZATION TO CONSTRUCT by: [signature] RS Date: 10/2/15 Existing System Inspected by: Date:

Health Dept. Copy - WHITE Applicant (Final Approval) - YELLOW Applicant (Conditional Approval) - PINK

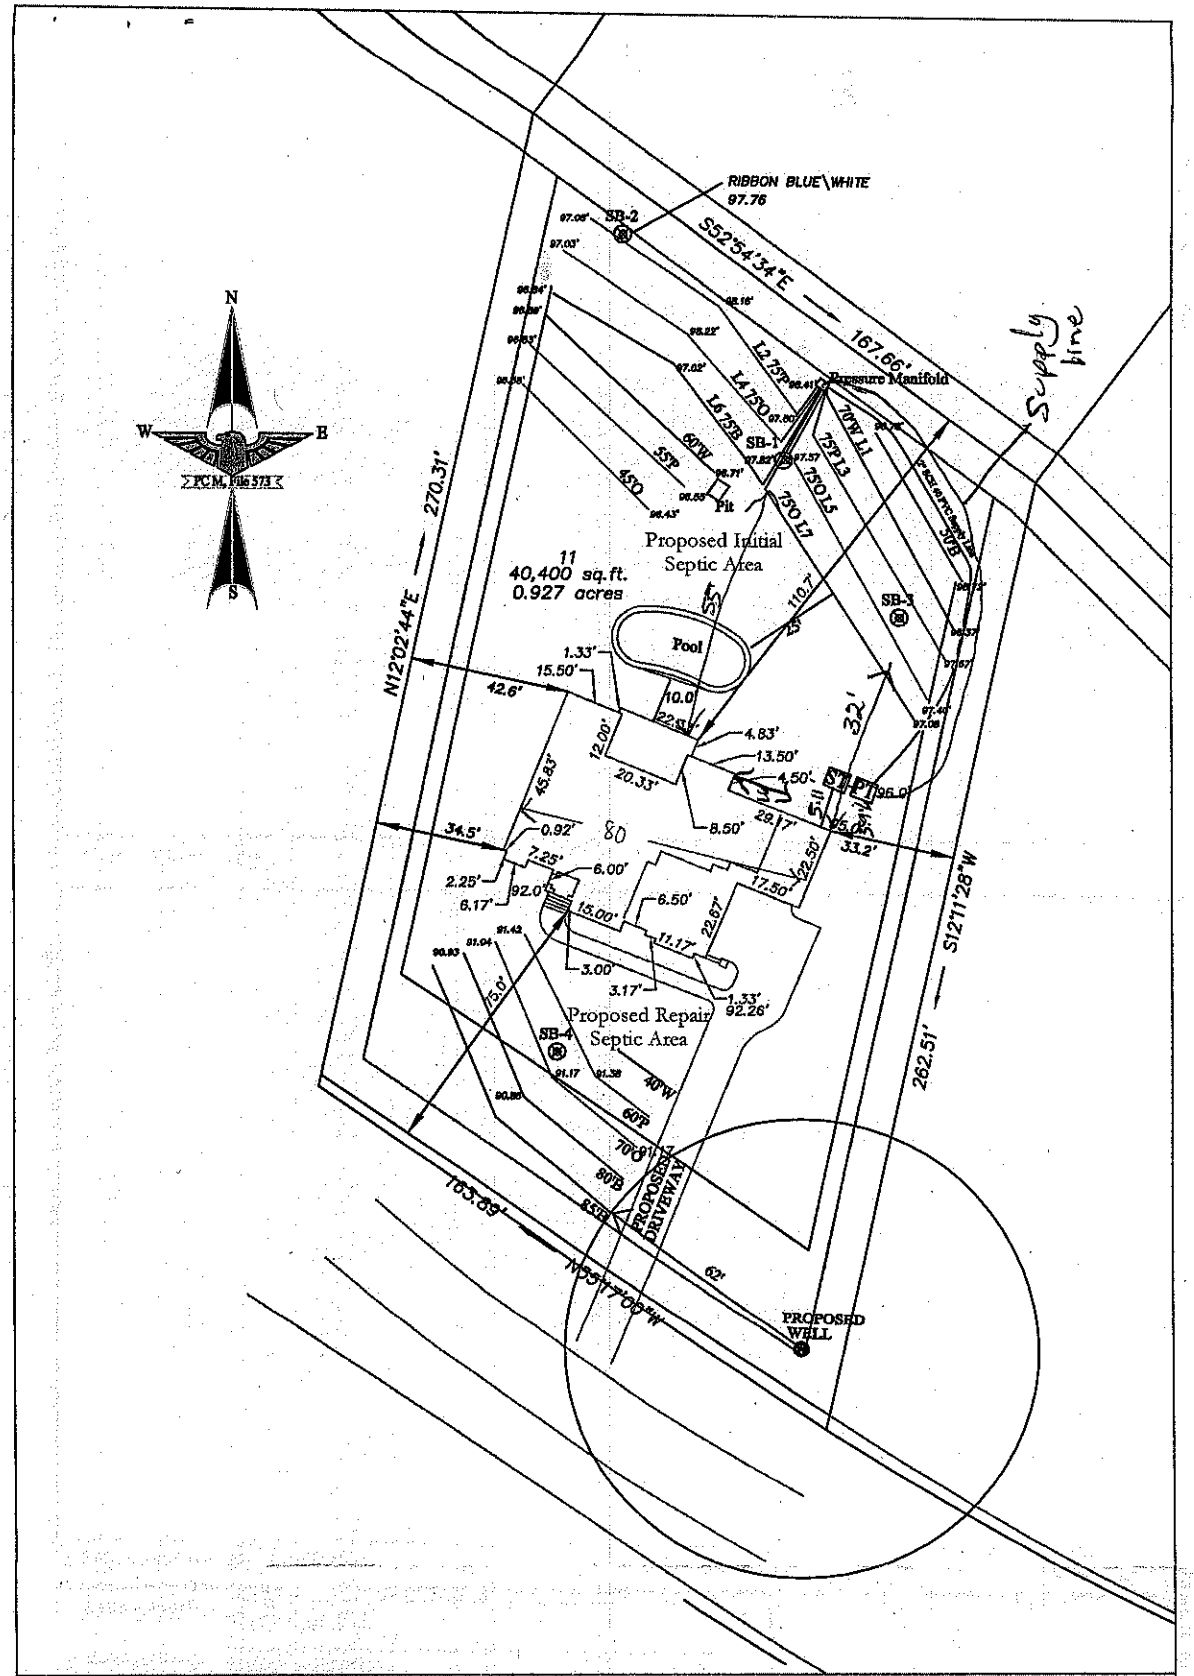

EAGLE ENGINEERING

2013-A Van Buren Ave.
Indian Trail, NC 28079
(704) 882-4222
www.eagleonline.net

PLOT PLAN

LOT 11, WASHAM POINT

DAVIDSON TOWNSHIP, IREDELL COUNTY, N.C.

SCALE 1" = 40'

FOR THE BENEFIT OF LINNANE CONSTRUCTION

MAP REFERENCE IN BOOK 52 PAGE 149

DEED REFERENCE IN BOOK 1899 PAGE 1432

EEI PROJECT NUMBER: