As built

IREDELL COUNTY HEALTH DEPARTMENT

STATESVILLE 704-878-5305 MOORESVILLE 704-664-5281

IMPROVEMENT PERMIT / AUTHORIZATION TO CONSTRUCT / OPERATION PERMIT / EXISTING SYSTEM INSPECTION

PERMIT # 146161 PIN # 4624346120.000 DATE 4/8/09

OWNER or APPLICANT Gary & Ginny Kane PHONE: Business 631-882-3778 Home: 704 662-6400

OWNER or APPLICANT ADDRESS 5 Hornbuy Dr. Port Jefferson Station NY 11776

LOCATION / DIRECTIONS Brawley School Rd. TL 2nd Washam Rd. entrance, 7th lot on Left

SUBDIVISION Washam Point BLOCK / SECTION LOT # 10 LOT AREA .442 DESIGN FLOW 480 L.T.A.R. .25

Septic Tank 1000 Gallons: STB 760 Date 10-3-08

Pump Tank Gallons: P T Date

Pump Make Model Serial #

Nitrification Field No Fields 1 No Lines 8 Linear Feet 436'

Trench Width 36" Max. Trench Bottom Depth 22" Gravel Depth N/A

☑ New System ☐ Repair ☐ Expansion System Type I II III IV V VI

System Description: Gravity 25% Reduction

Repair System Description: Grav/Pump 25% Reduction

Maintenance Agreement Required ☐ YES ☑ NO

☑ GRAVITY ☐ PRESSURE

☑ Residence No. Bedrooms 4

☐ Business No. Persons

☐ Other No. Employees

☐ Slab ☑ Crawl Space


☐ Basement w/plumbing ☐ Basement w/o plumbing

Water Supply: ☑ Private ☐ Public ☐ Community

Comments / Conditions


1"=50'

INITIAL SITE SKETCH

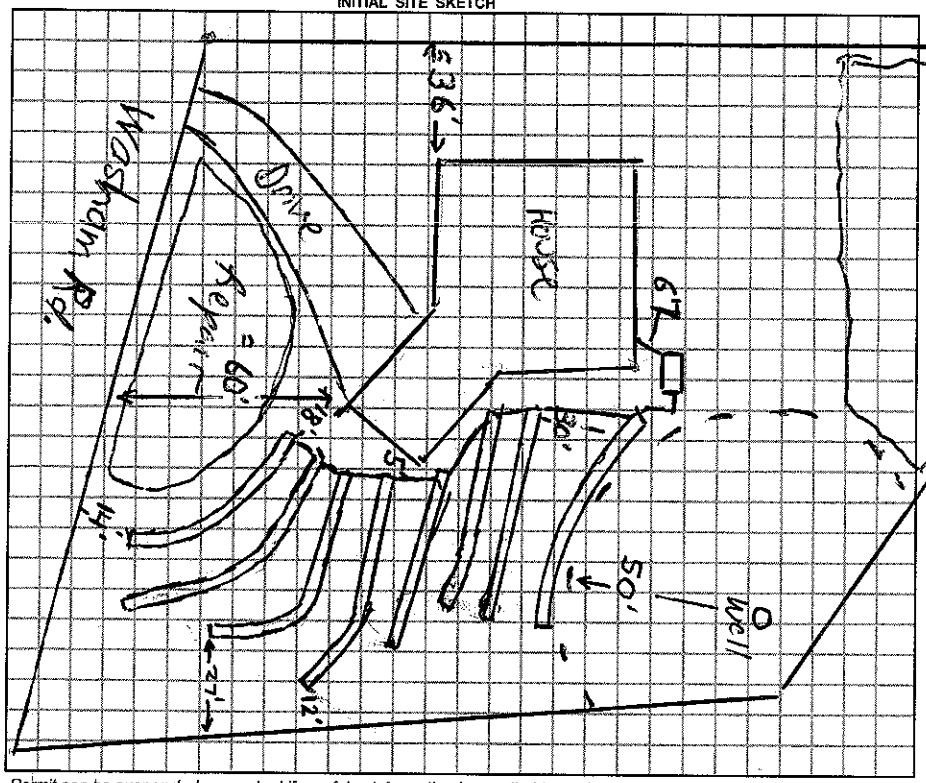

Comments / Conditions

AS BUILT SKETCH

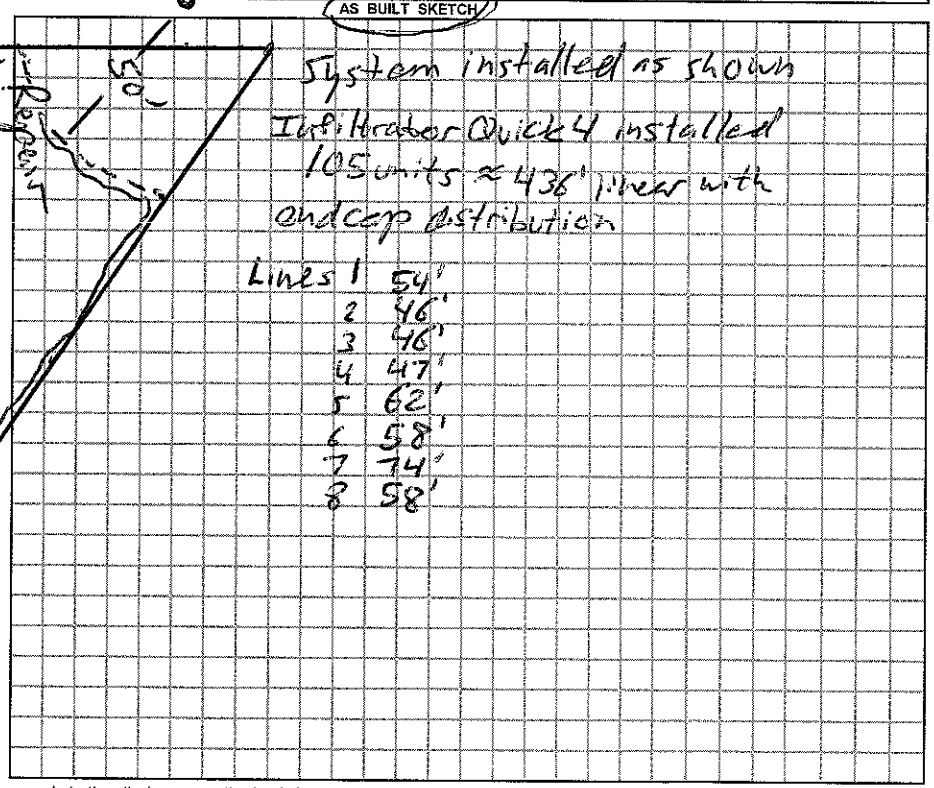

Permit can be suspended or revoked if any false information is supplied toward securing the permit / any unauthorized changes are made to the site / any unauthorized changes are made in the installation of the system.

☐ *IMPROVEMENT PERMIT w / plat valid without expiration.* ☐ *IMPROVEMENT PERMIT w / site plan valid for 60 mos.* ☐ *AUTHORIZATION TO CONSTRUCT valid for period equal to IMPROVEMENT PERMIT-not to exceed 60 mo.*

Owner / Applicant Signature: _____ Date _____

Improvement Permit by: _____ Date _____

Authorzation to Construct by: _____ Date _____

YOU SHOULD CONTACT A LOCATOR SERVICE PRIOR TO ANY EXCAVATION.

Installed by: Specialty Septic

Operation Permit by: Anthony Cohen Jr. R.S. Date: 4/8/09

Existing System Inspected by: _____ Date: _____

WHITE COPY Environmental Health YELLOW COPY (Final) Owner / Applicant PINK COPY (Initial) Owner / Applicant

Redraw case 9000

IREDELL COUNTY HEALTH DEPARTMENT

STATESVILLE 704-878-5305 MOORESVILLE 704-664-5281

IMPROVEMENT PERMIT / AUTHORIZATION TO CONSTRUCT / OPERATION PERMIT / EXISTING SYSTEM INSPECTION

PERMIT # 146161 PIN # 4624346120.000 DATE 1/20/09

OWNER or APPLICANT Gary & Ginny Kane PHONE: Business 631-882-3778 Home: 704 662-6400

OWNER or APPLICANT ADDRESS 5 Hathorn Dr Port Jefferson Station NY 11776

LOCATION / DIRECTIONS Brawley Sch Rd. Th 2nd Washam Rd. entrance 7th lot on Left

SUBDIVISION Washam Point BLOCK / SECTION LOT # 10 LOT AREA .942ac DESIGN FLOW 480 L.T.A.R. .275

Septic Tank 1000 Gallons: STB Date

Pump Tank Gallons: P T Date

Pump Make Model Serial #

Nitrification Field No Fields 1 No Lines 6 Linear Feet 432'

Trench Width 36" Max. Trench Bottom Depth* 22"* Gravel Depth N/A

☑ New System ☐ Repair ☐ Expansion System Type I II III IV V VI

System Description: Gravity 25% Reduction

Repair System Description: Grav/Pump 25% Reduction

Maintenance Agreement Required ☐ YES ☑ NO

☑ GRAVITY ☐ PRESSURE

☑ Residence No. Bedrooms 4

☐ Business No. Persons

☐ Other No. Employees

☐ Slab ☑ Crawl Space

☐ Basement w/plumbing ☐ Basement w/o plumbing

Water Supply: ☑ Private ☐ Public ☐ Community


Comments / Conditions Use approved method of serial Distribution or a D box w/ Flow levelers and/or a flow splitter

* Lines start at driveway, may go in to 11' = 4" deep not to Exceed 22" Max depth.


Scale 1"=50'

Comments / Conditions Garage is approx. 74' from Washam Rd.

INITIAL SITE SKETCH

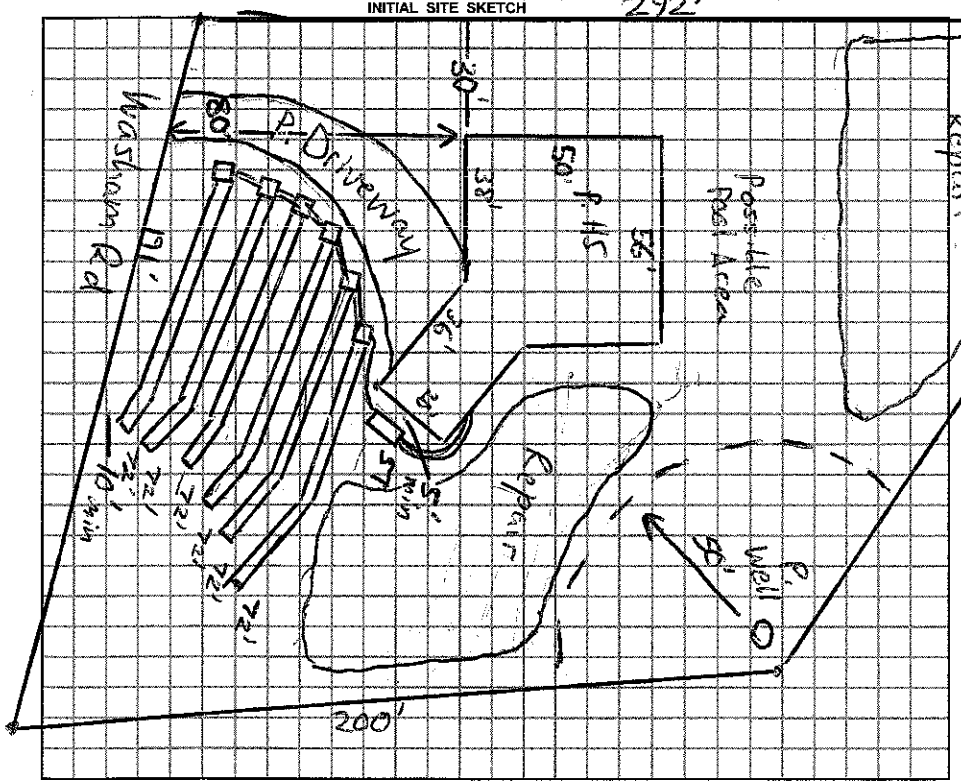

AS BUILT SKETCH 1/28/09

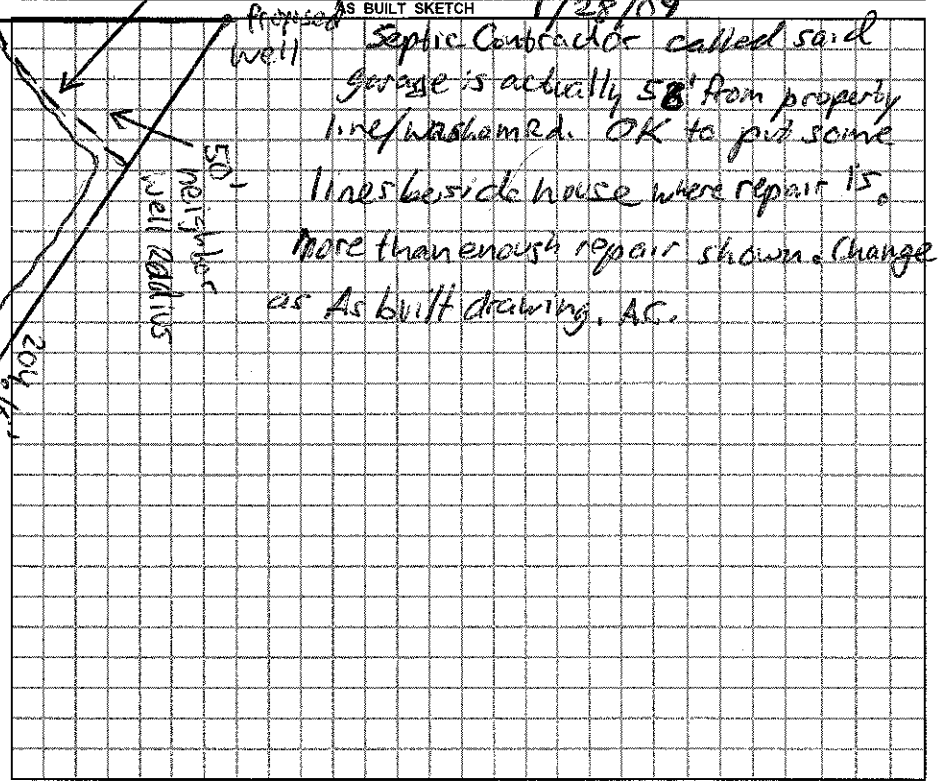

Permit can be suspended or revoked if any false information is supplied toward securing the permit / any unauthorized changes are made to the site / any unauthorized changes are made in the installation of the system.

☐ *IMPROVEMENT PERMIT w / plat valid without expiration.* ☑ *IMPROVEMENT PERMIT w / site plan valid for 60 mos.* ☑ *AUTHORIZATION TO CONSTRUCT valid for period equal to IMPROVEMENT PERMIT-not to exceed 60 mo.*

Owner / Applicant Signature: Ginny Kane Date 1/20/09

Improvement Permit by: Anthony Cobey R.S. Date 1/20/09

Authorzation to Construct by: Anthony Cobey R.S. Date 1/20/09

YOU SHOULD CONTACT A LOCATOR SERVICE PRIOR TO ANY EXCAVATION.

Installed by:

Operation Permit by: See As built Date:

Existing System Inspected by: Date:

WHITE COPY Environmental Health YELLOW COPY (Final) Owner / Applicant PINK COPY (Initial) Owner / Applicant