IREDELL COUNTY HEALTH DEPARTMENT

STATESVILLE 704-878-5305 MOORESVILLE 704-664-5281

IMPROVEMENT PERMIT / AUTHORIZATION TO CONSTRUCT / OPERATION PERMIT / EXISTING SYSTEM INSPECTION

PERMIT# 095006 PIN# 4624351225 ABJ DATE 3/21/2001

OWNER OR CONTRACTOR David & Rebecca Beam PHONE: Business 664-4353 Home (704) 664-4353

ADDRESS 8029 Island View Ct Denver, NC 28037

LOCATION Brawley School Rd to Washam on left

SUBDIVISION Meek Neck BLOCK / SECTION 6 LOT 486 LOT AREA 1.21 Acre SITE CLASS. PS DESIGN FLOW 360gpd L.T.A.R.

LOT

Septic Tank: 1500gal Gallons; STB Date

Pump Tank: (Existing) Gallons; PT Date

Pump Make: Model Serial No.

Nitrification Field: No Fields 1 Square Feet 1200 Linear Feet 400 (Existing)

No Lines 4 Trench Width 36 Max Trench Bottom Depth (Existing)

☐ New System ☐ Repair System Type: I (II) III, IV, V, VI

System Description: Existing Gravity - Conventional

Repair System Description:

Maintenance Agreement Required: ☐ Yes ☒ No

Gravel Depth 12"

☒ House/Mod. Home No. Bedrooms 3

☐ Mobile Home No. Bathrooms 3

☐ Business No. Employees

☐ Other


☐ Slab ☒ Crawl Space ☐ Basement w/plumbing ☐ Basement wo/plumbing

Water Supply: ☒ Individual ☐ Public ☐ Community

Comments:/Conditions: Existing Septic System appears to be functioning okay at time of inspection, no problems noticed.

Comments:/Conditions: Keep new home at least 5' from Existing Septic System

INITIAL SITE SKETCH

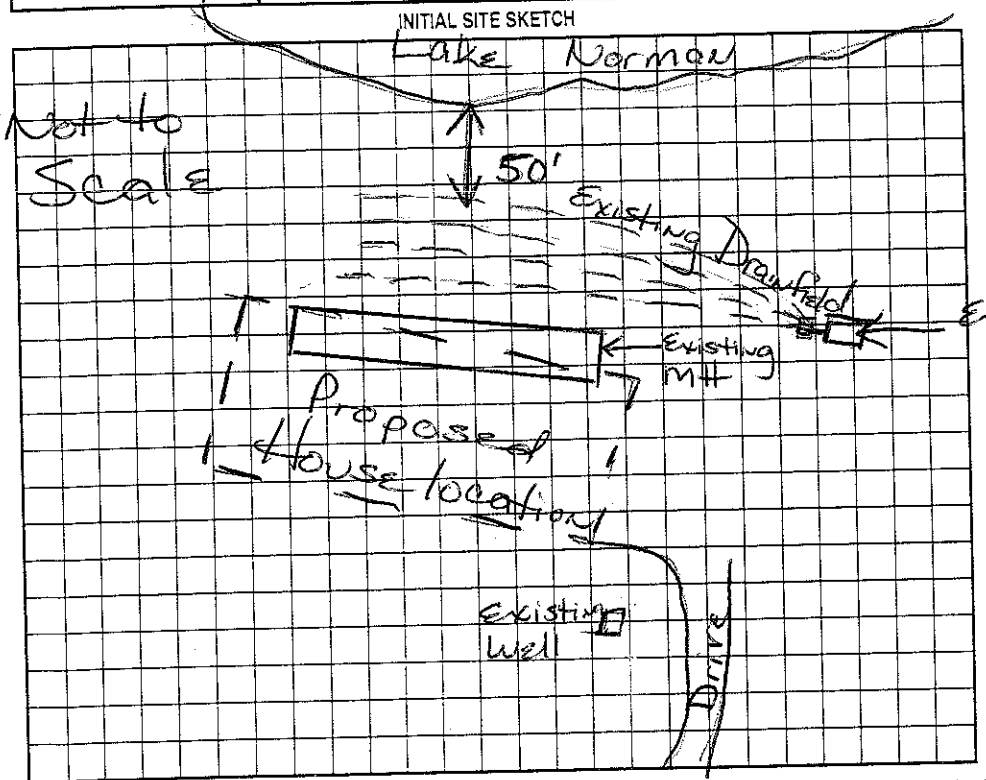

* Not to Scale

AS BUILT SKETCH

System installed 1983 (Former Meek Neck permit attached)

Permit can be suspended or revoked if any false information is supplied toward securing the permit/any unauthorized changes are made to the site/any unauthorized changes are made in the installation of the system. Improvement Permit with plat valid without expiration. Improvement Permit with site plan valid for sixty months. Authorization to Construct is valid for a period equal to that of Improvement Permit – not to exceed sixty months.

Signed: X ABJ date

Improvement Permit by: Maina M. Watson RS date 3/21/2001

Authorization to Construct by: ABJ date

Installed by:

Operation Permit by: date

Existing System Inspection by: Maina M. Watson RS date 3/24/2001

HEALTH DEPT. COPY: WHITE OWNER COPY (FINAL): YELLOW OWNER COPY (INITIAL): PINK