IREDELL COUNTY HEALTH DEPARTMENT

STATESVILLE 704-878-5305 MOORESVILLE 704-664-5281

4.00

IMPROVEMENT PERMIT / AUTHORIZATION TO CONSTRUCT / OPERATION PERMIT / EXISTING SYSTEM INSPECTION

PERMIT# Repair PIN# 4624-35-2152 DATE 8/13/04

OWNER OR CONTRACTOR Mark + Marilyn Roman PHONE: Business _____ Home 704-662-6008

ADDRESS 115 Washam Rd Mooresville NC 28117

LOCATION BSR TL 1st Washam, 2nd on Lt #115

SUBDIVISION Icit T BLOCK / SECTION 6 LOT 485 LOT AREA — SITE CLASS PS DESIGN FLOW 360 L.T.A.R. —

Septic Tank: Existing Gallons; STB 794 Date 9-15-04
Pump Tank: 1000 Gallons; PT 27 Date 9-15-04
Pump Make: LittleGiant Model 9EH Serial No. _____
Nitrification Field; No Fields 1 Square Feet 900 Linear Feet 300
No Lines 3@100' Trench Width 36" Max Trench Bottom Depth 36" Gravel Depth —

☒ New System ☐ Repair System Type: I, II, III, IV, V, VI
System Description: PM 25% Reduction
Repair System Description: _____
Maintenance Agreement Required: ☐ Yes ☒ No


☒ House/Mod. Home No. Bedrooms 3
☐ Mobile Home No. Bathrooms ____
☐ Business No. Employees ____
☐ Other _____
☒ Slab ☒ Crawl Space ☐ Basement w/plumbing ☐ Basement wo/plumbing

Water Supply:
☒ Individual
☐ Public
☐ Community


Comments/Conditions: Not To Scale

Comments/Conditions: Checked tanks & lines 10/19/04 & pressure
Elect & alarm 4/24/09

INITIAL SITE SKETCH

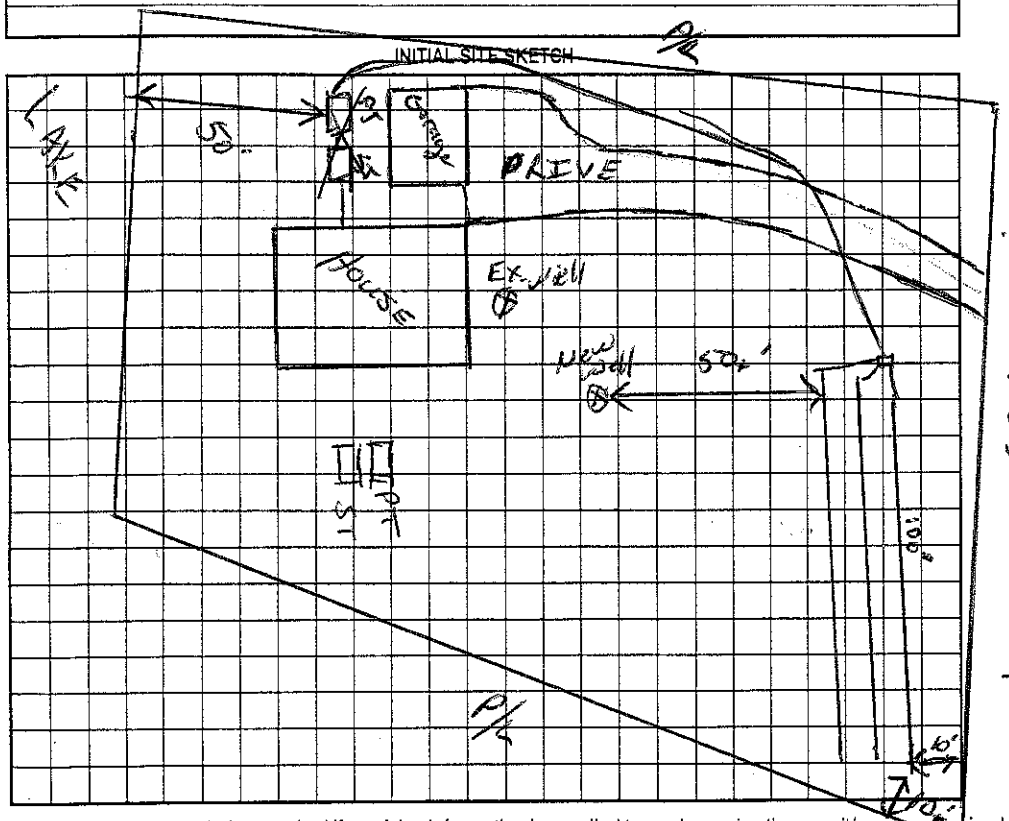

AS BUILT SKETCH

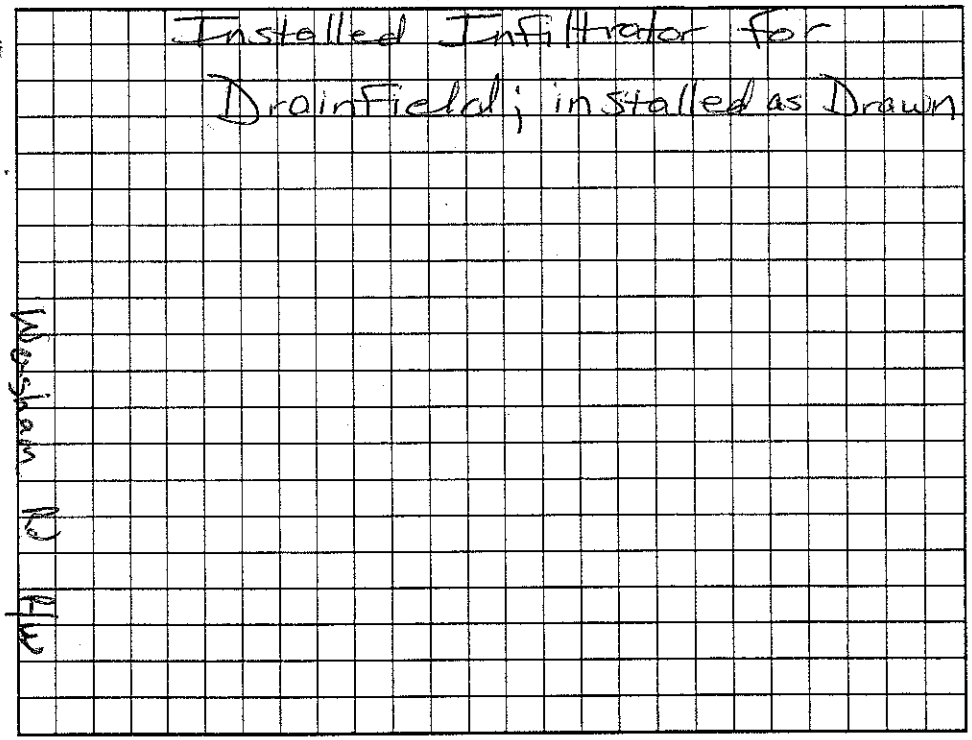

Permit can be suspended or revoked if any false information is supplied toward securing the permit/any unauthorized changes are made to the site/any unauthorized changes are made in the installation of the system. Improvement Permit with plat valid without expiration. Improvement Permit with site plan valid for sixty months. Authorization to Construct is valid for a period equal to that of Improvement Permit – not to exceed sixty months.

Signed: Marilyn Roman date 8-30-04 Installed by: Richard Abernathy

Improvement Permit by: _____ LS date 8/13/04 Operation Permit by: _____ date 4/24/09

Authorization to Construct by: _____ LS date 8/13/04 Existing System Inspection by: _____ date _____

HEALTH DEPT. COPY: WHITE OWNER COPY (FINAL): YELLOW OWNER COPY (INITIAL): PINK