IREDELL COUNTY HEALTH DEPARTMENT

STATESVILLE 704-878-5305 MOORESVILLE 704-664-5281

IMPROVEMENT PERMIT / AUTHORIZATION TO CONSTRUCT / OPERATION PERMIT / EXISTING SYSTEM INSPECT

PERMIT# 125115 PIN# 4624362585.033 4624-35-7815 DATE 4/14/05

OWNER OR CONTRACTOR POINT ON NORMAN / Simonini PHONE: Business 660-1185 Home

ADDRESS 2214 BRAWLEY SCHOOL RD - MOORESVILLE NC 28115

LOCATION BRAWLEY SCHOOL - I L HOPPINTON DR - ON RT - LOT ON CORNER OF YALE IN CENTER OF LOOP

SUBDIVISION POINT BLOCK / SECTION 10 LOT 1033 LOT AREA 30,096 SITE CLASS. RS DESIGN FLOW 480GPD L.T.A.R. .30/1.0

Septic Tank: 1000 Gallons; STB 338 Date 11/12/05

Pump Tank: 1000 Gallons; PT 283 Date 11/12/05

Pump Make: Myers Model P102 Serial No.

Nitrification Field: No. Fields 1 Square Feet 1200 Linear Feet 400

No Lines 5@80' Trench Width 36" Max Trench Bottom Depth 36" Gravel Depth N/A

☑ New System ☐ Repair System Type: I, II, III, IV, V, VI

System Description: Pump 35% Reduction

Repair System Description: CP Panel

Maintenance Agreement Required: ☐ Yes ☑ No

☑ House/Mod. Home No. Bedrooms 4

☐ Mobile Home No. Bathrooms 4

☐ Business No. Employees

☐ Other


☐ Slab ☑ Crawl Space ☐ Basement w/plumbing ☐ Basement wo/plumbing

Water Supply: ☐ Individual ☐ Public ☑ Community


Comments:/Conditions: SEE PLAT FOR SUPPLY LINE LOCATIONS AND EASEMENT.

Comments:/Conditions: Reviewed plans; in Compliance with original permit Lines checked 9/13/05 EJ Hay Tanks, pressure, float & alarm 1/20/06

INITIAL SITE SKETCH 1" = 50'

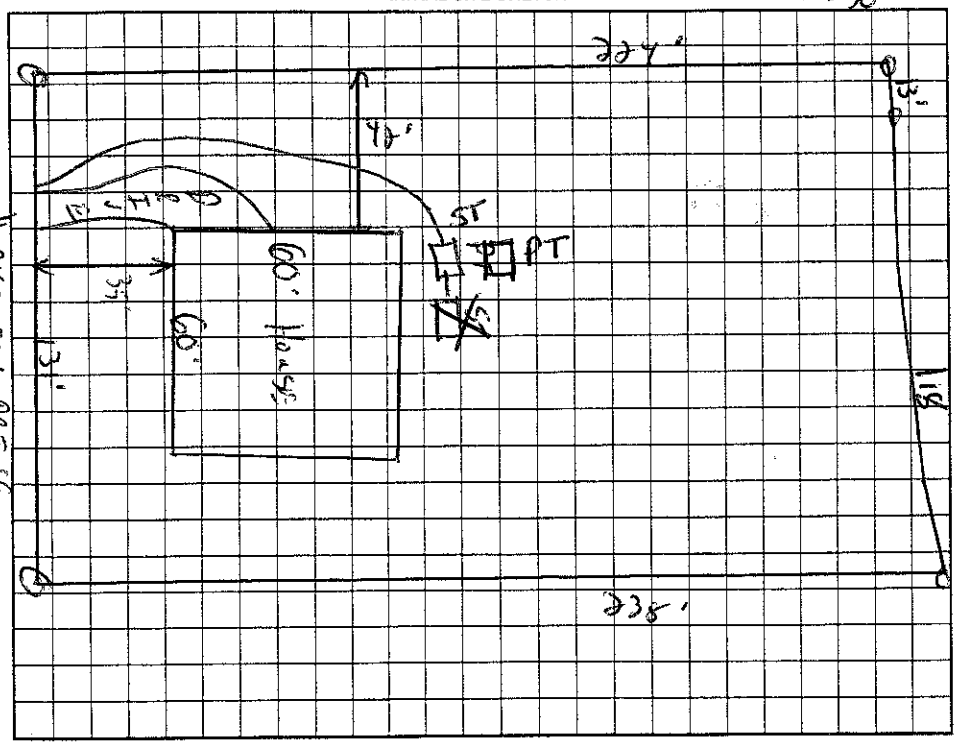

AS BUILT SKETCH 1" = 50'

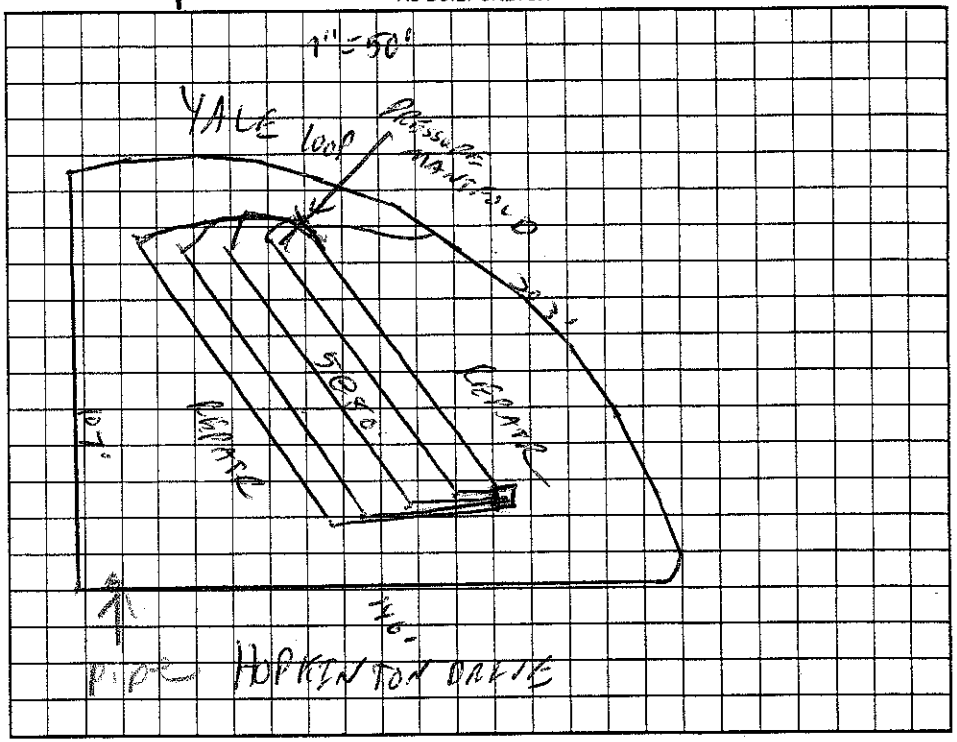

Permit can be suspended or revoked if any false information is supplied toward securing the permit/any unauthorized changes are made to the site/any unauthorized changes are made in the installation of the system. Improvement Permit with plat valid without expiration. Improvement Permit with site plan valid for sixty months. Authorization to Construct is valid for a period equal to that of Improvement Permit – not to exceed sixty months.

Signed: Kathleen Carver date 4/15/05

Improvement Permit by: [signature] RS date 4/14/05

Authorization to Construct by: Marvin H. Dotson RS date 6/3/05

Installed by: R & T

Operation Permit by: Marvin H. Dotson RS date 1/20/06

Existing System Inspection by: date

HEALTH DEPT. COPY: WHITE OWNER COPY (FINAL): YELLOW OWNER COPY (INITIAL): PINK