IREDELL COUNTY HEALTH DEPARTMENT

STATESVILLE 704-878-5305 MOORESVILLE 704-664-5281

IMPROVEMENT PERMIT / AUTHORIZATION TO CONSTRUCT / OPERATION PERMIT / EXISTING SYSTEM INSPECTION

PERMIT# 125109 PIN# ~~4624358585~~ 4624-35-8724 DATE 9-18-07

OWNER OR APPLICANT Simonini Builders PHONE: Business 358-9940 Home 719-0182

ADDRESS 1910 South Blvd Charlotte, NC 28203

LOCATION Brawley School Rd TL Hopkinton on Right near end

SUBDIVISION Pointy BLOCK / SECTION 10 LOT 1032 LOT AREA 30,076 Ft2 SITE CLASS. PS DESIGN FLOW 480 gpd L.T.A.R. @ 3

Pump @ 4HP

Septic Tank: 1500 Gallons; STB 338 Date 8-20-07

Pump Tank: 1000 Gallons; PT 283 Date 9-22-07

Pump Make: Zoeller Model E140-D Serial No

Nitrification Field: No Fields 1 Square Feet 810 Linear Feet 270'

No Lines 4 Trench Width ~~A~~ See Note Max Trench Bottom Depth 36" Gravel Depth N/A ☐ Gravity ☒ Pressure

☒ New System ☐ Repair ☐ Expansion System Type: I II III IV V VI

System Description: Pump-UP-Panel Block

Repair System Description: Same

Maintenance Agreement Required: ☒ Yes ☐ No

☒ House/Mod. Home ☐ Mobile Home ☐ Business ☐ Other

No. Bedrooms 4 No. Persons ___ No. Employees ___


Water Supply: ☐ Individual ☐ Public ☒ Community

☐ Slab ☒ Crawl Space ☐ Basement w/plumbing ☐ Basement wo/plumbing

Comments:/Conditions: Note: Use trench width as Specified in Crescent Communities Manuel

Comments:/Conditions: Okay to move tanks to side of house 10/16/07 Checked lines, installed as drawn 11/16/07 Checked tanks MD

INITIAL SITE SKETCH Scale 1:50

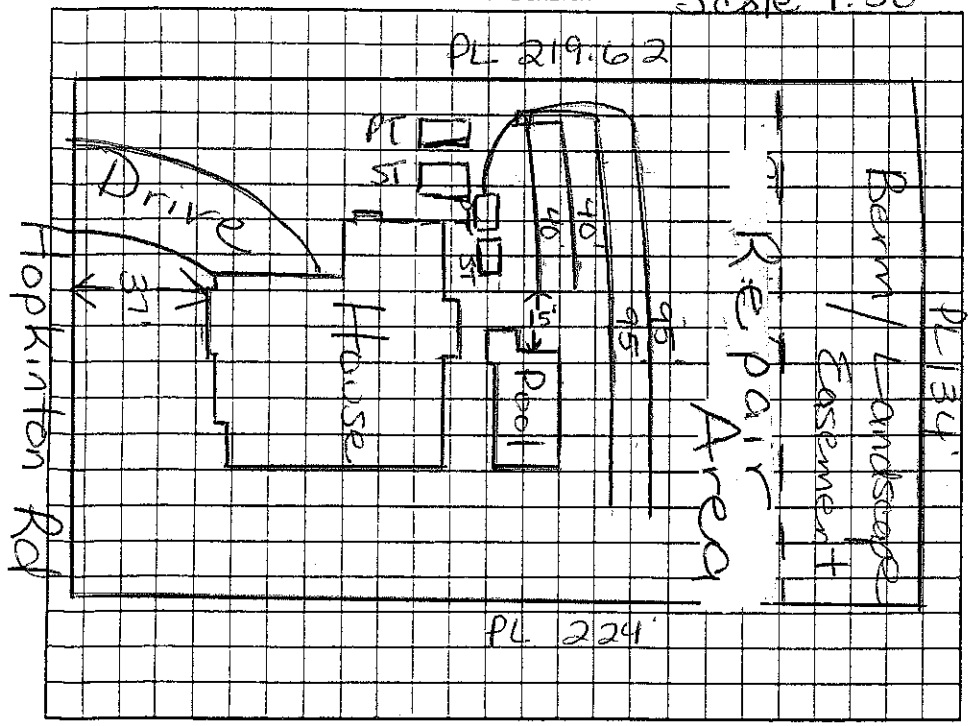

AS BUILT SKETCH

11/8/08 2H Pressure set

Permit can be suspended or revoked if any false information is supplied toward securing the permit/any unauthorized changes are made to the site/any unauthorized changes are made in the installation of the system. Improvement Permit with plat valid without expiration ☐ Improvement Permit with site plan valid for sixty months ☐ Authorization to Construct is valid for a period equal to that of Improvement Permit – not to exceed sixty months.

Signed: Cindy H Tech date 10-17-07

Improvement Permit by: Maria H Dotson RS date 9/18/07

Authorization to Construct by: Maria H Dotson RS date 9/18/07

Installed by: R&T RS

Operation Permit by: Maria H Dotson date 11/8/08

Existing System Inspection by: ___ date ___

HEALTH DEPT. COPY: WHITE OWNER COPY (FINAL): YELLOW OWNER COPY (INITIAL): PINK